

O.D.O.T. DISTRICT 2 SURVEY OFFICE (USE ONLY)

PERSONNEL _____

REFERENCE NO. _____

SHEET 33 OF 34

NOTES VAN DUSEN

DATE 1/30/98

ROUTE I-75

H.C. MOSER

WEATHER CLOUDY

COUNTY LUCAS

R.C. HUSS

TEMP. 35°

TOWNSHIP WASHINGTON

SECTION 4

DWG BY NIESE

PID _____

T 9 S R 8 E

TYPE MONUMENT IPIN

ON SURFACE - ~~BELOW~~ ON

OFFSET 0 PAVEMENT ON LT : RT

- TO - EDGE PAVEMENT


STATION: 539+46.31

HORZ.DATUM: _____

GEOID: _____


GRID: NORTHING: _____

EASTING: _____

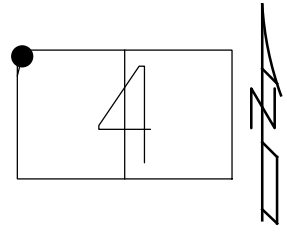

RECORD: S.T.
 IPIN IN CONC WALL
 ORIGINAL POSITION OF
 CONSULTANT'S "+" CUT
 PRE-CONST
 N: 53851.54
 E: 40040.51
 1/30/98, VAN DUSEN

DIST. IPIN-1/4" D.H.= 0.25'

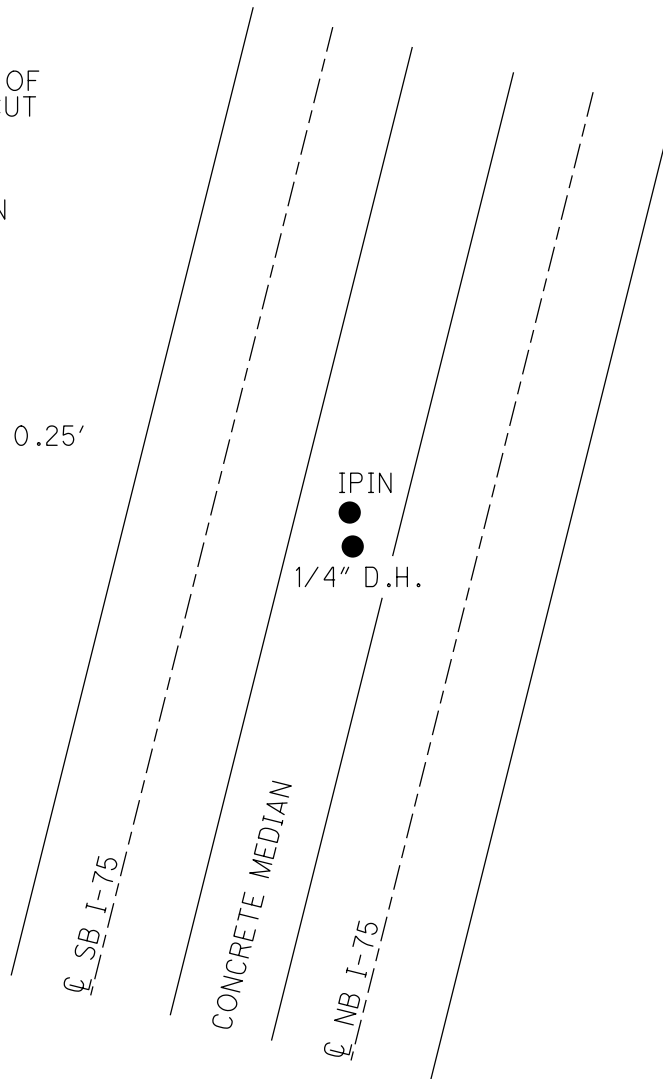

PERSONNEL	TITLE	PERSONNEL	TITLE
VAN DUSEN			
MOSEY			
HUSS			

COUNTY LUCAS DATE 1-30-28
 S. R. I-75 WEATHER CLOUDY
 SEC. 7.83 TEMP. +35°F

DESCRIPTION CONFIRMATION & LOCATION OF MONUMENTS JOB NO. 023350

LEFT CENTER LINE RIGHT

