

O.D.O.T. DISTRICT 2 SURVEY OFFICE (USE ONLY)

PERSONNEL

REFERENCE NO. _____

SHEET 34 OF 34

NOTES VAN DUSEN

DATE 1/30/98

ROUTE I-75

H.C. MOSER

WEATHER CLOUDY

COUNTY LUCAS

R.C. HUSS

TEMP. 35°

TOWNSHIP WASHINGTON

DWG BY NIESE PID _____

SECTION 4

T 9 S R 8 E


TYPE MONUMENT IPIN

ON SURFACE - ~~BELOW~~ ON

OFFSET Q PAVEMENT ON LT : RT

- TO - EDGE PAVEMENT

STATION: 540+82.21

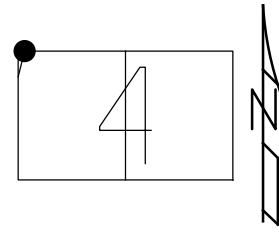

HORZ.DATUM: _____

GEOID: _____


GRID: NORTHING: _____

EASTING: _____

RECORD: P.O.T.
FD BOAT SPIKE
STA 540+81.76
1970 PLANS
IPIN IN CONC WALL
N: 53987.32
E: 40040.39
1/30/98, VAN DUSEN

MONROE COUNTY
LUCAS COUNTY

MICHIGAN
OHIO

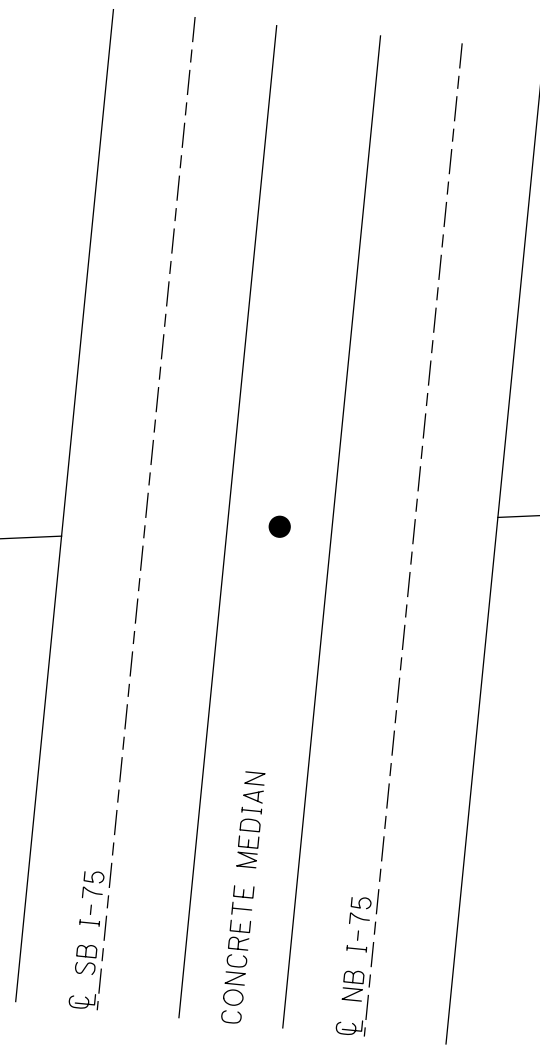

PERSONNEL	TITLE	PERSONNEL	TITLE
VAN DUSEN			
MOSEY			
HUSS			

COUNTY LUCAS DATE 1-30-28
 S. R. I-75 WEATHER CLOUDY
 SEC. 7.83 TEMP. +35°F

DESCRIPTION CONFIRMATION & LOCATION OF MONUMENTS JOB NO. 023350
 LEFT CENTER LINE RIGHT

