

ODC1 (D-2)

1983

1992 TWO-LANE RESURFACING PROGRAM

10/12

SHEET 1 OF 3

To B. Rosebrook 2-3-70

PRIORITY NO. 18 5 PART 2 OF 3 SECTION 10.65

COUNTY Lucas ROUTE SR 120

BEGIN LOG (SLM) 10.65 MEA 559 +0

END LOG (SLM) 11.660 TERMINIL Toledo Corp.

TOTAL LENGTH 1.01 MILES

MUNICIPALITY Ottawa Hills BEGIN LOG (SLM) END LOG (SLM)

MUNICIPALITY BEGIN LOG (SLM) END LOG (SLM)

PROPOSED WORK: 1 1/2" 404 SHOULDER Curb

PAVEMENT Check condition of catch basins, clearance of Rloverhead

EXISTING DATA: SEE ATTACHED SHEETS			
SLM	TO	PAV'T WIDTH	(type) SHLD WIDTH (type)
SLM	TO	PAV'T WIDTH	(type) SHLD WIDTH (type)
STRUCTURES: Asphalt Covered Deck			
STR. NO.	Loc 120 11.32	WIDTH 54'	LENGTH 128' PROP. WORK
STR. NO.	Sta 597+81	WIDTH	LENGTH PROP. WORK
STR. NO.		WIDTH	LENGTH PROP. WORK
STR. NO.		WIDTH	LENGTH PROP. WORK
RAILROAD CROSSING: NONE			
NAME	STATION	NO. TRACKS	LENGTH ALONG C L (no work) ft
NAME	STATION	NO. TRACKS	LENGTH ALONG C L ft
NAME	STATION	NO. TRACKS	LENGTH ALONG C L ft

white/red yellow/yellow

COUNTY Lucas ROUTE 3K 100 SECTION 1

L = Prop Pav't Depth(in.) x 10; W = Width @ Mouth; W-1 = Width @ Throat

L = Prop Pav't Depth(m.) x 10, W =

INTERSECTIONS								DRIVES					
STATION	SIDE	NAME OR NO.	L	W	W-1	ASPH	CONC	STATION	SIDE	W	ASPH	CONC	
561+28	Rt	Ramp to REYNOLDS	15'	46'	26'	X	SEE						
562+32	Rt	REYNOLDS Rd	15'	58'	48'	X							
563+41	Rt	Ramp From REYNOLDS	15'	82	185								
574+21	Rt	HASTY St.	15'	76'	30	X							
579+28	Rt	Redington Woods	15'	76'	38	X							
586+54	Rt	Exmoor	15'	123	48	X	SEE						
586+85	Lt	Enter to Metro Park	15'			X							
595+63	Rt	RIVER RIDGE Rd	15'	90'	40'	X							
606+27	Rt	VALLEY WOOD	15'	86'	35'	X							
615+52	Lt	COREY Rd	15'	136	74	X							

UTILITIES (Catch Basin, Manhole, Inlet, Watervale Box and Monument Box)

COUNTY Lucas

ROUTE

SECTION

R = Raise F = Feather

STATION	OUT Rt/Lt (FT)	CATCH BASIN	MAN- HOLE	INLET	W V BOX	MON BOX	CASTING		REMARKS
							R	F	
561+13	Lt CURB			X			X		
561+27	21 Rt Ctr PANT		X				X		
561+94	13' IN FROM Lt CURB		X				X		
562+03	12' "		X				X		
562+00	Rt CURB			X			X		
562+95	Rt CURB			X			X		
562+98	14' IN FROM Lt CURB		X				X		
563+13	Lt CURB						X		
565+27	12' IN FROM Lt CURB		X				X		
565+51	Lt CURB			X			X		
565+54	Rt CURB			X			X		
567+00	Rt CURB			X			X		
567+24	Lt CURB			X			X		
568+28	Rt CURB						X		
568+28	Lt CURB						X		
568+28	9' IN FROM Rt CURB		X				X		
569+25	8' IN FROM Lt CURB		X				X		
569+79	7' IN FROM Rt CURB		X				X		
569+79	Rt CURB			X			X		
569+79	Lt CURB			X			X		
569+79	4' IN FROM Lt CURB		X				X		
570+17	5' IN FROM Lt CURB		X				X		
571+40	4' IN FROM Lt CURB		X				X		
573+04	Rt CURB			X			X		
573+74	Lt CURB			X			X		
573+90	ctr PANT					X	X		
574+22	Lt CURB			X			X		
574+35	Rt CURB			X			X		
574+69	Lt CURB			X			X		
574+77	DR CURB			X			X		

UTILITIES (Catch Basin, Manhole, Inlet, Watervalue Box and Monument Box)

COUNTY LUCAS ROUTE S.R. 120 SECTION 1065
 R = Raise F = Feather

STATION	OUT Rt/Lt	CATCH BASIN	MAN- HOLE	INLET	W V BOX	MON BOX	CASTING		REMARKS
							R	F	
584+62	Rt Curb			X			X		
584+80	16' in from Lt Curb		X				X		
585+15	Lt Curb			X			X		
586+37	20' in Lt Curb		X				X		
587+49	14' in from Lt Curb		X				X		
587+49	Rt Curb			X			X		
587+63	Lt Curb			X			X		
588+16	16' in from Lt Curb		X				X		
588+96	15' in from Lt Curb		X				X		
589+79	Lt Curb			X			X		
589+79	Rt Curb			X			X		
593+07	4' in from Lt Curb		X				X		
595+79	7' in from Lt Curb		X				X		
596+60	5' in Lt Curb		X				X		
596+80	4' in Lt Curb		X				X		
596+85	Rt Curb			X			X		
596+85	Lt Curb			X			X		
597+39	Rt Curb			X			X		
597+39	Lt Curb			X			X		
599+84	5' in Lt Curb		X				X		
600+91	3' in Lt Curb		X				X		
601+93	Rt Curb			X			X		
601+93	Lt Curb			X			X		
602+62	Rt Curb			X			X		
602+62	Lt Curb			X			X		
603+06	Rt Curb			X			X		
603+10	Lt Curb			X			X		
606+25	Gr Pavt			X			X		

SHEET NO. _____

PERSONNEL TITLE PERSONNEL TITLE COUNTY DATE
 LOEHRKE Notes
 BARNHISEL Rod
 VAN DUSEN R
 LONG P
 COUNTY LUCAS DATE 1-9-92
 S. R. 120 WEATHER CLOUDY
 SEC. 10.74 TEMP. +35

DESCRIPTION Minimum Vert. Distance under bridges JOB NO. _____
 LEFT CENTER LINE RIGHT

DESCRIPTION	S.L.M.	Vert. Dist.	Date Checked	Remarks
S.R.				Check For 1992 RESURFACING
120	10.74	15.05'	1-9-92	Center of PAVT - IN CENTER of TURN Lane - UNDER EAST STEEL BEAM of R.R. BRIDGE

OHIO DEPARTMENT OF TRANSPORTATION

SHEET NO. P.M. 1

DATE 1-8-92

COUNTY LUCAS

TITLE

PERSONNEL

TITLE

PERSONNEL

WEATHER Cloudy

S. R. 120

TITLE

PERSONNEL

TITLE

PERSONNEL

TEMP. +35°

SEC. 10.65

TITLE

PERSONNEL

TITLE


PERSONNEL

JOB NO.

RIGHT

LOCATION
CENTER LINE

DESCRIPTION PAUT MARKINGS
LEFT

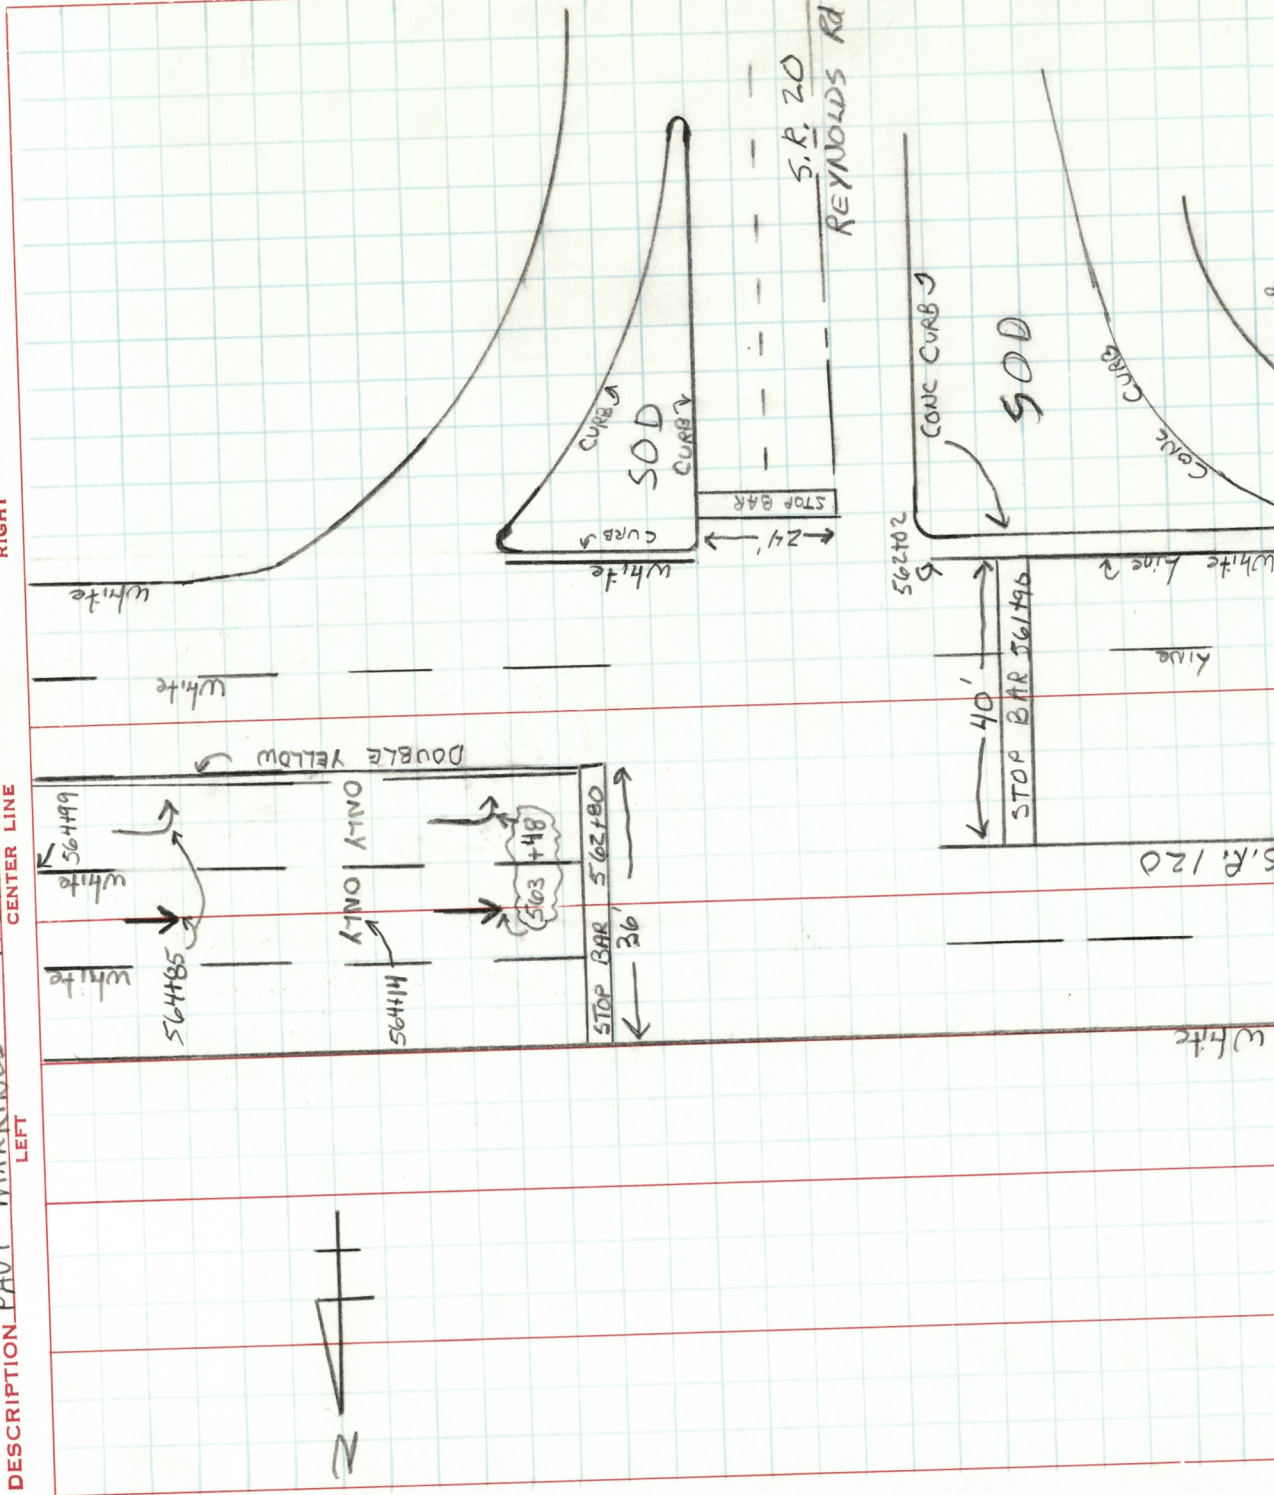

OHIO DEPARTMENT OF TRANSPORTATION

SHEET NO. PM 2

LD-5 Rev. 2-83

PERSONNEL LOEHRIKE TITLE _____ PERSONNEL LUCAS TITLE _____


PERSONNEL CURTIS TITLE _____ PERSONNEL _____ TITLE _____

DATE 1-8-92 WEATHER CLOUDY

S. R. 120 TEMP. +35°

SEC. 10.65 JOB NO. _____

DESCRIPTION PAVT. MARKINGS LOCATION REDINGTON WOODS RIGHT HASTY Rd.

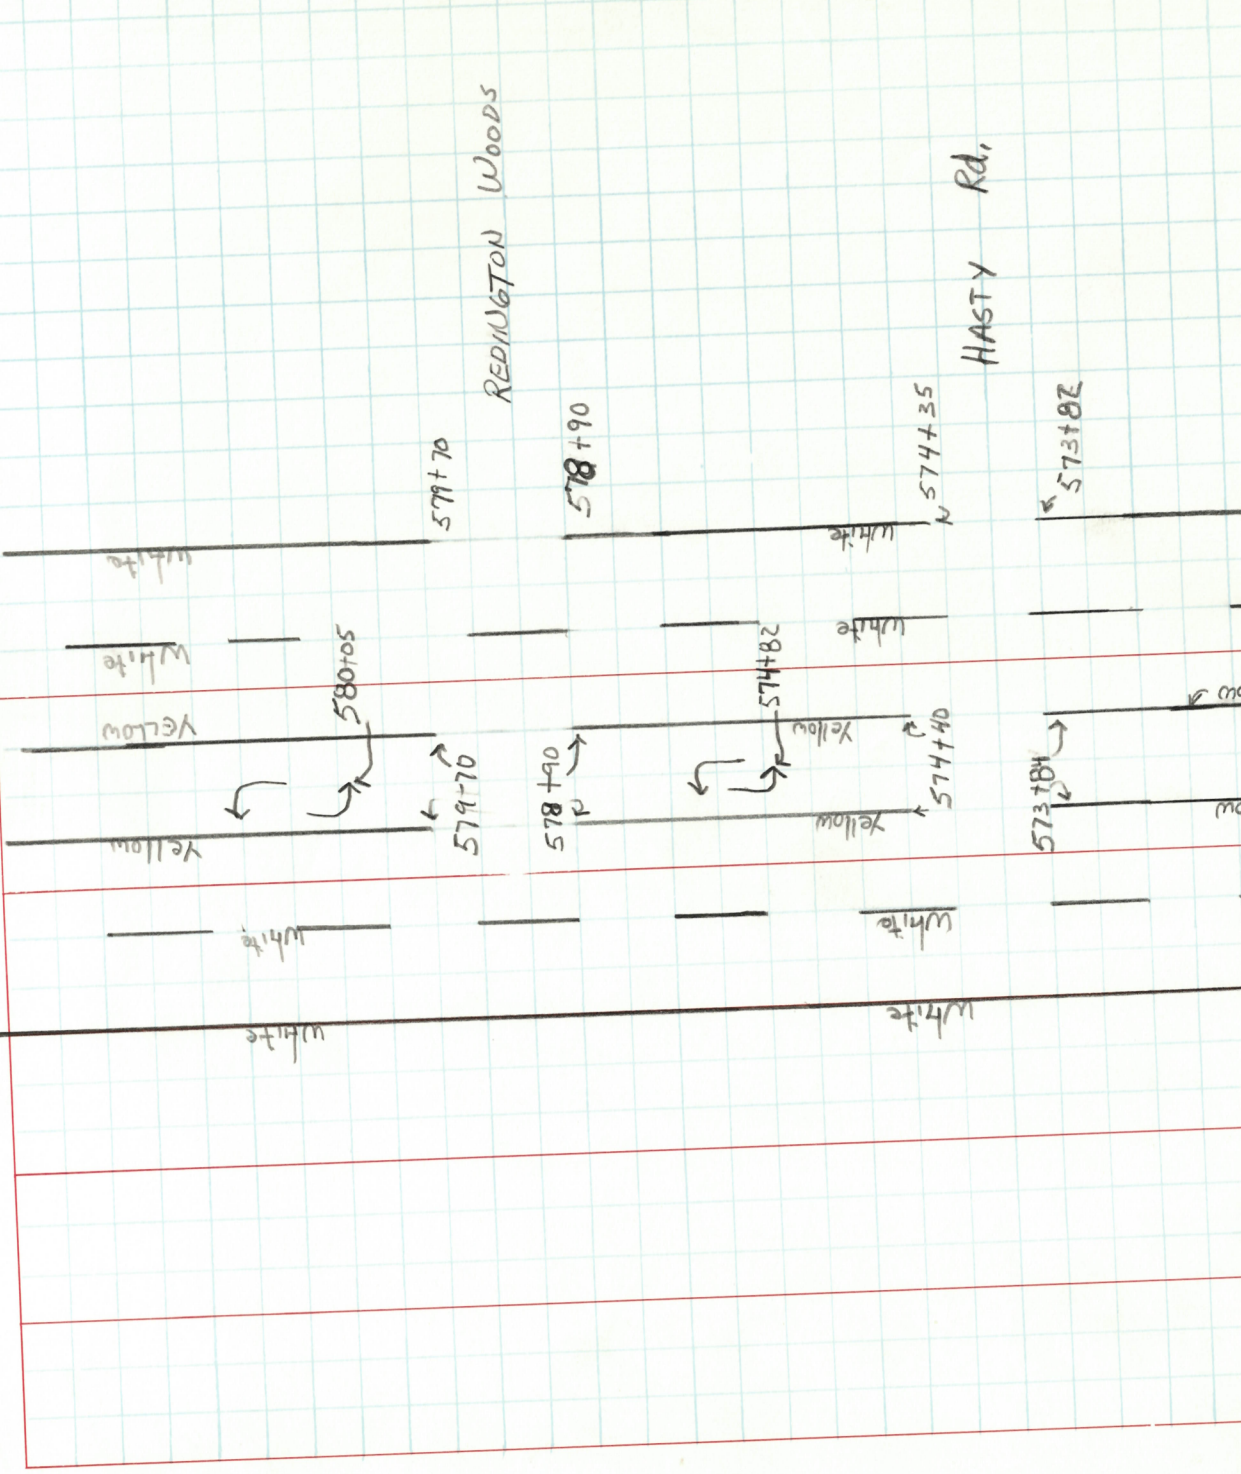

LD-5 Rev. 2-83

OHIO DEPARTMENT OF TRANSPORTATION

SHEET NO. PM.3

PERSONNEL	TITLE	PERSONNEL	TITLE	COUNTY	DATE
LOGHARKE				Lucas	1-21-92
CURTIS					
DODDS					


WEATHER

Deep Snow

TEMP.

+40

JOB NO.

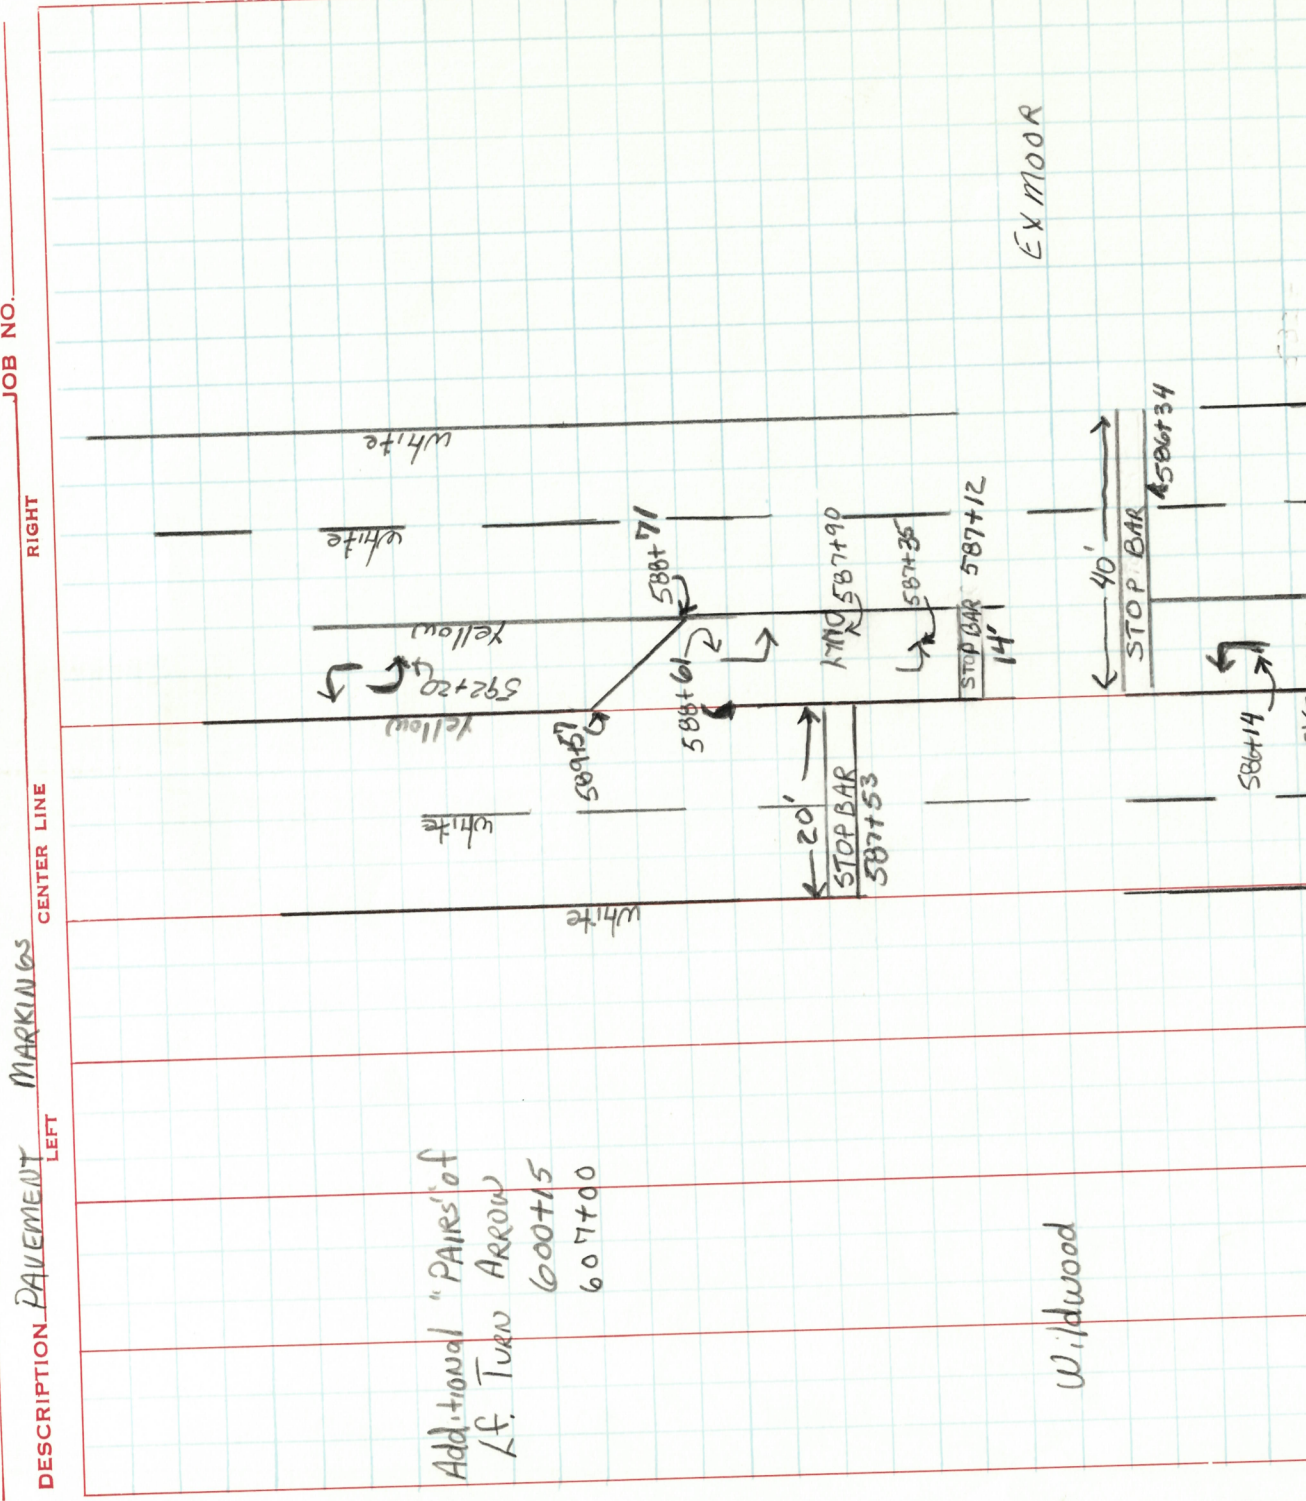

OHIO DEPARTMENT OF TRANSPORTATION

LD-5 Rev. 2-83

PERSONNEL

TITLE

PERSONNEL

TITLE

COUNTY Lucas

DATE: _____

1-13-92

LOEH RKE

CURTIS

Dodd's

PART

widths


DESCRIPTION-

CENTER LINE

RIGHT

10

JOB NO. _____

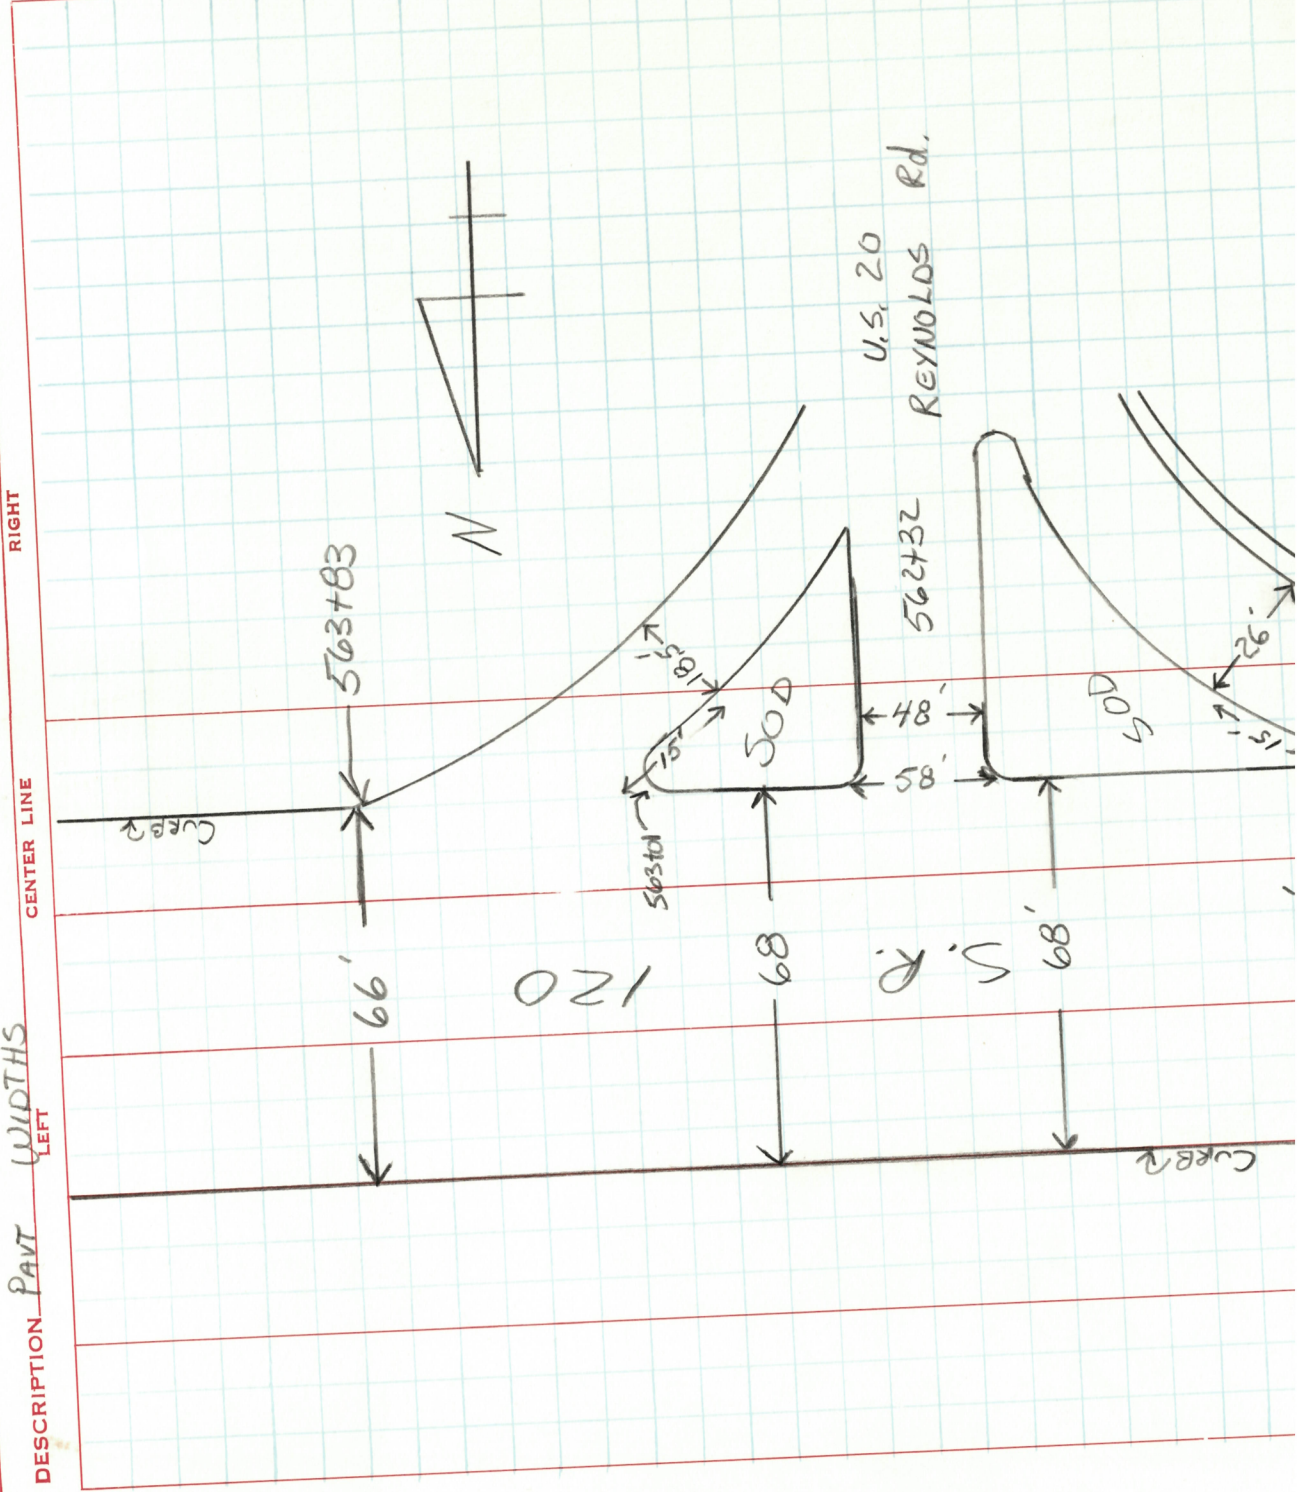


OHIO DEPARTMENT OF TRANSPORTATION

SHEET NO. PAVE WIDTH 3
 DATE 1-13-92
 COUNTY LUCAS
 WEATHER RAIN
 TEMP. +35
 JOB NO. _____

LD-5 Rev. 2-83

PERSONNEL LOEHEKE TITLE _____
 PERSONNEL CURTIS TITLE _____
 PERSONNEL DODDS TITLE _____
 S. R. 170
 SEC. 10.65

DESCRIPTION PAVEMENT WIDTHS
 LEFT CENTER LINE RIGHT

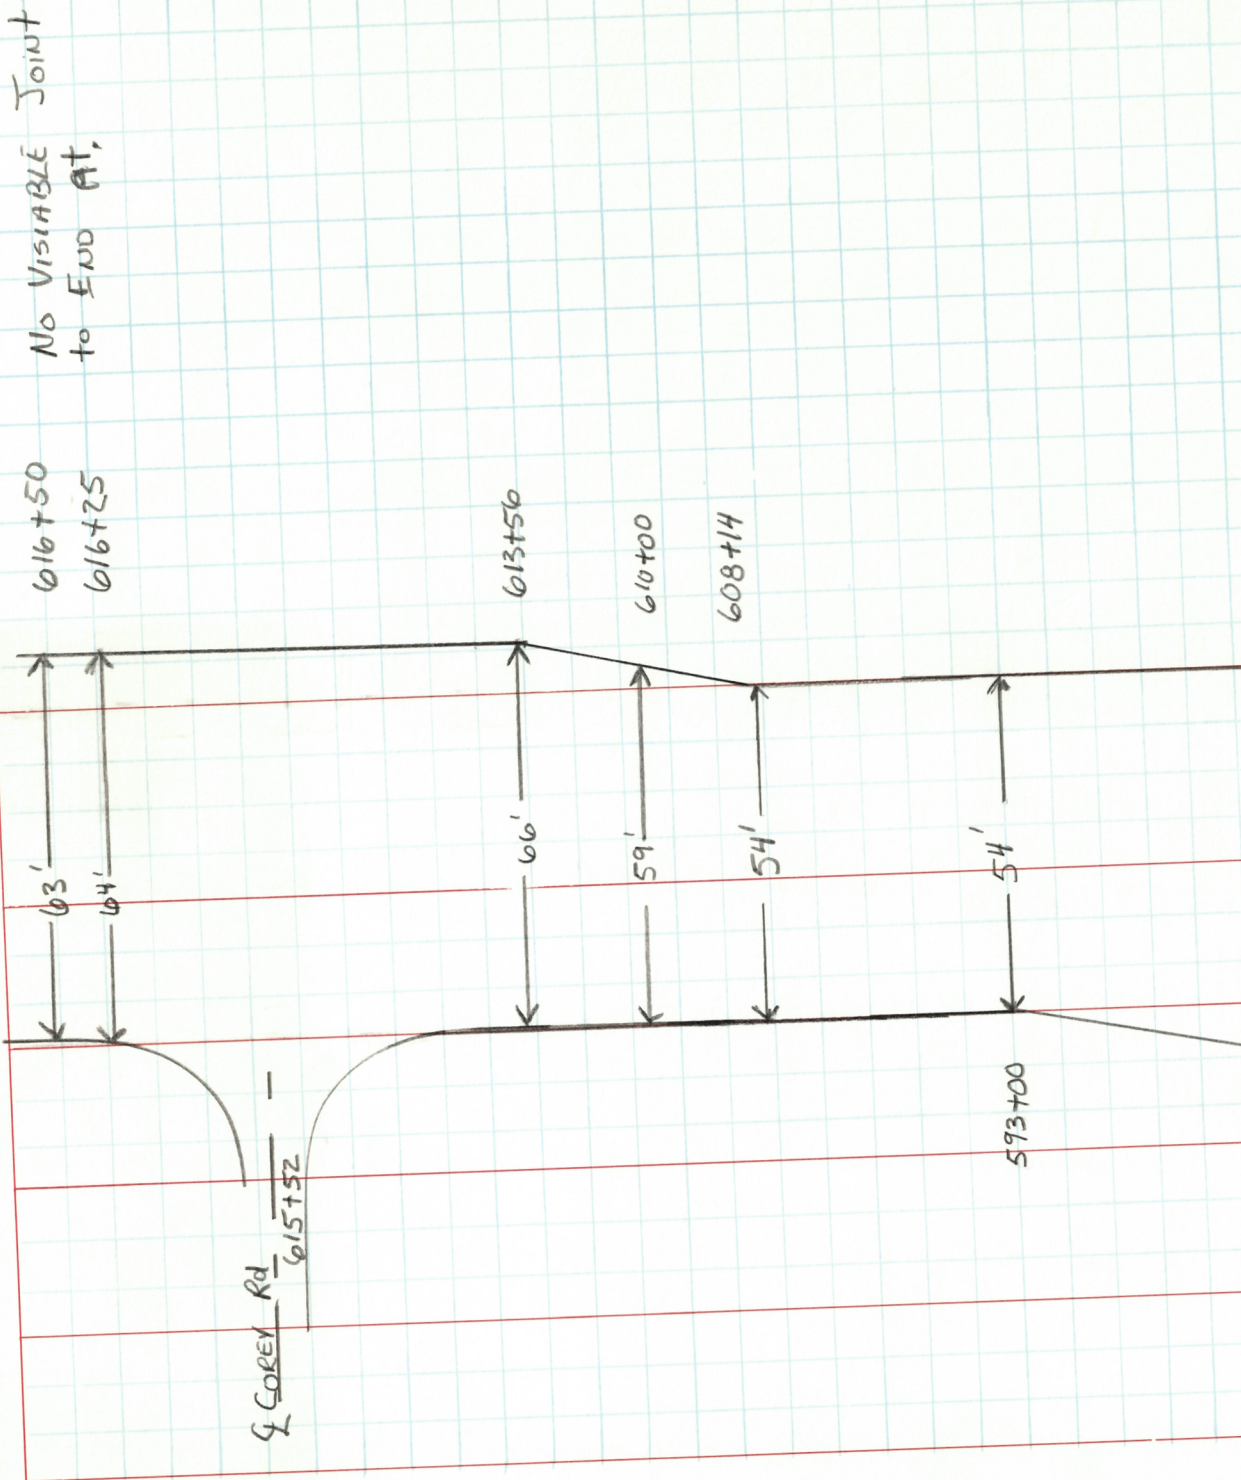

2-18-92

STEVE.

LUCAS 120 / CENTRAL AVE

Resurfacing Job.

Life Lite (RAISED PAVT. MARKERS)

Edge of PAVT - 188

C.L.