

O.D.O.T. DISTRICT 2 SURVEY OFFICE (USE ONLY)

PERSONNEL

REFERENCE NO. 9 A

SHEET 10 OF 11

NOTES CORDER DATE 7-14-97
 H.C. LOERKHE WEATHER HOT
 R.C. COX TEMP. 92°

ROUTE SR 120
 COUNTY LUCAS
 TOWNSHIP CITY OF TOLEDO
 SECTION 24
 T 9 S R 6 E

DWG BY JAMES PID 95717

TYPE MONUMENT MONBOX

ON SURFACE - ~~BELOW~~ ON

OFFSET Q PAVEMENT ON LT : RT

26.7' TO N EDGE PAVEMENT


STATION: 621+55.91

HORZ. DATUM: NAD83 2011


GEOID: NAVD88 2012A

GRID: NORTHING: 734522.754

EASTING: 1653915.664

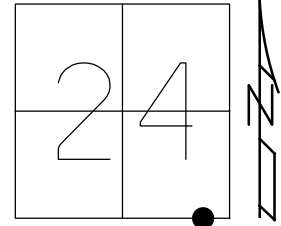

RECORD:
 FD MONBOX
 7-14-97, CL
 REFA9
 6-23-16, JFO

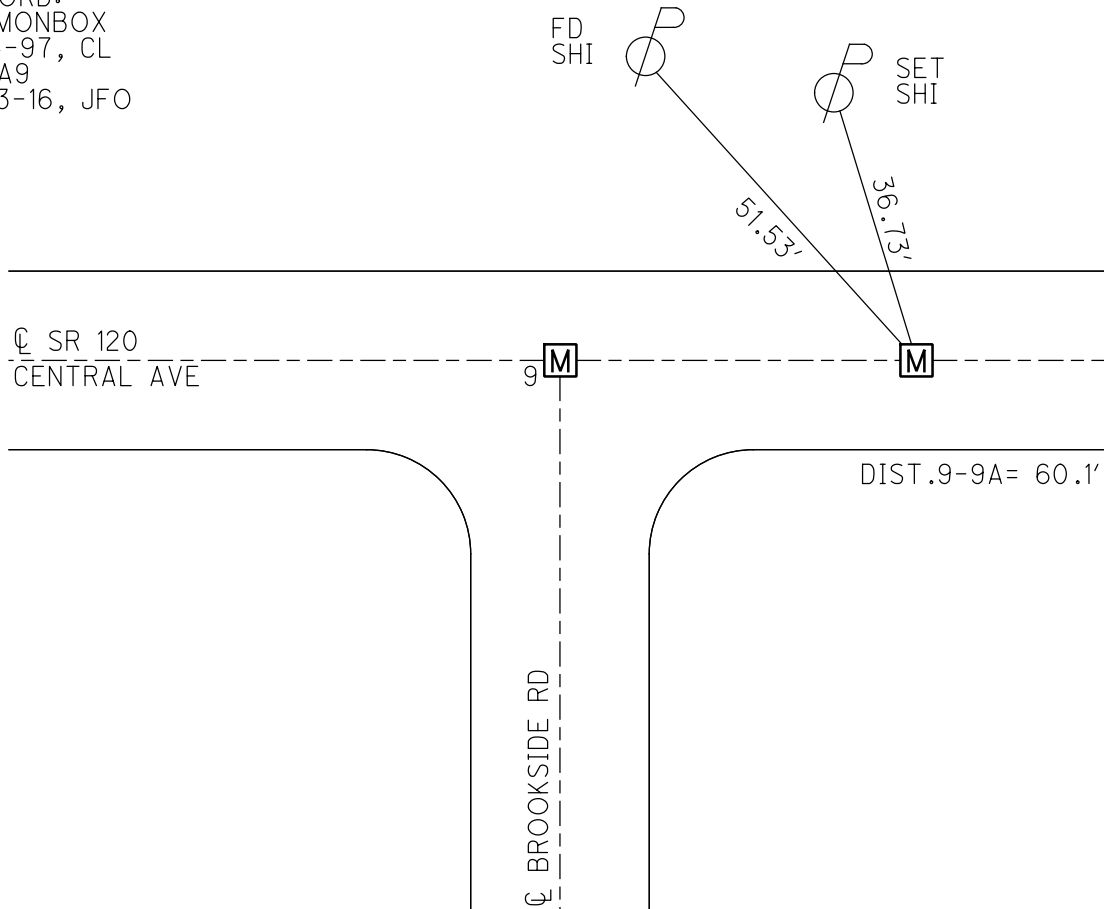


PERSONNEL TITLE PERSONNEL TITLE
 Tamsic _____
 Neuser _____
 Vanyo _____
 Granata _____


COUNTY Lucas DATE Sept 7, 1972
 S. R. U.S. 120 WEATHER _____
 SEC. _____ TEMP. _____

DESCRIPTION Central ave JOB NO. _____
 LEFT CENTER LINE RIGHT


9
 *

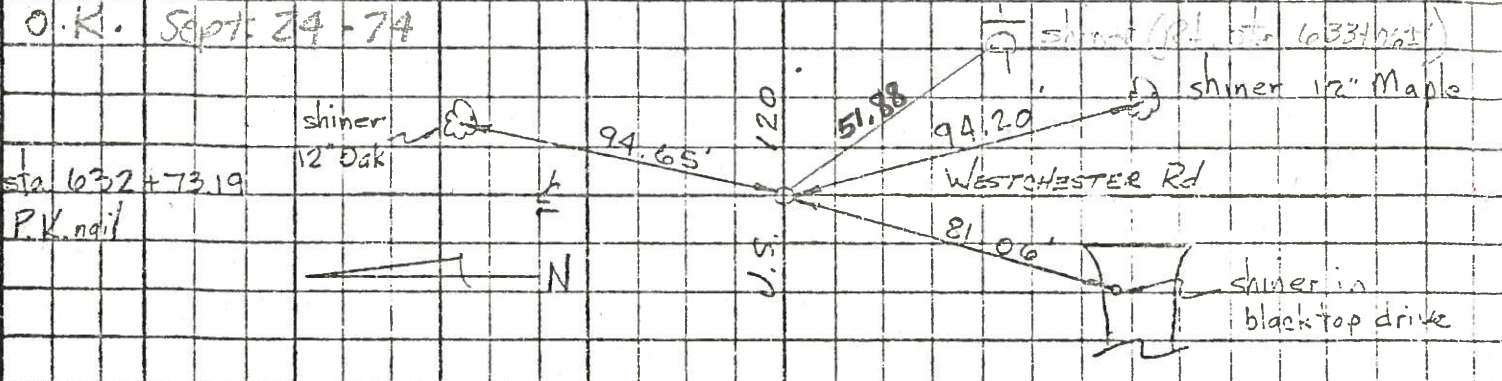

10
 *

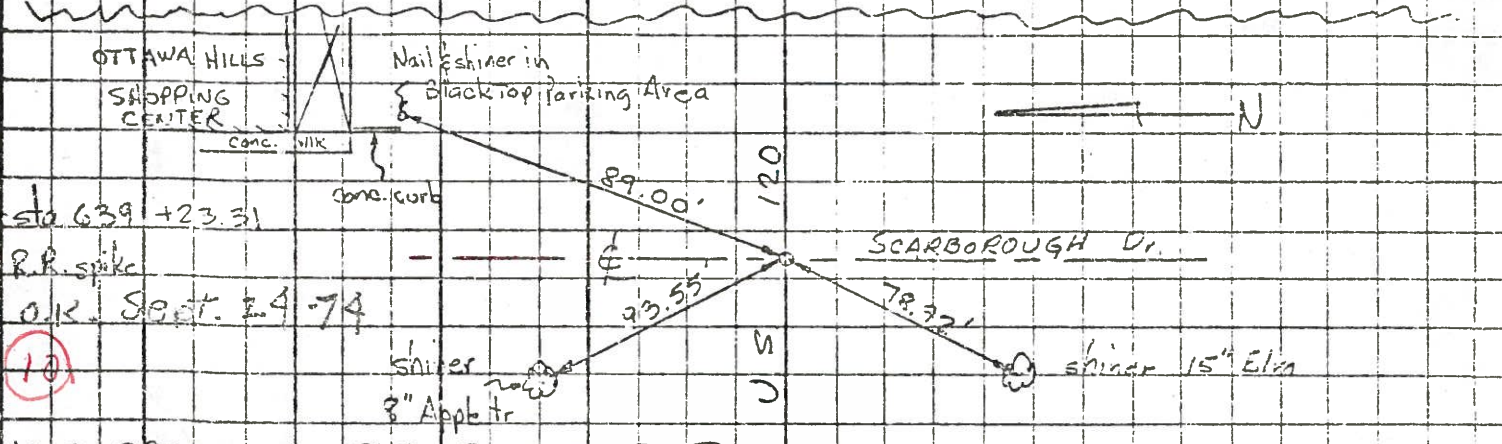

11
 *

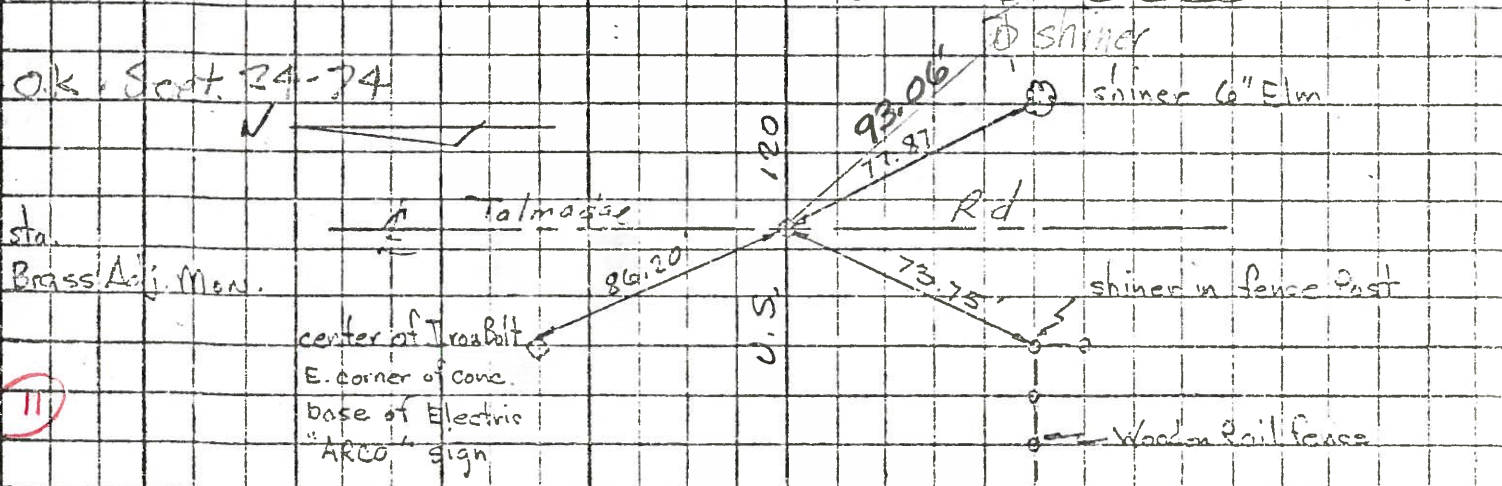

O.K. Sept. 74-74

PERSONNEL	TITLE	PERSONNEL	TITLE
W. DENNO			
D. CURTIS			
D. STEVENS			
R. BRAHMAN			

COUNTY LUCAS DATE 23 JULY 71

S. R. #120 WEATHER FAIR

SEC. Central Ave TEMP 80F

DESCRIPTION	REFERENCES TO CONTROL POINTS			JOB NO.
	LEFT	CENTER LINE	RIGHT	

Redone Sept. 7, 1972

Tomsic
Neuser
Jan yo
Granata

