

O.D.O.T. DISTRICT 2 SURVEY OFFICE (USE ONLY)

PERSONNEL

REFERENCE NO. 16 A

SHEET 7 OF 37

NOTES LOEHRKE

DATE 7/15/97

ROUTE US 120

H.C. LOEHRKE

WEATHER NICE

COUNTY LUCAS

R.C. HUSS

TEMP. 82°

TOWNSHIP CITY OF TOLEDO

SECTION 30

DWG BY NIESE PID _____

T 9 S R 7 E

TYPE MONUMENT MONBOX

ON SURFACE - ~~BELOW~~ ON


OFFSET ϕ PAVEMENT ON LT : RT

- TO - EDGE PAVEMENT

STATION: 662+99


HORZ. DATUM: _____ GEOID: _____

GRID: NORTHING: _____ EASTING: _____

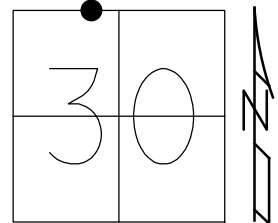

RECORD:
FD MONBOX
7/15/97, CL

CUT "+" ON TOP
CAP OF CURB INLET

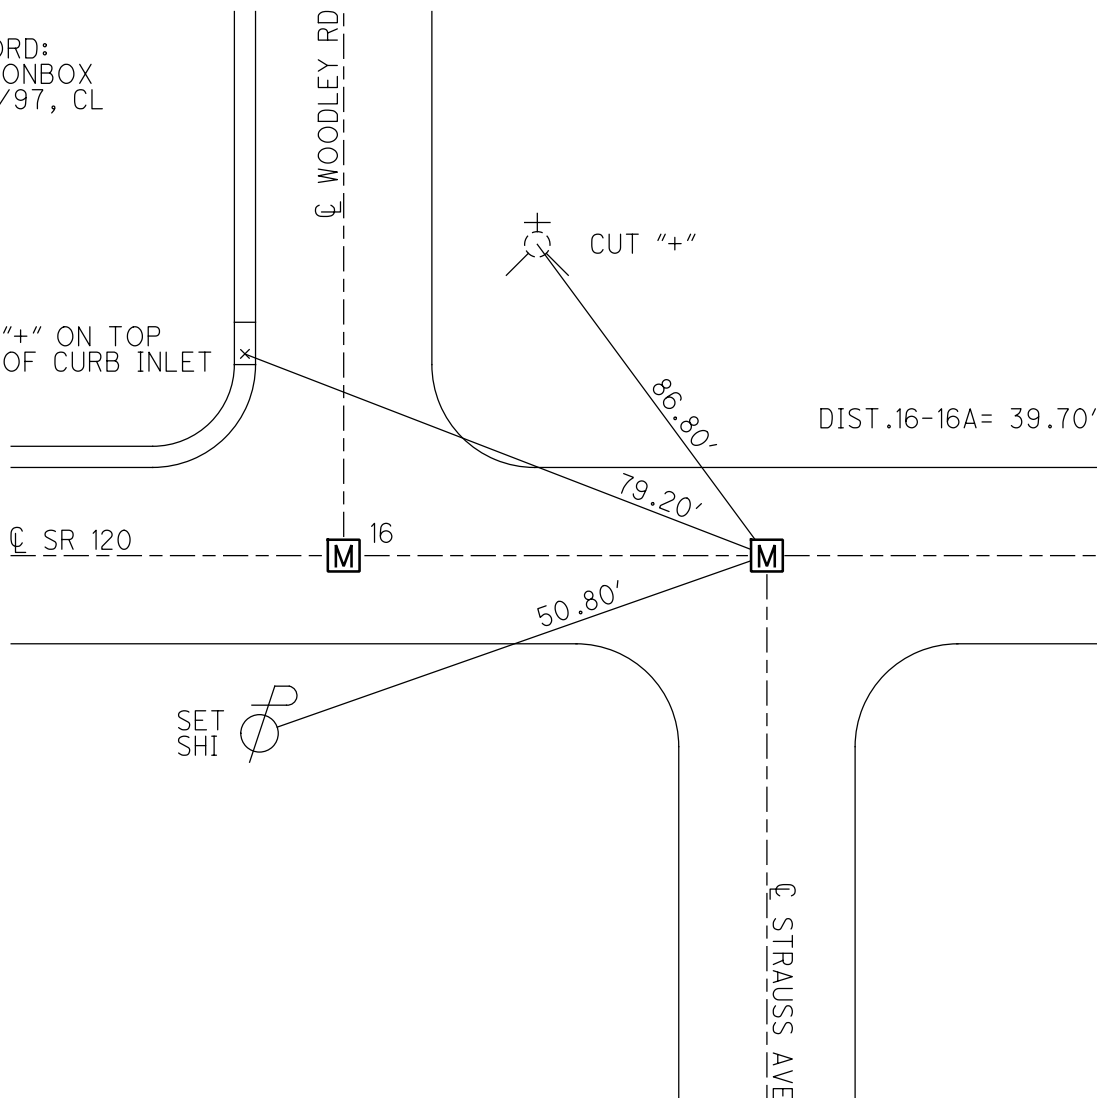

SET
SHI ϕ

O.D.O.T. DISTRICT 2 SURVEY OFFICE

PERSONNEL _____

REFERENCE NO. 16

SHEET 8 OF 15

NOTES LOEHRKE

H.C. LOEHRKE

R.C. Huss

DATE 7-15-97

WEATHER Nice

TEMP. +82

ROUTE U.S. 120

COUNTY LUCAS

TOWNSHIP City of Toledo

SECTION _____

T _____ R _____

TYPE MONUMENT Mon Boxes

ON SURFACE - BELOW Yes

LEFT - PAV'T. - RIGHT Yes

TO EDGE PAVEMENT

S.L.M. 20 + 196 5' 20 + 208

