

O.D.O.T. DISTRICT 2 SURVEY OFFICE (USE ONLY)

PERSONNEL \_\_\_\_\_

REFERENCE NO. 24 B

SHEET 22 OF 37

NOTES CITY \_\_\_\_\_ DATE 5/10/94

H.C. OF \_\_\_\_\_ WEATHER \_\_\_\_\_

R.C. TOLEDO TEMP. \_\_\_\_\_

ROUTE SR 120

COUNTY LUCAS

TOWNSHIP CITY OF TOLEDO

SECTION 29

DWG BY NIESE PID \_\_\_\_\_

T 9 S R 7 E

TYPE MONUMENT MONBOX

ON SURFACE - ~~BELOW~~ ON \_\_\_\_\_


OFFSET  $\varnothing$  PAVEMENT \_\_\_\_\_ LT : RT

\_\_\_\_\_ TO \_\_\_\_\_ EDGE PAVEMENT


STATION: 712+27

HORZ. DATUM: \_\_\_\_\_ GEOID: \_\_\_\_\_

GRID: NORTHING: \_\_\_\_\_ EASTING: \_\_\_\_\_

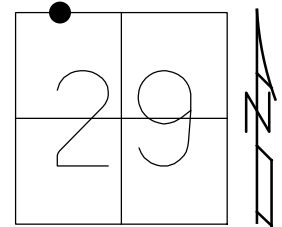

RECORD:  
STA 175+01  
MONBOX  
2/94, SWAILE  
FD MONBOX  
5/10/94

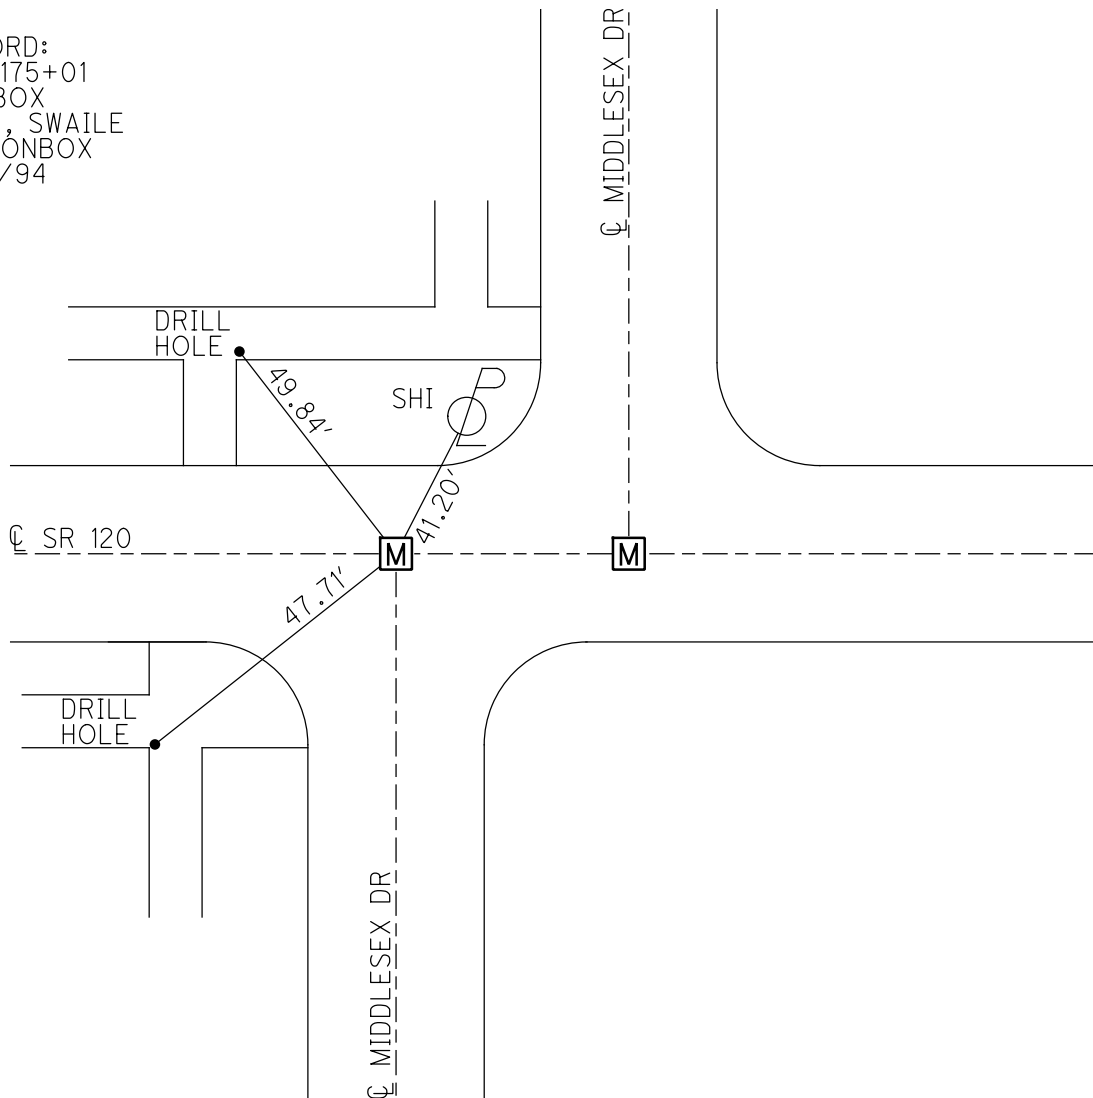

MONUMENT REFERENCE

LOCATION

Central @ Middlesex


Mon. Box 175+01 F 175+53

ATLAS No. \_\_\_\_\_

SEC. \_\_\_\_\_

TOWN \_\_\_\_\_

RANGE \_\_\_\_\_

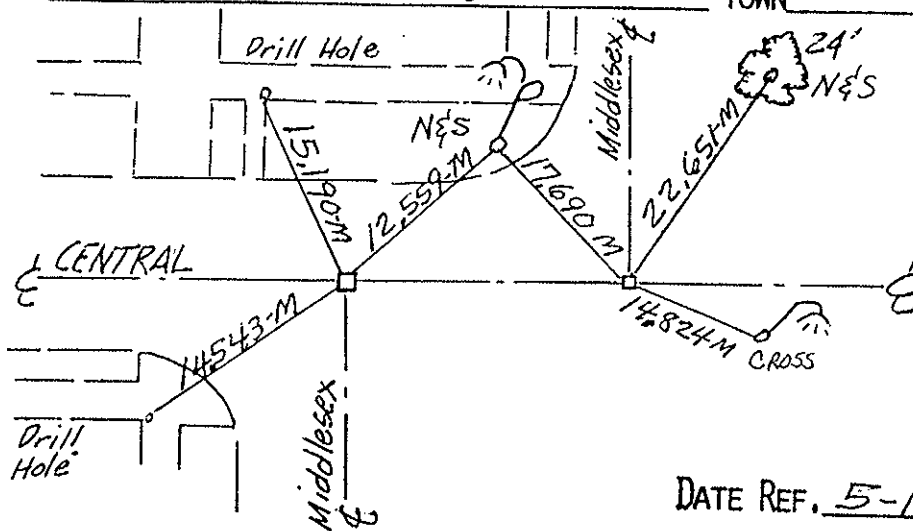

DATE REF. 5-10-94

MONUMENT REFERENCE

LOCATION

Central @ Barrington


178+62 Mon. Box

ATLAS No. \_\_\_\_\_

SEC. \_\_\_\_\_

TOWN \_\_\_\_\_

RANGE \_\_\_\_\_

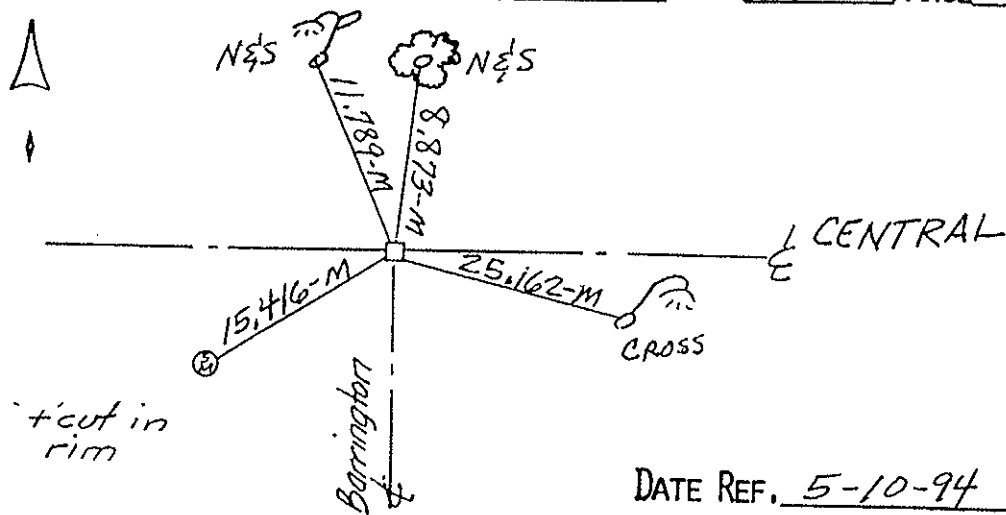

DATE REF. 5-10-94

PERSONNEL	TITLE	PERSONNEL	TITLE
SWAILE			
WARNAKA			
MALAK	/		

PROJECT CENTRAL AVENUE DATE 2-24  
 PROJECT LIMITS SECOR TO JACKMAN WEATHER CLEAR-SNOW-MILD  
 FROM STA. \_\_\_\_\_ TO STA. \_\_\_\_\_ TEMP \_\_\_\_\_

DESCRIPTION CONTROL SHEET

