

O.D.O.T. DISTRICT 2 SURVEY OFFICE (USE ONLY)

PERSONNEL _____

REFERENCE NO. 24 C

SHEET 23 OF 37

NOTES CITY

DATE 5/10/94

ROUTE SR 120

H.C. OF

WEATHER _____

COUNTY LUCAS

R.C. TOLEDO

TEMP. _____

TOWNSHIP CITY OF TOLEDO

SECTION 29

DWG BY _____ PID _____

T 9 S R 7 E

TYPE MONUMENT MONBOX

ON SURFACE - ~~BELOW~~ ON _____

OFFSET \varnothing PAVEMENT _____ LT : RT

_____ TO _____ EDGE PAVEMENT


STATION: 712+79

HORZ. DATUM: _____


GEOID: _____

GRID: NORTHING: _____

EASTING: _____

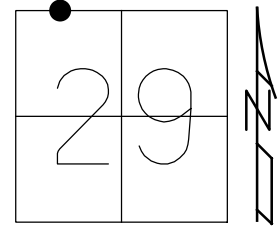


RECORD:
STA 175+53
MONBOX
2/94, SWAILE
FD MONBOX
5/10/94

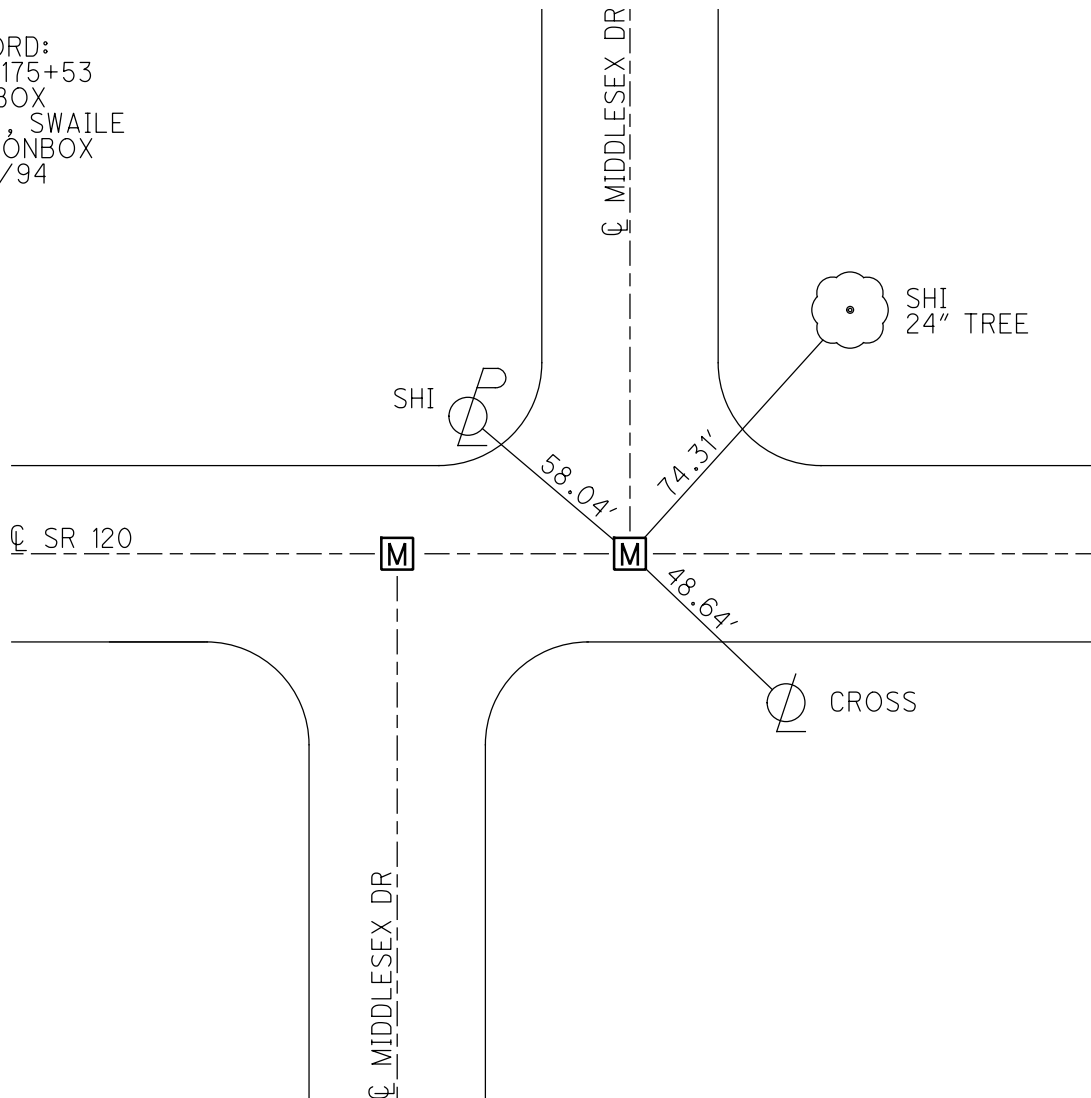

MONUMENT REFERENCE


LOCATION Central @ Middlesex ATLAS No. _____
 Mon. Box 175+01 F 175+53 Mon. Box SEC. _____
 TOWN _____ RANGE _____

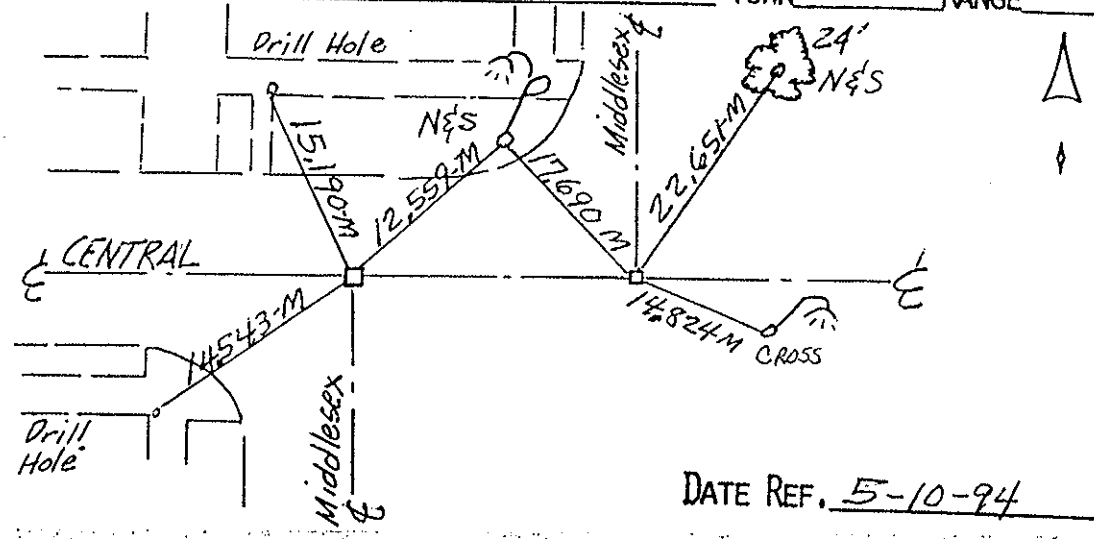

DATE REF. 5-10-94

MONUMENT REFERENCE

LOCATION Central @ Barrington ATLAS No. _____
 178+62 Mon. Box Mon. Box SEC. _____
 TOWN _____ RANGE _____

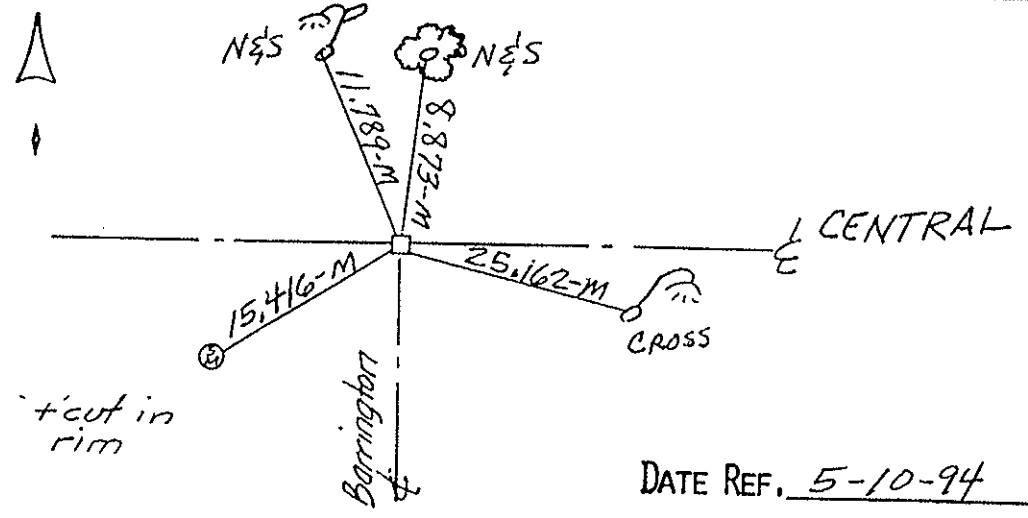

+cut in rim

DATE REF. 5-10-94

PERSONNEL	TITLE	PERSONNEL	TITLE
SWAILE			
WARNAK			
MALAK	/		

PROJECT CENTRAL AVENUE DATE 2-24
 PROJECT LIMITS SECOR TO JACKMAN WEATHER CLEAR-SNOW-MILD
 FROM STA. _____ TO STA. _____ TEMP _____

DESCRIPTION CONTROL SHEET

