

O.D.O.T. DISTRICT 2 SURVEY OFFICE (USE ONLY)

PERSONNEL \_\_\_\_\_

REFERENCE NO. 24 D

SHEET 24 OF 37

NOTES CITY \_\_\_\_\_

DATE 5/10/94

ROUTE SR 120

H.C. OF \_\_\_\_\_

WEATHER \_\_\_\_\_

COUNTY LUCAS

R.C. TOLEDO

TEMP. \_\_\_\_\_

TOWNSHIP CITY OF TOLEDO

DWG BY NIESE

PID \_\_\_\_\_

SECTION 29

T 9 S R 7 E

TYPE MONUMENT MONBOX

ON SURFACE - ~~BELOW~~ ON \_\_\_\_\_

OFFSET  $\varnothing$  PAVEMENT \_\_\_\_\_ LT : RT

\_\_\_\_\_ TO \_\_\_\_\_ EDGE PAVEMENT


STATION: 715+44

HORZ.DATUM: \_\_\_\_\_


GEOID: \_\_\_\_\_

GRID: NORTHING: \_\_\_\_\_

EASTING: \_\_\_\_\_

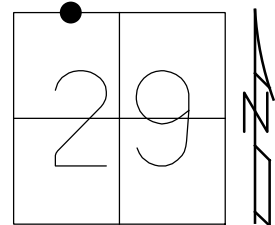


RECORD:  
 STA 178+62  
 MONBOX  
 2/94, SWAILE  
 FD MONBOX  
 5/10/94

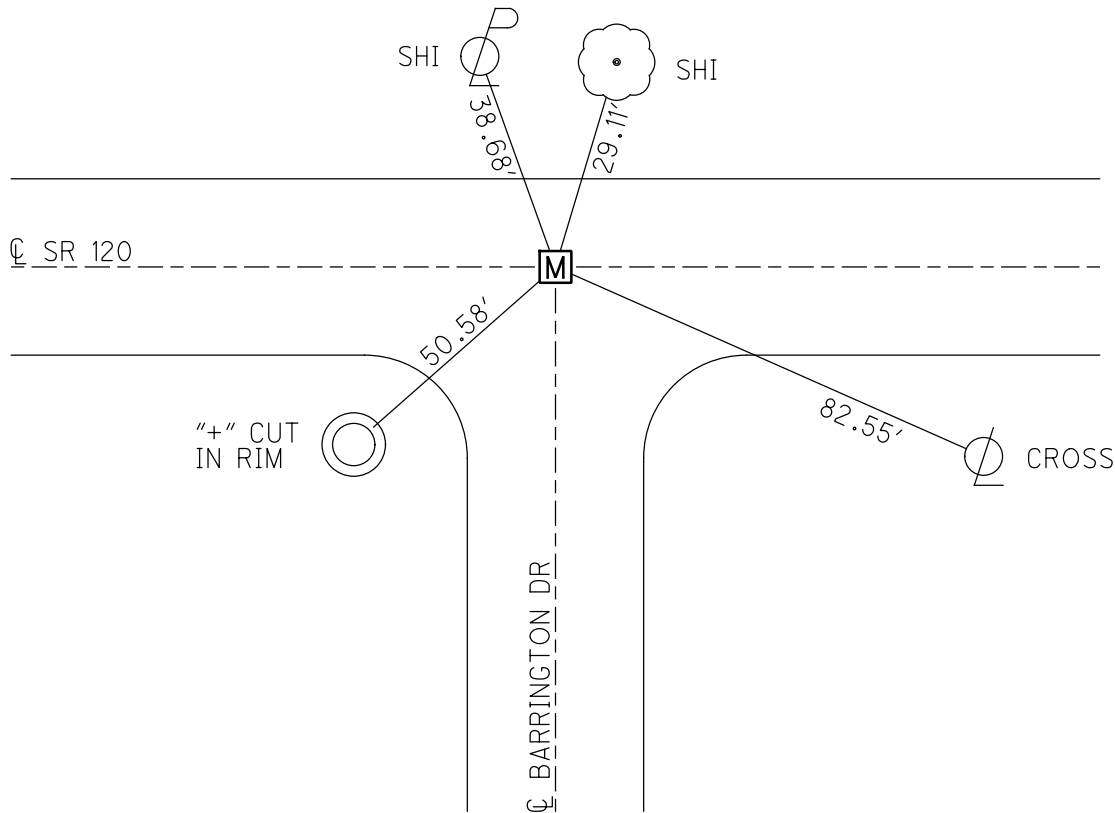

MONUMENT REFERENCE


LOCATION Central @ Middlesex ATLAS No. \_\_\_\_\_  
 Mon. Box 175+01 F 175+53 Mon. Box SEC. \_\_\_\_\_  
 TOWN \_\_\_\_\_ RANGE \_\_\_\_\_

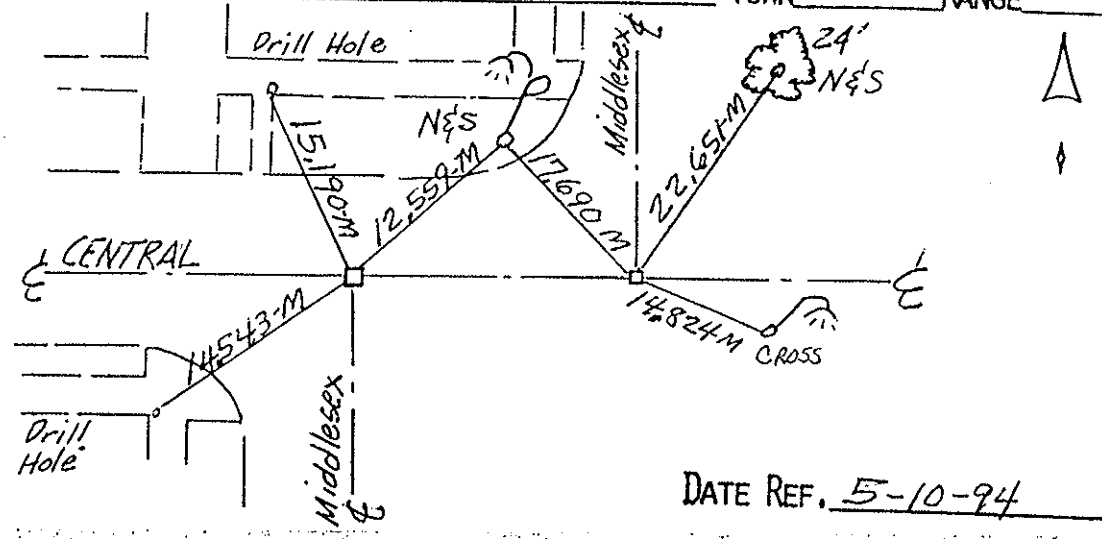

DATE REF. 5-10-94

MONUMENT REFERENCE

LOCATION Central @ Barrington ATLAS No. \_\_\_\_\_  
 178+62 Mon. Box Mon. Box SEC. \_\_\_\_\_  
 TOWN \_\_\_\_\_ RANGE \_\_\_\_\_

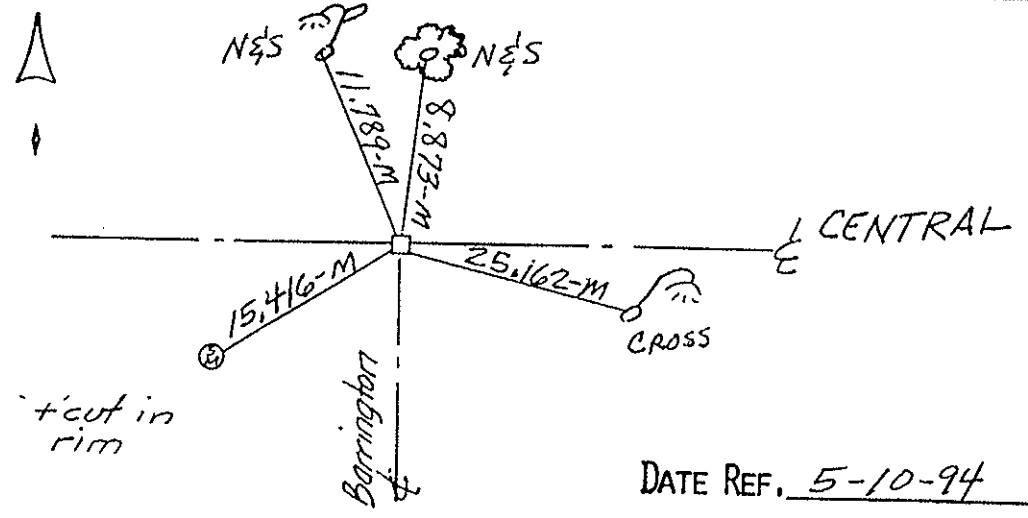

+cut in rim

DATE REF. 5-10-94

PERSONNEL	TITLE	PERSONNEL	TITLE
SWAILE			
WARNAK			
MALAK	/		

PROJECT CENTRAL AVENUE DATE 2-24  
 PROJECT LIMITS SECOR TO JACKMAN WEATHER CLEAR-SNOW-MILD  
 FROM STA. \_\_\_\_\_ TO STA. \_\_\_\_\_ TEMP \_\_\_\_\_

DESCRIPTION CONTROL SHEET

