

O.D.O.T. DISTRICT 2 SURVEY OFFICE (USE ONLY)

PERSONNEL \_\_\_\_\_

REFERENCE NO. 24 F

SHEET 26 OF 37

NOTES CITY \_\_\_\_\_

DATE 5/10/94

ROUTE SR 120

H.C. OF \_\_\_\_\_

WEATHER \_\_\_\_\_

COUNTY LUCAS

R.C. TOLEDO

TEMP. \_\_\_\_\_

TOWNSHIP CITY OF TOLEDO

SECTION 29

DWG BY NIESE

PID \_\_\_\_\_

T 9 S R 7 E

TYPE MONUMENT MONBOX

ON SURFACE - ~~BELOW~~ ON \_\_\_\_\_

OFFSET  $\phi$  PAVEMENT \_\_\_\_\_ LT : RT

\_\_\_\_\_ TO \_\_\_\_\_ EDGE PAVEMENT


STATION: 721+77

HORZ. DATUM: \_\_\_\_\_


GEOID: \_\_\_\_\_

GRID: NORTHING: \_\_\_\_\_

EASTING: \_\_\_\_\_

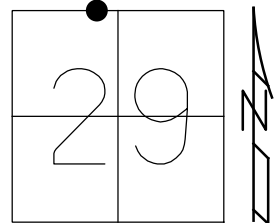

RECORD:  
STA 185+50  
MONBOX  
2/94, SWAILE  
FD MONBOX  
5/10/94

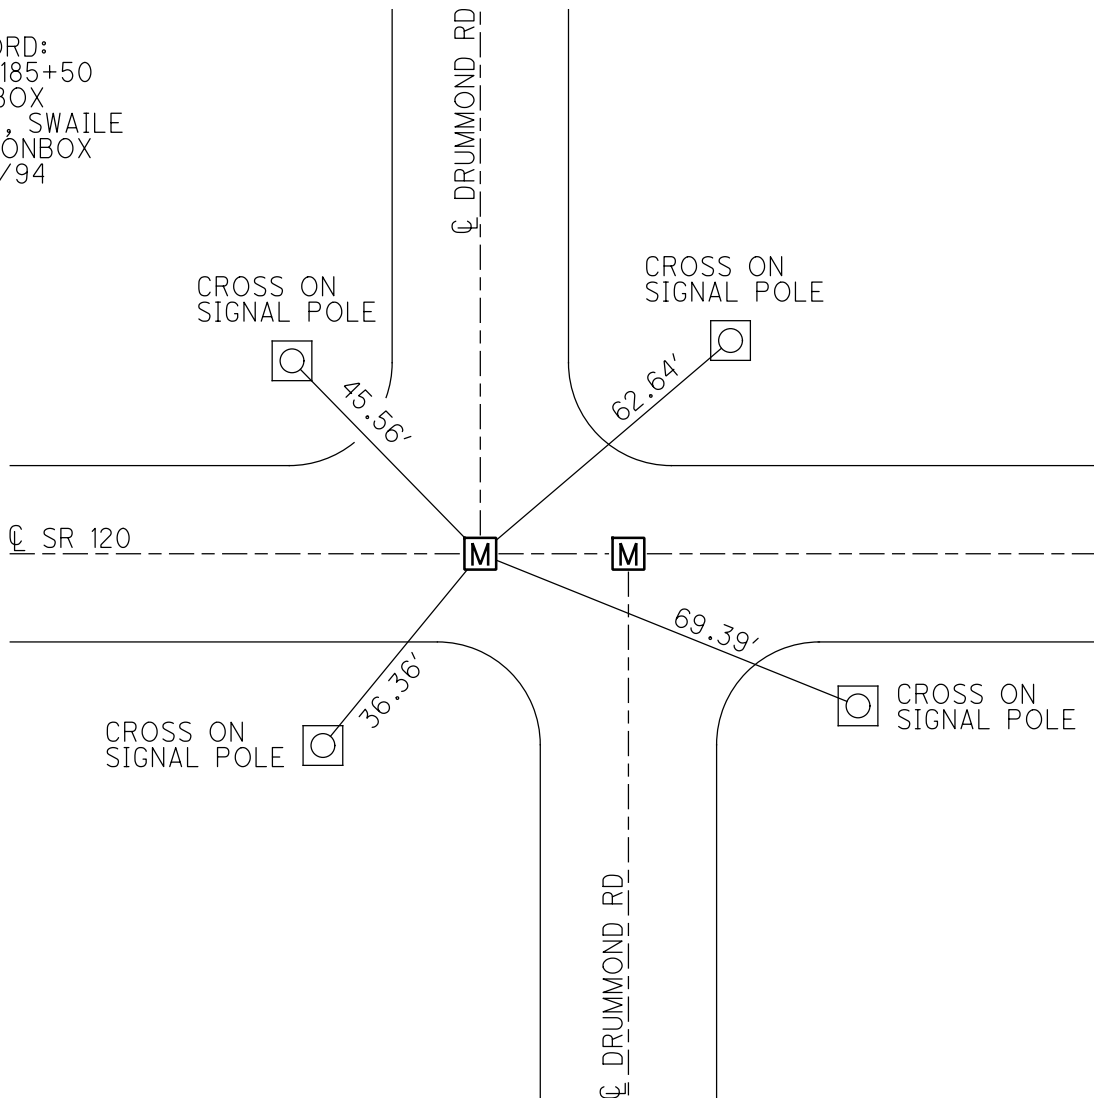

MONUMENT REFERENCE

LOCATION

Central @ Meadowwood


ATLAS No. \_\_\_\_\_

SEC. \_\_\_\_\_

182 + 22 Mon Box

TOWN \_\_\_\_\_

RANGE \_\_\_\_\_

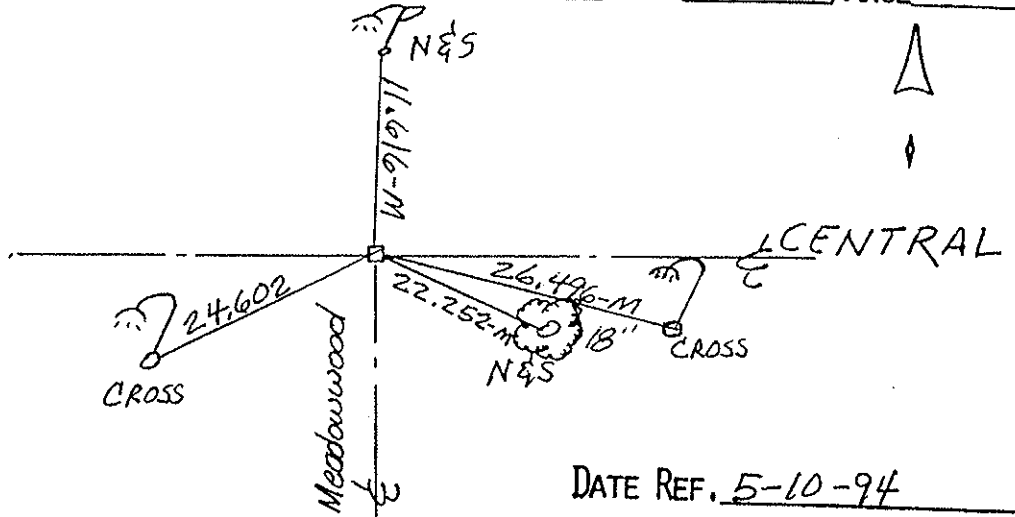

MONUMENT REFERENCE

LOCATION

Central @ Drummond


ATLAS No. \_\_\_\_\_

SEC. \_\_\_\_\_

Mon. Box 185 + 50 & Mon. Box 185 + 84

TOWN \_\_\_\_\_

RANGE \_\_\_\_\_

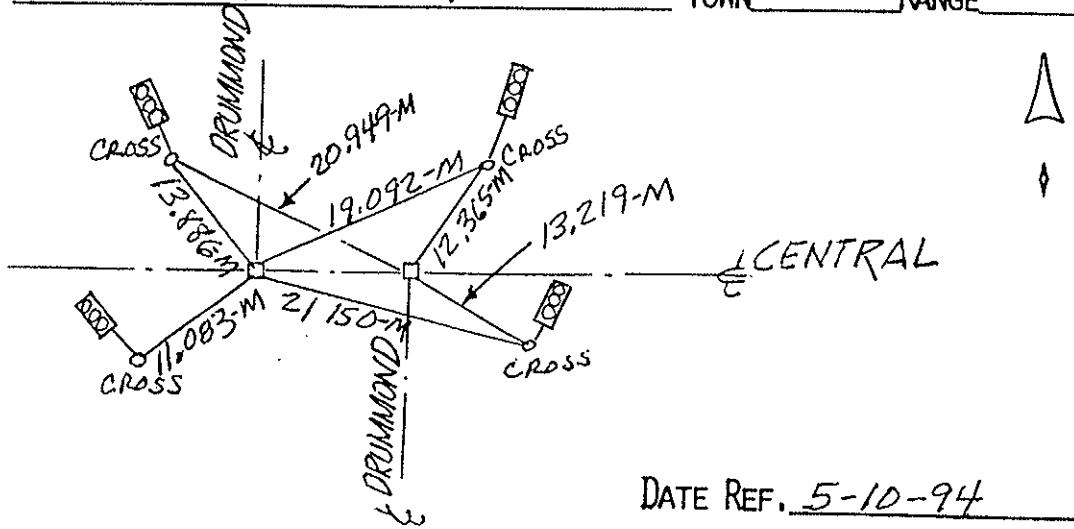

PERSONNEL	TITLE	PERSONNEL	TITLE
SWAILE	AD		
WARNKA	TK		
MALAK	/		

PROJECT CENTRAL AVE. DATE 2-94  
 PROJECT LIMITS SECOR TO JACKMAN WEATHER CLOUDY-SNOW  
 FROM STA. \_\_\_\_\_ TO STA. \_\_\_\_\_ TEMP \_\_\_\_\_

DESCRIPTION CONTROL SHEET

