

O.D.O.T. DISTRICT 2 SURVEY OFFICE (USE ONLY)

PERSONNEL \_\_\_\_\_

REFERENCE NO. 24 H

SHEET 28 OF 37

NOTES CITY \_\_\_\_\_ DATE 5/10/94

ROUTE \_\_\_\_\_ SR 120

H.C. OF \_\_\_\_\_ WEATHER \_\_\_\_\_

COUNTY \_\_\_\_\_ LUCAS

R.C. TOLEDO \_\_\_\_\_ TEMP. \_\_\_\_\_

TOWNSHIP CITY OF TOLEDO

DWG BY NIESE PID \_\_\_\_\_

SECTION \_\_\_\_\_ 29

T 9 S R 7 E

TYPE MONUMENT MONBOX

ON SURFACE - ~~BELOW~~ ON \_\_\_\_\_


OFFSET  $\varnothing$  PAVEMENT \_\_\_\_\_ LT : RT

\_\_\_\_\_ TO \_\_\_\_\_ EDGE PAVEMENT


STATION: 725+47

HORZ. DATUM: \_\_\_\_\_ GEOID: \_\_\_\_\_

GRID: NORTHING: \_\_\_\_\_ EASTING: \_\_\_\_\_

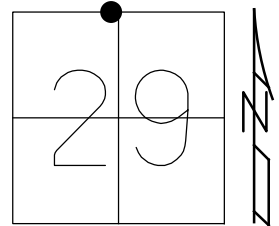

RECORD:  
STA 188+78  
MONBOX  
2/94, SWAILE  
FD MONBOX  
5/10/94

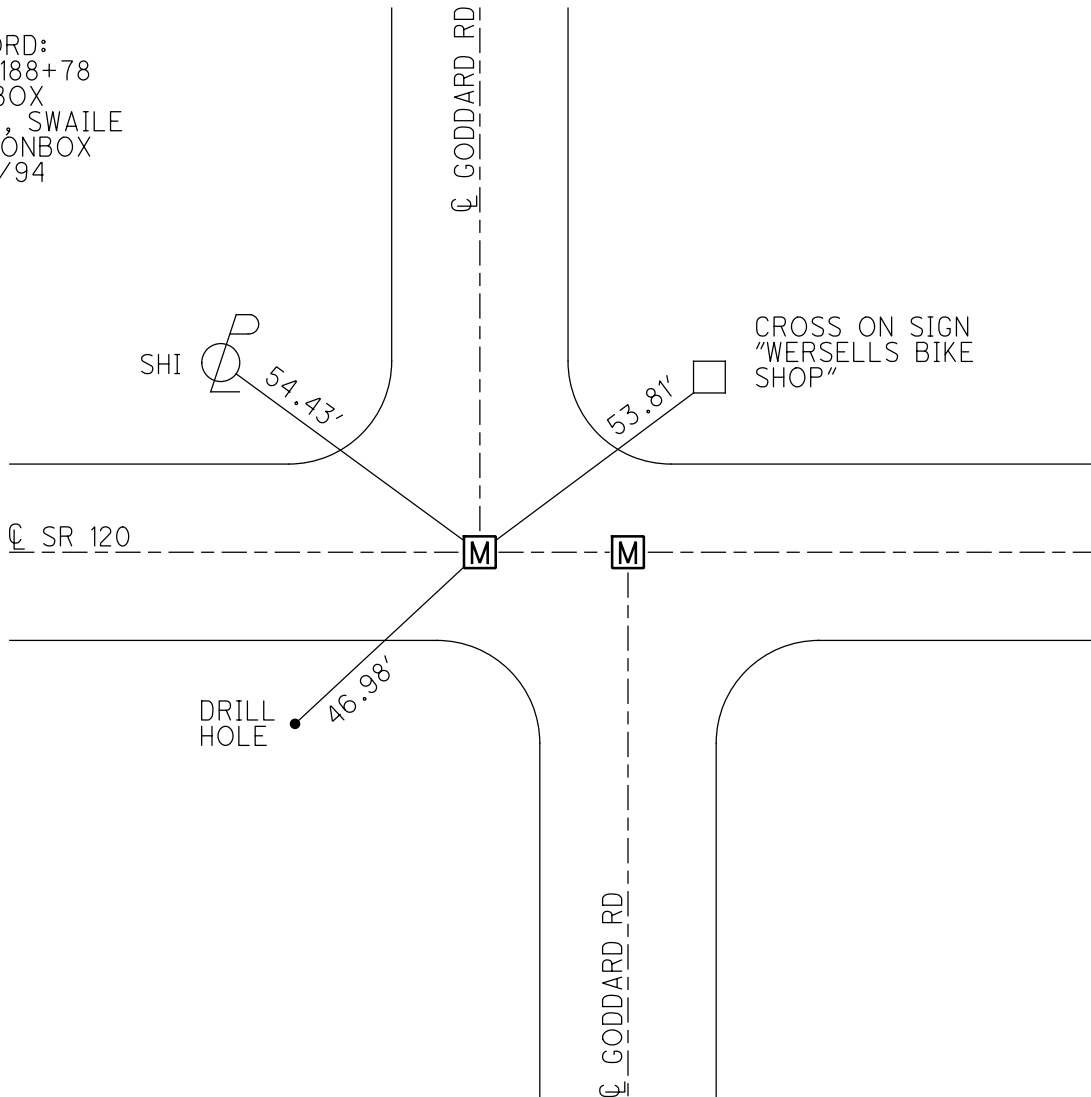

CROSS ON SIGN  
"WERSELLS BIKE  
SHOP"

$\varnothing$  GODDARD RD

MONUMENT REFERENCE

LOCATION


Central @ Goddard

ATLAS No. \_\_\_\_\_

MON. BOX 188+78 F MON. BOX 188+94

SEC. \_\_\_\_\_

TOWN \_\_\_\_\_ RANGE \_\_\_\_\_

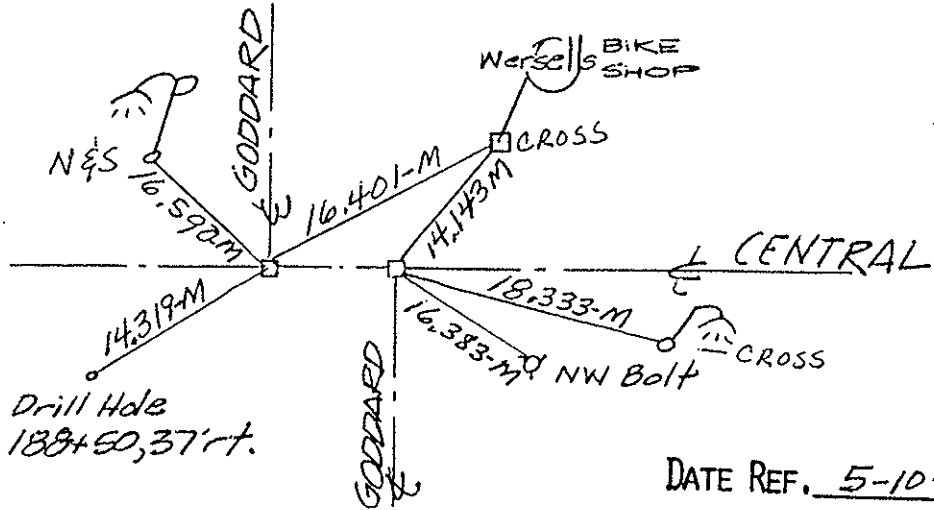

DATE REF. 5-10-94

MONUMENT REFERENCE


LOCATION

Central @ Cheltenham

ATLAS No. \_\_\_\_\_

192+08 MON. BOX

TOWN \_\_\_\_\_ RANGE \_\_\_\_\_

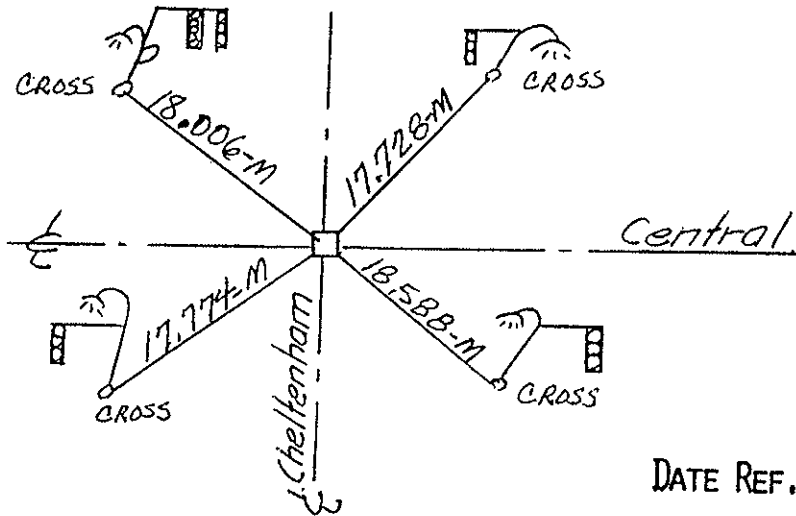

DATE REF. 5-10-94

PERSONNEL	TITLE	PERSONNEL	TITLE
SWAILE	AD		
WARNKA	TK		
MALAK	/		

PROJECT CENTRAL AVE. DATE 2-94  
 PROJECT LIMITS SECOR TO JACKMAN WEATHER CLOUDY-SNOW  
 FROM STA. \_\_\_\_\_ TO STA. \_\_\_\_\_ TEMP \_\_\_\_\_

DESCRIPTION CONTROL SHEET

