

O.D.O.T. DISTRICT 2 SURVEY OFFICE (USE ONLY)

PERSONNEL _____

REFERENCE NO. 24 I

SHEET 29 OF 37

NOTES CITY _____

DATE 5/10/94

ROUTE SR 120

H.C. OF _____

WEATHER _____

COUNTY LUCAS

R.C. TOLEDO

TEMP. _____

TOWNSHIP CITY OF TOLEDO

SECTION 29

DWG BY NIESE

PID _____

T 9 S R 7 E

TYPE MONUMENT MONBOX

ON SURFACE - ~~BELOW~~ ON _____

OFFSET \varnothing PAVEMENT _____ LT : RT

_____ TO _____ EDGE PAVEMENT


STATION: 725+63

HORZ. DATUM: _____


GEOID: _____

GRID: NORTHING: _____

EASTING: _____

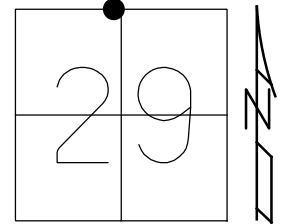

RECORD:
STA 188+96
MONBOX
2/94, SWAILE
FD MONBOX
5/10/94

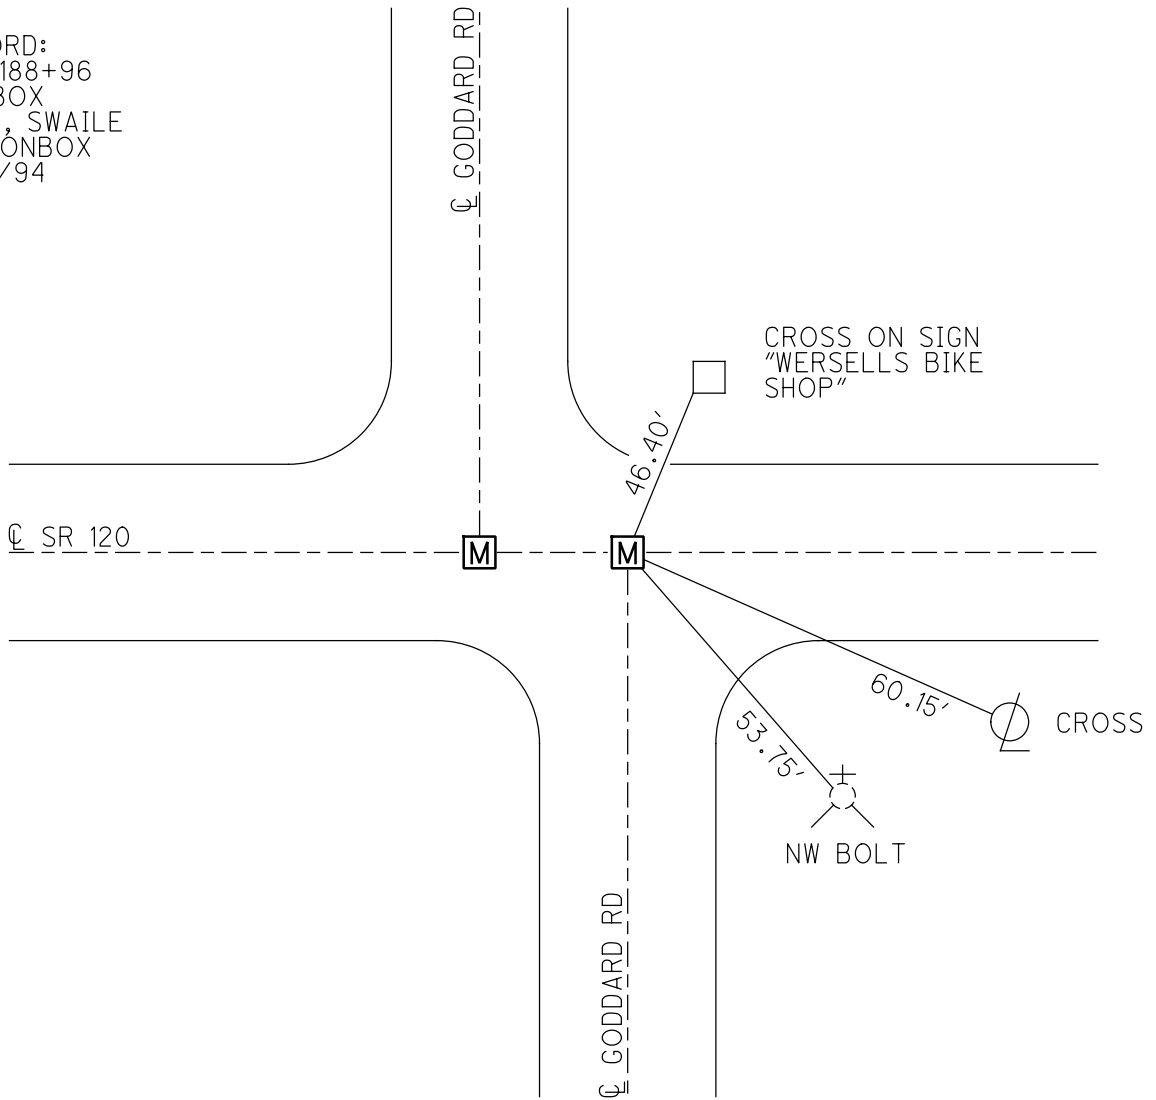

MONUMENT REFERENCE

LOCATION


Central @ Goddard

ATLAS No. _____

MON. BOX 188+78 F MON. BOX 188+94

SEC. _____

TOWN _____ RANGE _____

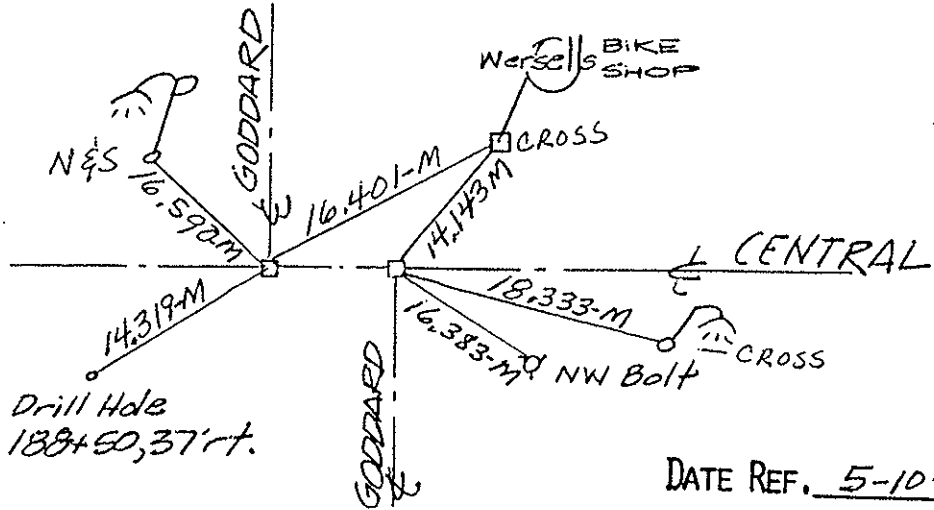

MONUMENT REFERENCE


LOCATION

Central @ Cheltenham

ATLAS No. _____

192+08 MON. BOX

TOWN _____ RANGE _____

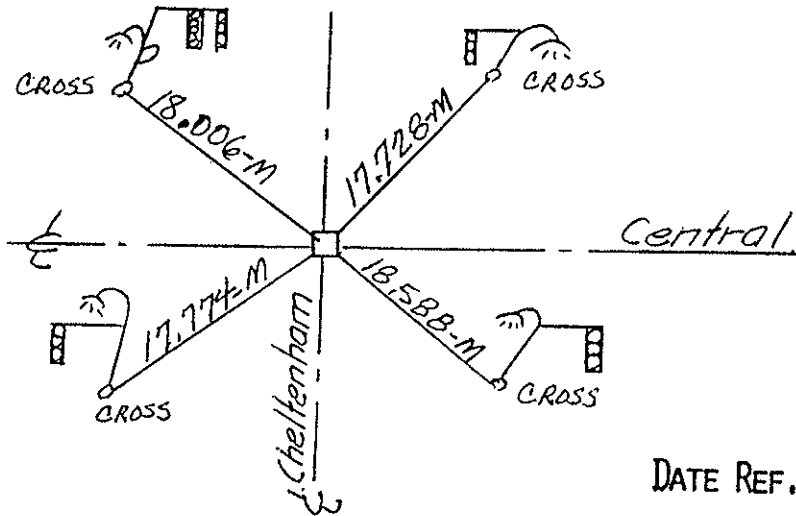

PERSONNEL	TITLE	PERSONNEL	TITLE
SWAILE	AD		
WARNKA	TK		
MALAK	/		

PROJECT CENTRAL AVE. DATE 2-94
 PROJECT LIMITS SECOR TO JACKMAN WEATHER CLOUDY-SNOW
 FROM STA. _____ TO STA. _____ TEMP _____

DESCRIPTION CONTROL SHEET

