

O.D.O.T. DISTRICT 2 SURVEY OFFICE (USE ONLY)

PERSONNEL _____

REFERENCE NO. 24 K

SHEET 30 OF 37

NOTES CITY _____ DATE 5/10/94

ROUTE SR 120

H.C. OF _____ WEATHER _____

COUNTY LUCAS

R.C. TOLEDO TEMP. _____

TOWNSHIP CITY OF TOLEDO

DWG BY NIESE PID _____

SECTION 29

T 9 S R 7 E

TYPE MONUMENT MONBOX

ON SURFACE - ~~BELOW~~ ON _____

OFFSET \varnothing PAVEMENT _____ LT : RT

_____ TO _____ EDGE PAVEMENT


STATION: 728+64

HORZ.DATUM: _____


GEOID: _____

GRID: NORTHING: _____

EASTING: _____

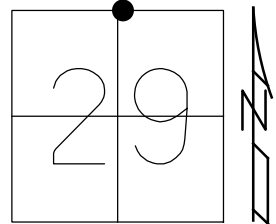

RECORD:
 STA 192+08
 MONBOX
 2/94, SWAILE
 FD MONBOX
 5/10/94

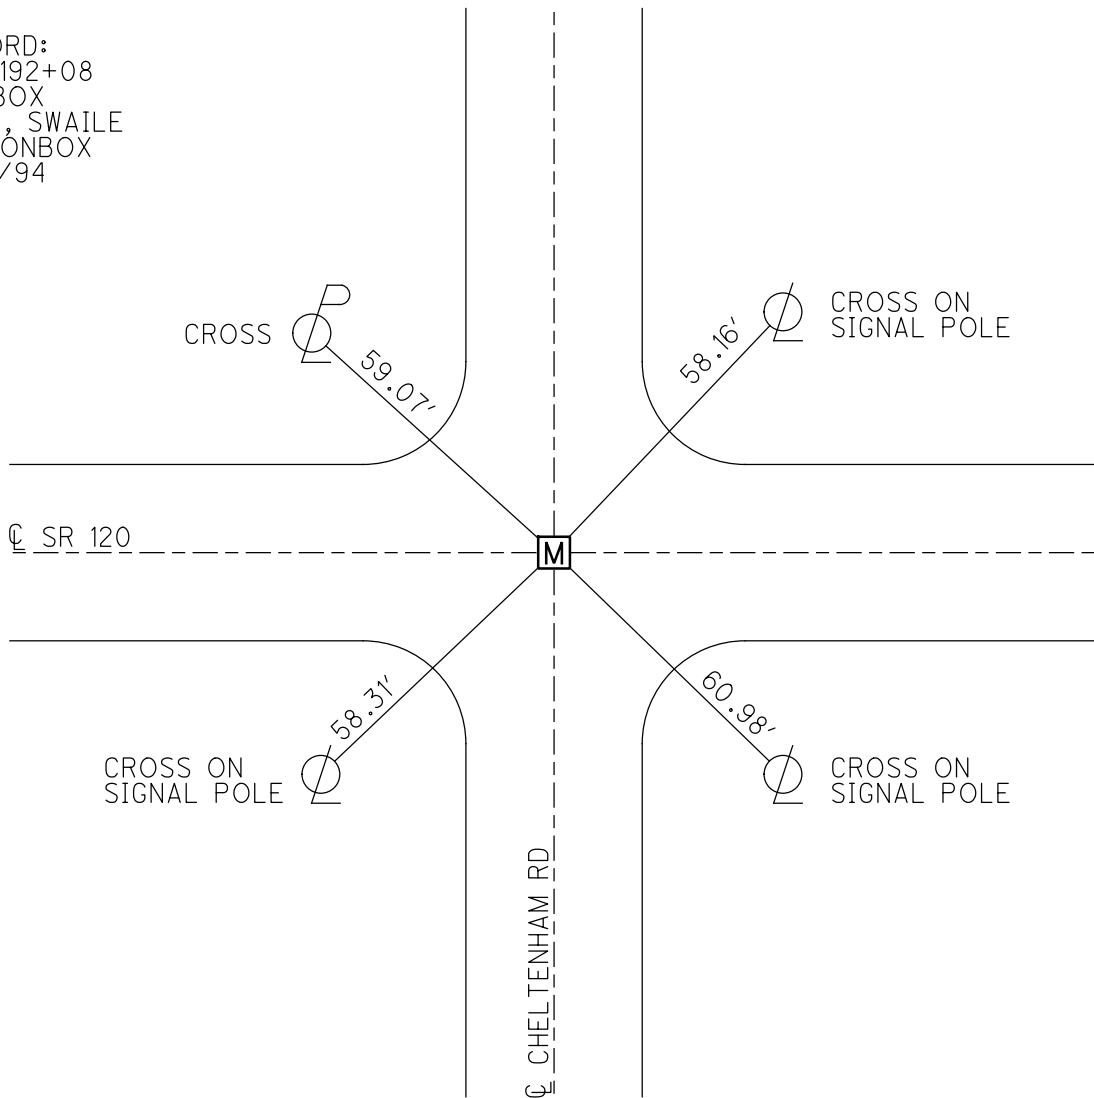

MONUMENT REFERENCE

LOCATION


Central @ Goddard

ATLAS No. _____

MON. BOX 188+78 F MON. BOX 188+94

SEC. _____

TOWN _____ RANGE _____

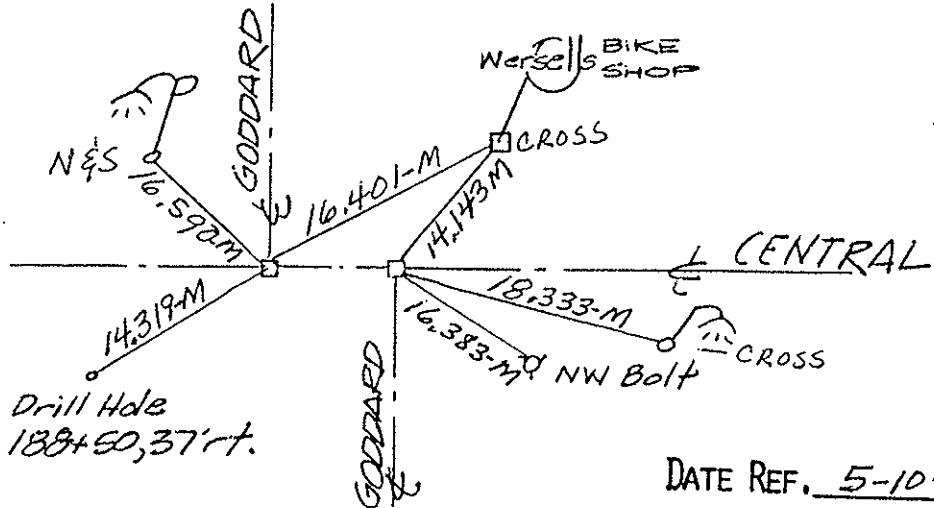

DATE REF. 5-10-94

MONUMENT REFERENCE

LOCATION


Central @ Cheltenham

ATLAS No. _____

192+08 MON. BOX

SEC. _____

TOWN _____ RANGE _____

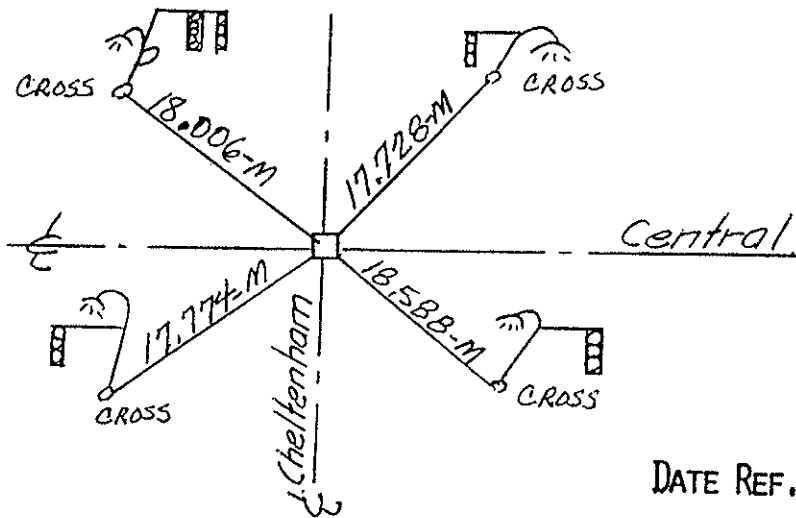

DATE REF. 5-10-94

PERSONNEL	TITLE	PERSONNEL	TITLE
SWAILE	AD		
WARNKA	TK		
MALAK	/		

PROJECT CENTRAL AVE. DATE 2-94
 PROJECT LIMITS SECOR TO JACKMAN WEATHER CLOUDY-SNOW
 FROM STA. _____ TO STA. _____ TEMP _____

DESCRIPTION CONTROL SHEET

