

O.D.O.T. DISTRICT 2 SURVEY OFFICE (USE ONLY)

PERSONNEL _____

REFERENCE NO. 24 L

SHEET 31 OF 37

NOTES CITY _____ DATE 5/10/94
 H.C. OF _____ WEATHER _____
 R.C. TOLEDO _____ TEMP. _____

ROUTE _____ SR 120
 COUNTY _____ LUCAS
 TOWNSHIP CITY OF TOLEDO
 SECTION _____ 29
 T 9 S R 7 E

DWG BY NIESE PID _____

TYPE MONUMENT MONBOX

ON SURFACE - ~~BELOW~~ ON _____


OFFSET \varnothing PAVEMENT _____ LT : RT

_____ TO _____ EDGE PAVEMENT


STATION: 731+81

HORZ.DATUM: _____ GEOID: _____

GRID: NORTHING: _____ EASTING: _____

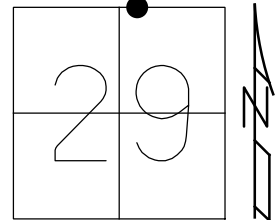

RECORD:
 STA 195+40
 MONBOX
 2/94, SWAILE
 FD MONBOX
 5/10/94

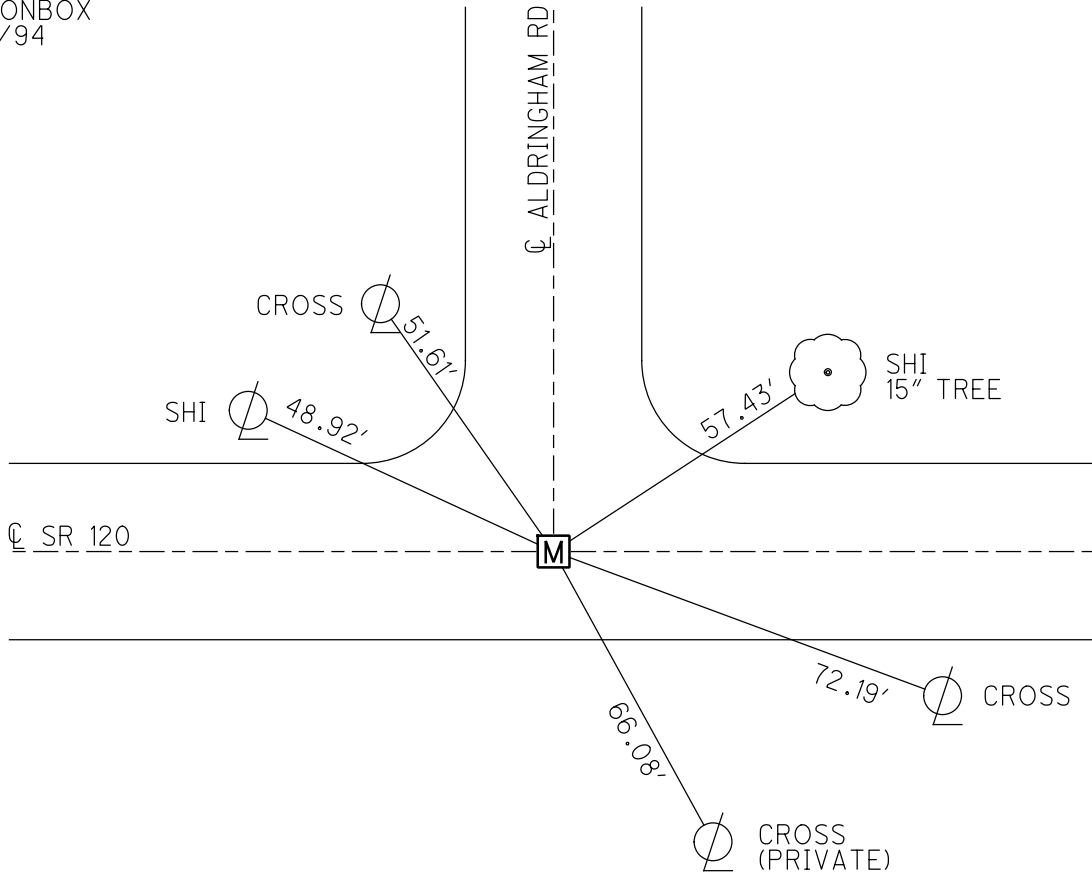

MONUMENT REFERENCE

LOCATION

Central @ Aldringham


ATLAS No. _____

SEC. _____

195 + 40 Mon. Box

TOWN _____

RANGE _____

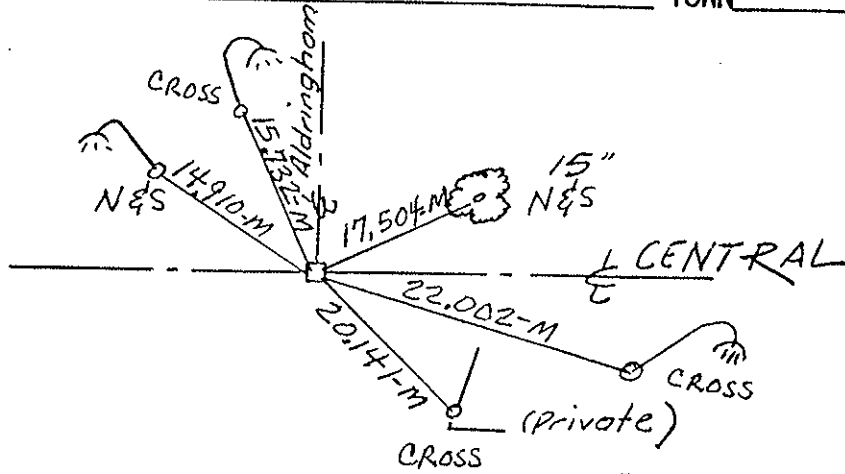

DATE REF. 5-10-94

MONUMENT REFERENCE

LOCATION

Central @ Chollett


ATLAS No. _____

SEC. _____

198 + 50 Mon. Box

TOWN _____

RANGE _____

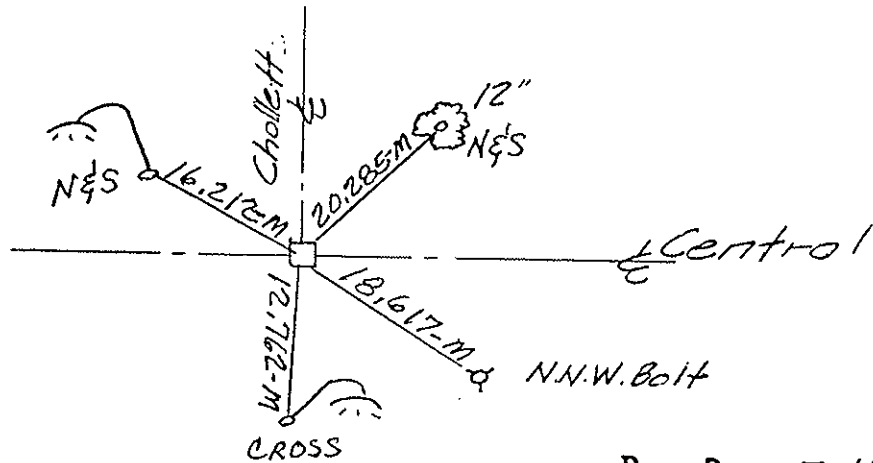

DATE REF. 5-10-94

PERSONNEL	TITLE	PERSONNEL	TITLE
SWAILE	AD		
WARNKA	TK		
MALAK	/		

PROJECT CENTRAL AVE. DATE 2-94
 PROJECT LIMITS SECOR TO JACKMAN WEATHER CLOUDY-SNOW
 FROM STA. _____ TO STA. _____ TEMP _____

DESCRIPTION CONTROL SHEET

