

O.D.O.T. DISTRICT 2 SURVEY OFFICE (USE ONLY)

PERSONNEL \_\_\_\_\_

REFERENCE NO. 24 N

SHEET 33 OF 37

NOTES CITY \_\_\_\_\_  
 H.C. OF \_\_\_\_\_  
 R.C. TOLEDO \_\_\_\_\_

DATE 5/10/94  
 WEATHER \_\_\_\_\_  
 TEMP. \_\_\_\_\_

ROUTE SR 120  
 COUNTY LUCAS  
 TOWNSHIP CITY OF TOLEDO  
 SECTION 29  
 T 9 S R 7 E

DWG BY NIESE PID \_\_\_\_\_

TYPE MONUMENT MONBOX


ON SURFACE - ~~BELOW~~ ON \_\_\_\_\_

OFFSET  $\text{C}$  PAVEMENT \_\_\_\_\_ LT : RT  
 \_\_\_\_\_ TO \_\_\_\_\_ EDGE PAVEMENT


STATION: 739+73

HORZ. DATUM: \_\_\_\_\_ GEOID: \_\_\_\_\_

GRID: NORTHING: \_\_\_\_\_ EASTING: \_\_\_\_\_

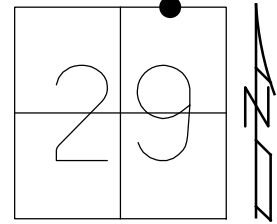

RECORD:  
 STA 203+36  
 MONBOX  
 2/94, SWAILE  
 FD MONBOX  
 5/10/94

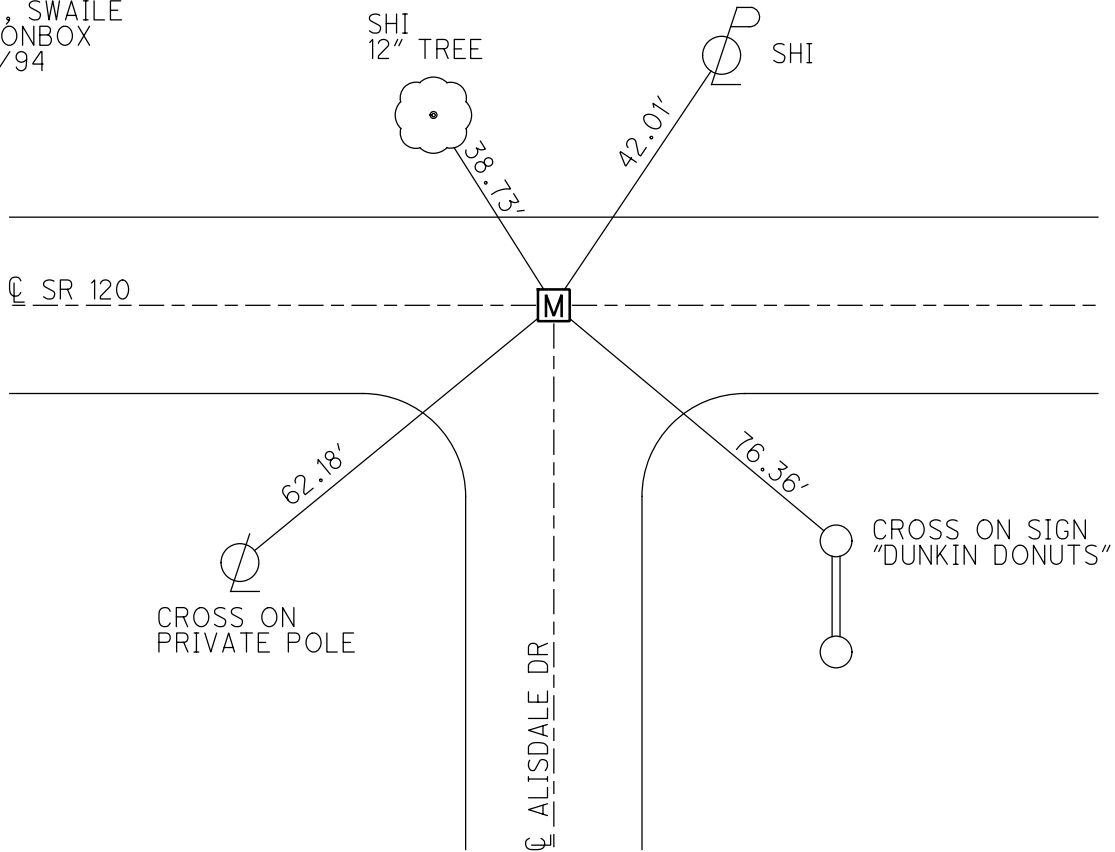

MONUMENT REFERENCE

LOCATION

Central @ Alisdale


ATLAS No. \_\_\_\_\_

SEC. \_\_\_\_\_

203 + 36 MON. BOX

TOWN \_\_\_\_\_

RANGE \_\_\_\_\_

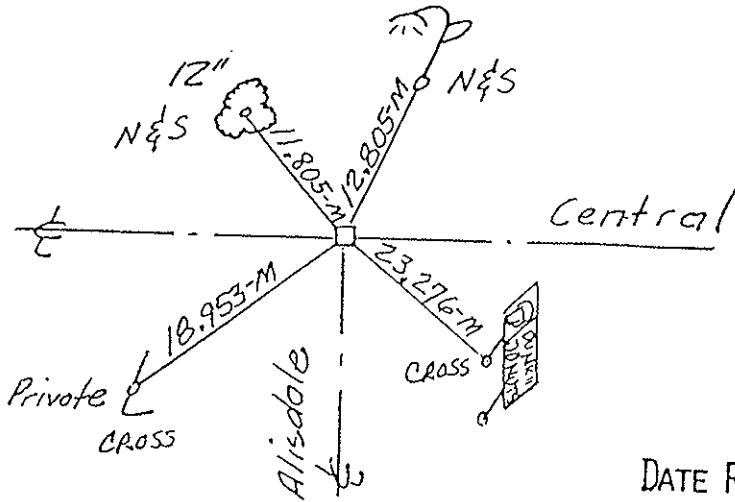

DATE REF. 5-10-94

MONUMENT REFERENCE

LOCATION

Central @ Wendover


ATLAS No. \_\_\_\_\_

SEC. \_\_\_\_\_

205 + 21 MON. BOX

TOWN \_\_\_\_\_

RANGE \_\_\_\_\_

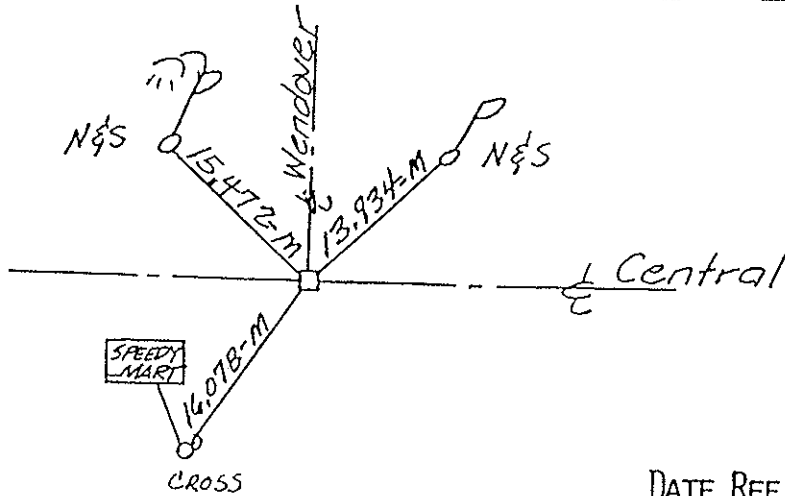

DATE REF. 5-10-94

PERSONNEL	TITLE	PERSONNEL	TITLE
SWAILE	LL		
WARNKA	TK		
MALAK	/		

PROJECT CENTRAL AVE DATE 2-94  
 SECOR TO JACKMAN  
 PROJECT LIMITS JACKMAN WEATHER SNOW-RAIN  
 FROM STA. \_\_\_\_\_ TO STA. \_\_\_\_\_ TEMP \_\_\_\_\_

DESCRIPTION CONTROL SHEET

