

O.D.O.T. DISTRICT 2 SURVEY OFFICE (USE ONLY)

PERSONNEL _____

REFERENCE NO. 24 "O"

SHEET 34 OF 37

NOTES CITY _____ DATE 5/10/94

H.C. OF _____ WEATHER _____

R.C. TOLEDO TEMP. _____

ROUTE SR 120

COUNTY LUCAS

TOWNSHIP CITY OF TOLEDO

SECTION 29

DWG BY NIESE PID _____

T 9 S R 7 E

TYPE MONUMENT MONBOX

ON SURFACE - ~~BELOW~~ ON


OFFSET \odot PAVEMENT _____ LT : RT

_____ TO _____ EDGE PAVEMENT


STATION: 740+78

HORZ. DATUM: _____ GEOID: _____

GRID: NORTHING: _____ EASTING: _____

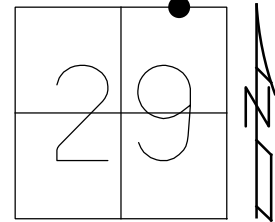

RECORD:
 STA 205+21
 MONBOX
 2/94, SWAILE
 FD MONBOX
 5/10/94

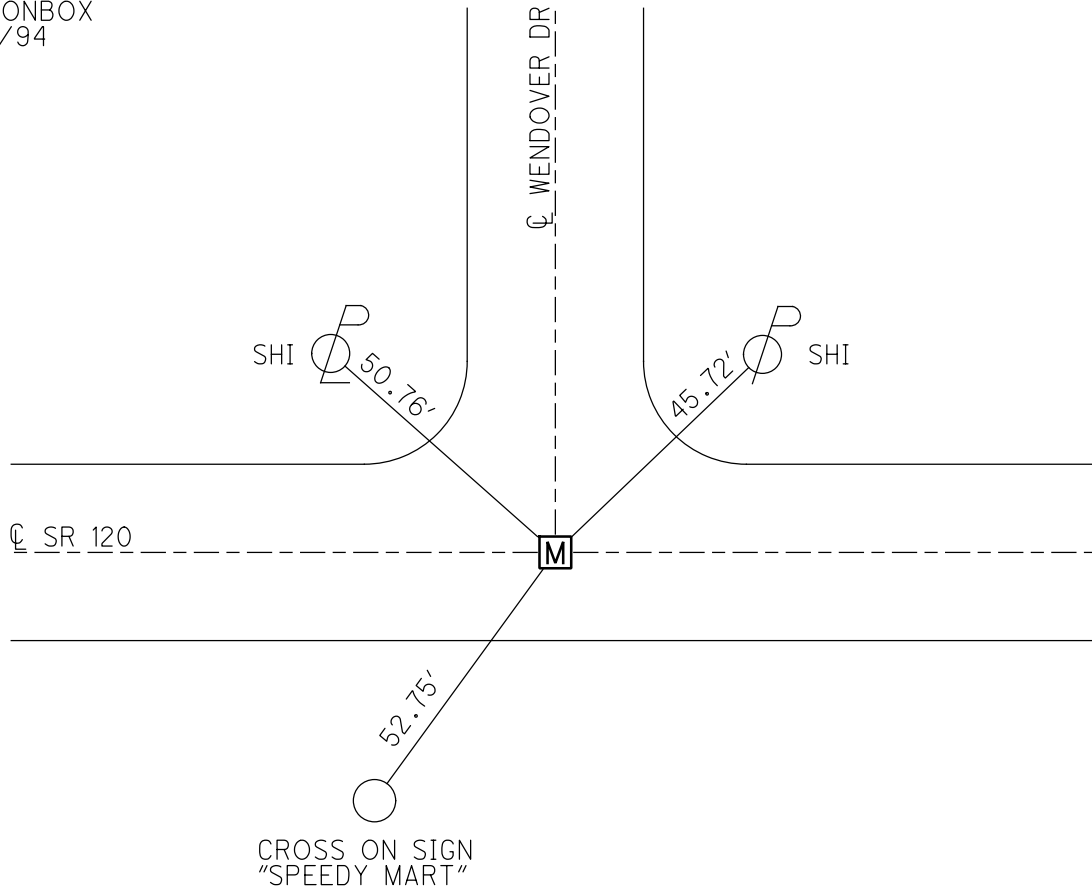

MONUMENT REFERENCE

LOCATION

Central @ Alisdale


ATLAS No. _____

SEC. _____

203 + 36 MON. BOX

TOWN _____

RANGE _____

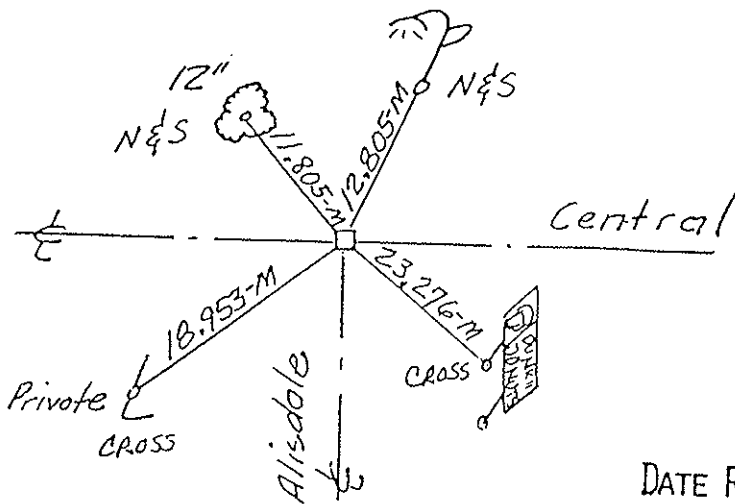

DATE REF. 5-10-94

MONUMENT REFERENCE

LOCATION

Central @ Wendover


ATLAS No. _____

SEC. _____

205 + 21 MON. BOX

TOWN _____

RANGE _____

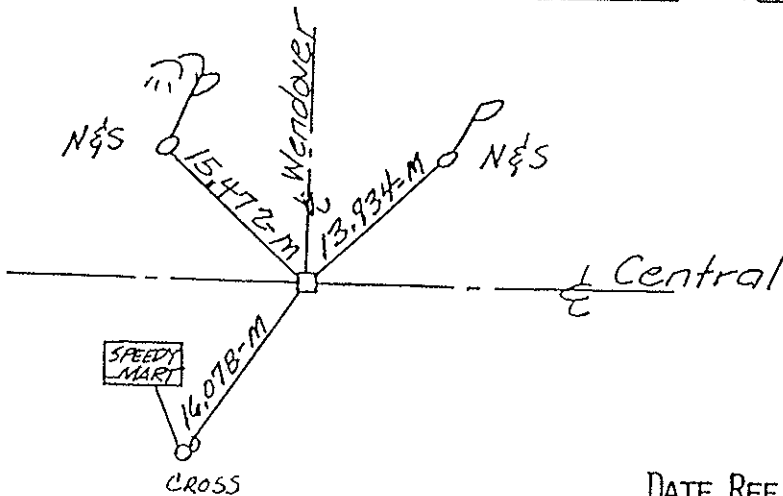

DATE REF. 5-10-94

PERSONNEL	TITLE	PERSONNEL	TITLE
SWAILE	LL		
WARNKA	TK		
MALAK	/		

PROJECT CENTRAL AVE DATE 2-94
 SECOR TO JACKMAN WEATHER SNOW-RAIN
 FROM STA. _____ TO STA. _____ TEMP _____

DESCRIPTION CONTROL SHEET

