

O.D.O.T. DISTRICT 2 SURVEY OFFICE (USE ONLY)

PERSONNEL _____

REFERENCE NO. 24 P

SHEET 35 OF 37

NOTES CITY _____ DATE 5/10/94

ROUTE _____ SR 120

H.C. OF _____ WEATHER _____

COUNTY LUCAS

R.C. TOLEDO TEMP. _____

TOWNSHIP CITY OF TOLEDO

DWG BY NIESE PID _____

SECTION 29

T 9 S R 7 E

TYPE MONUMENT MONBOX

ON SURFACE - ~~BELOW~~ ON _____


OFFSET \varnothing PAVEMENT _____ LT : RT

_____ TO _____ EDGE PAVEMENT


STATION: 743+77

HORIZ.DATUM: _____ GEOID: _____

GRID: NORTHING: _____ EASTING: _____

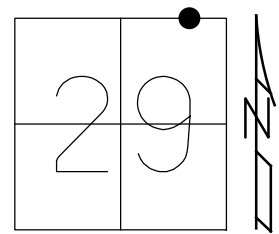

RECORD:
STA 207+88
MONBOX
2/94, SWAILE
FD MONBOX
5/10/94

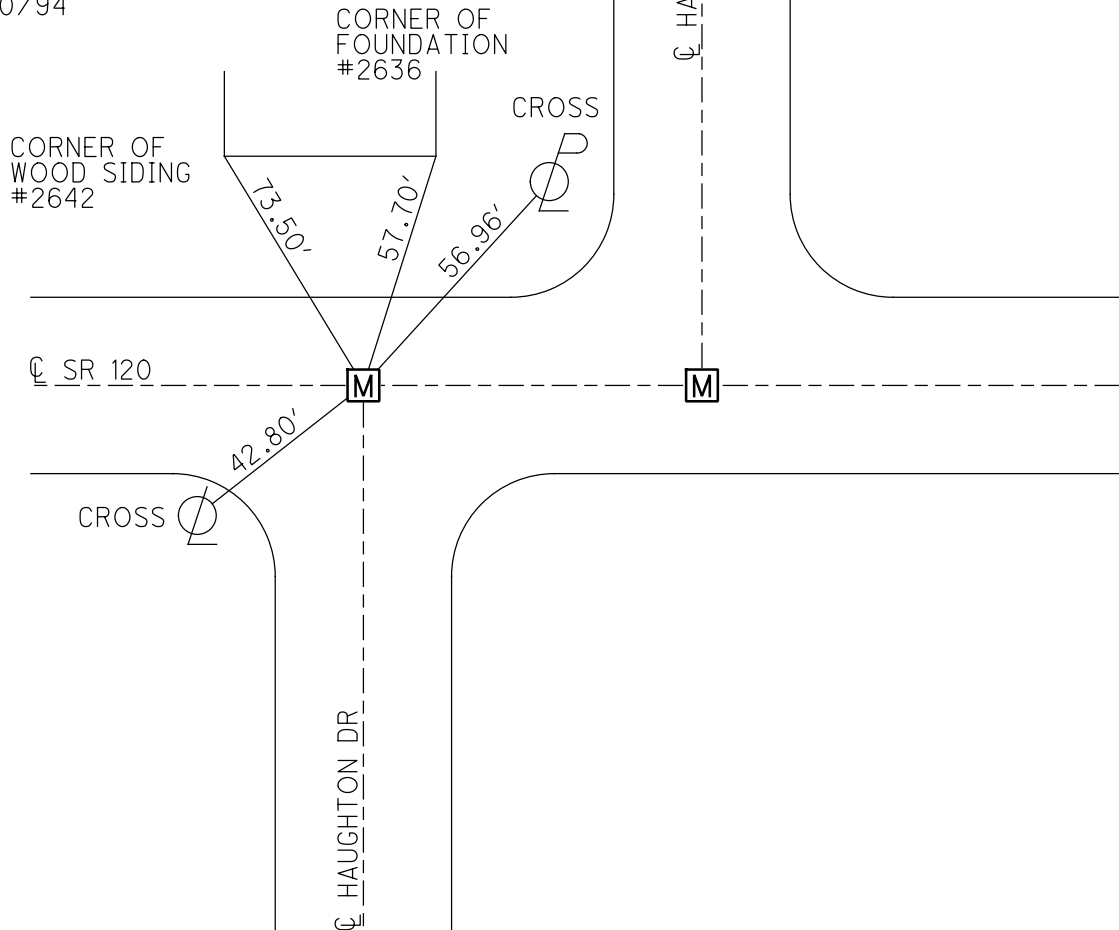

MONUMENT REFERENCE

LOCATION


ATLAS No. _____

Central @ Houghton

SEC. _____

MON. BOX 207+88 N 208+59

TOWN _____ RANGE _____

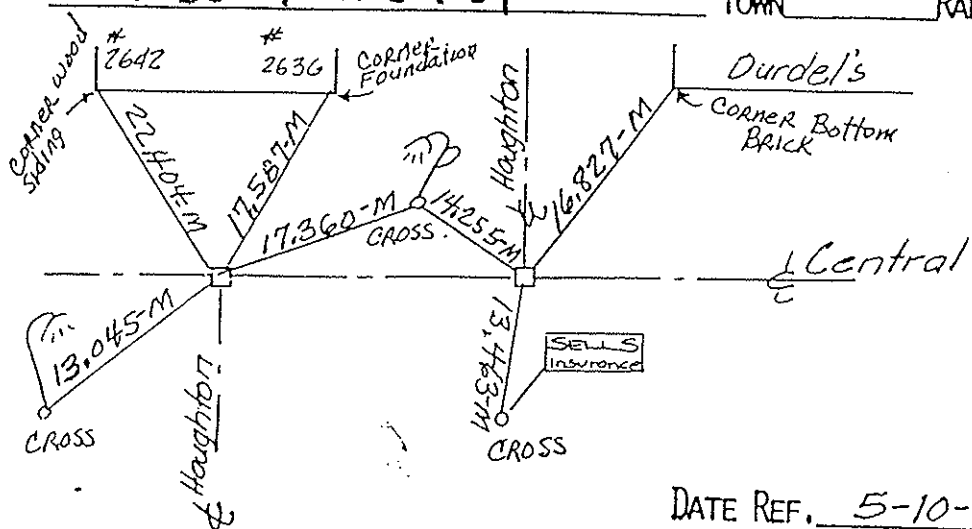

DATE REF. 5-10-94

PERSONNEL	TITLE	PERSONNEL	TITLE
SWAILE	LL		
WARNKA	TK		
MALAK	/		

PROJECT CENTRAL AVE DATE 2-94
 SECOR TO JACKMAN
 PROJECT LIMITS JACKMAN WEATHER SNOW-RAIN
 FROM STA. _____ TO STA. _____ TEMP _____

DESCRIPTION CONTROL SHEET

