

O.D.O.T. DISTRICT 2 SURVEY OFFICE (USE ONLY)

PERSONNEL _____

REFERENCE NO. 24 Q

SHEET 36 OF 37

NOTES CITY _____ DATE 5/10/94

H.C. OF _____ WEATHER _____

R.C. TOLEDO TEMP. _____

ROUTE _____ SR 120

COUNTY _____ LUCAS

TOWNSHIP CITY OF TOLEDO

SECTION _____ 29

DWG BY NIESE PID _____

T 9 S R 7 E

TYPE MONUMENT MONBOX

ON SURFACE - ~~BELOW~~ _____ ON _____


OFFSET C PAVEMENT _____ LT : RT

_____ TO _____ EDGE PAVEMENT


STATION: 744+48

HORZ. DATUM: _____ GEOID: _____

GRID: NORTHING: _____ EASTING: _____

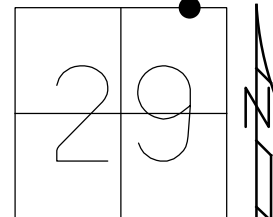

RECORD:
STA 208+59
2/94, SWAILE
FD MONBOX
5/10/94

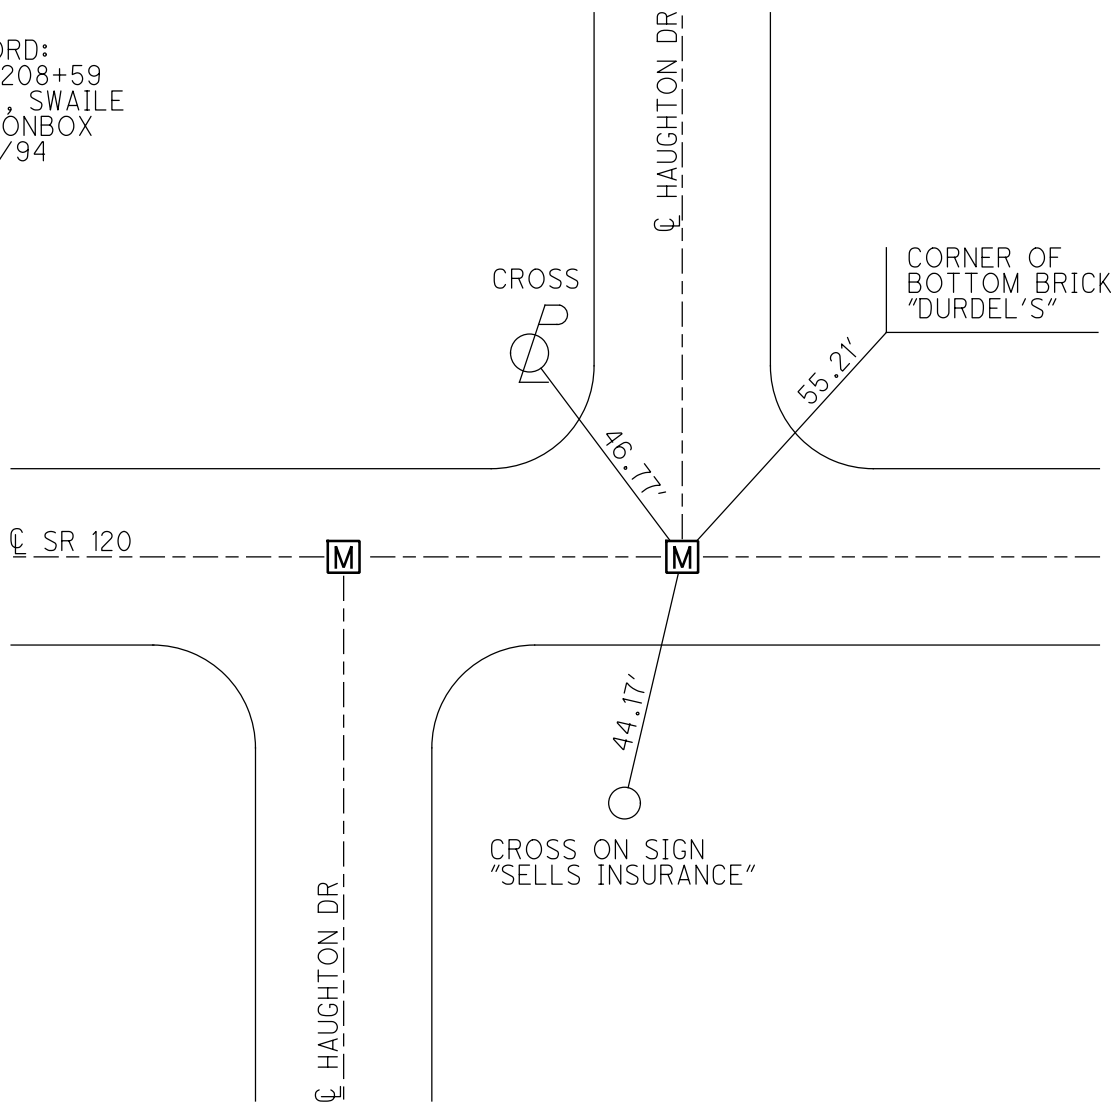

MONUMENT REFERENCE

LOCATION


Central @ Houghton

ATLAS No. _____

SEC. _____

MON. BOX # 207+88 N 208+59

TOWN _____ RANGE _____

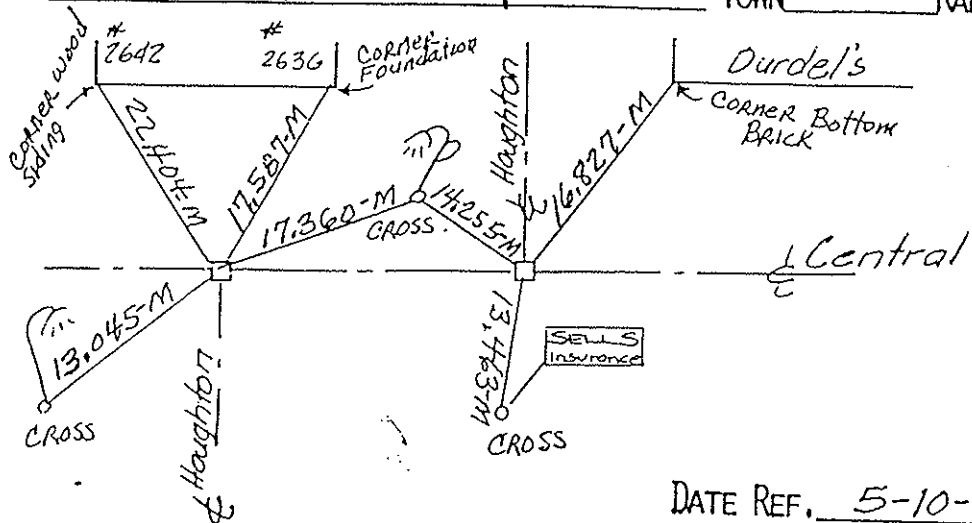

DATE REF. 5-10-94

PERSONNEL	TITLE	PERSONNEL	TITLE
SWAILE	LL		
WARNKA	TK		
MALAK	/		

PROJECT CENTRAL AVE DATE 2-94
 SECOR TO JACKMAN
 PROJECT LIMITS JACKMAN WEATHER SNOW-RAIN
 FROM STA. _____ TO STA. _____ TEMP _____

DESCRIPTION CONTROL SHEET

