

O.D.O.T. DISTRICT 2 SURVEY OFFICE (USE ONLY)

PERSONNEL

REFERENCE NO. 28

SHEET 3 OF 19

NOTES ALBRIGHT

DATE 10/24/77

ROUTE SR 120

H.C. GRDUZINSKI

WEATHER _____

COUNTY LUCAS

R.C. STUBLESKI

TEMP. 55°

TOWNSHIP CITY OF TOLEDO

SECTION 27

DWG BY NIESE PID _____

T 9 S R 7 E

TYPE MONUMENT CMON W/ HOLE

ON SURFACE - BELOW _____


OFFSET ☑ PAVEMENT _____ LT : RT

_____ TO _____ EDGE PAVEMENT


STATION: 818+40

HORZ. DATUM: _____ GEOID: _____

GRID: NORTHING: _____ EASTING: _____

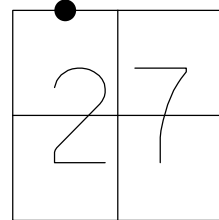

RECORD:
FD CMON
W/ HOLE IN CENTER
10/24/77, ALBRIGHT

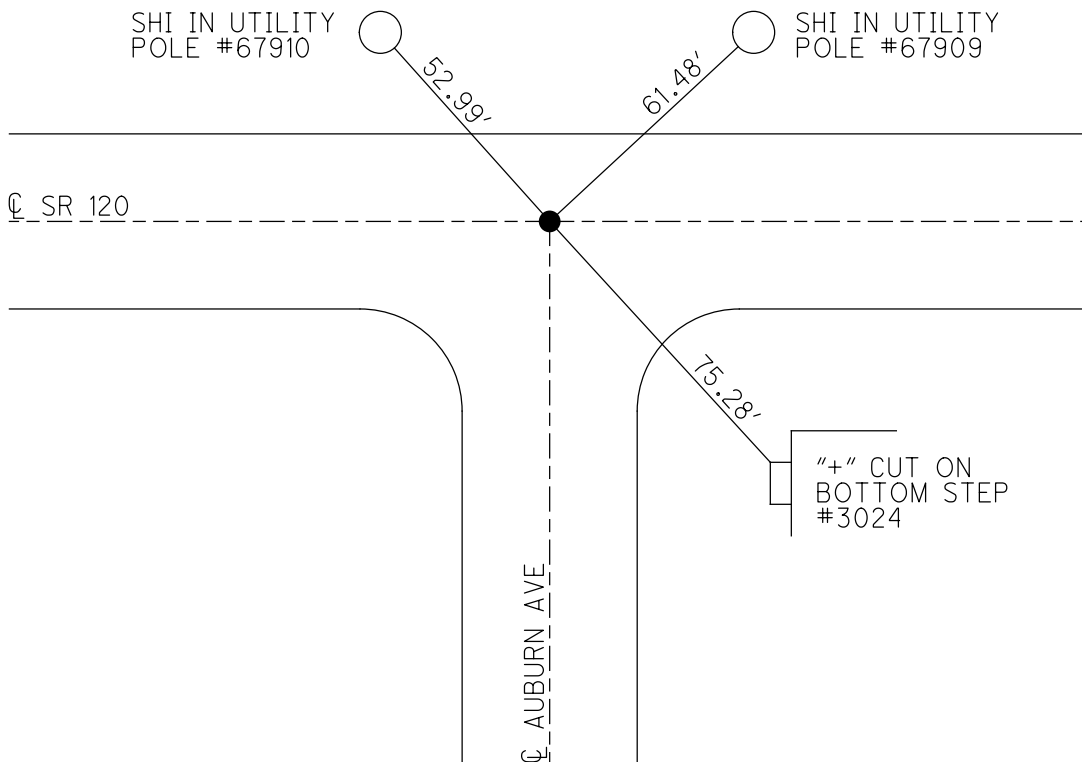

PERSONNEL Albright TITLE _____ PERSONNEL _____ TITLE _____ PROJECT _____ DATE 10/24/77

Grudzinski _____ PROJECT LIMITS _____ WEATHER _____

Stubteski _____ FROM STA. _____ TO STA. _____ TEMP 55°

DESCRIPTION MONUMENT REF. CENTRAL AVE - JACKMAN TO CHERRY

