

O.D.O.T. DISTRICT 2 SURVEY OFFICE (USE ONLY)

PERSONNEL _____

REFERENCE NO. 30

SHEET 5 OF 19

NOTES ALBRIGHT

DATE 10/24/77

ROUTE SR 120

H.C. GRDUZINSKI

WEATHER _____

COUNTY LUCAS

R.C. STUBLESKI

TEMP. 55°

TOWNSHIP CITY OF TOLEDO

DWG BY NIESE PID _____

SECTION 26

T 9 S R 7 E

TYPE MONUMENT CMON IN BOX W/ LEAD PLUG

ON SURFACE - ~~BELOW~~ ON

OFFSET \varnothing PAVEMENT _____ LT : RT

_____ TO _____ EDGE PAVEMENT


STATION: 868+03

HORIZ.DATUM: _____


GEOID: _____

GRID: NORTHING: _____

EASTING: _____

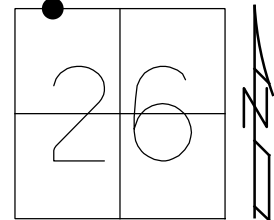

RECORD:
FD CMON IN BOX
W/ BRASS PLUG
10/24/77, ALBRIGHT

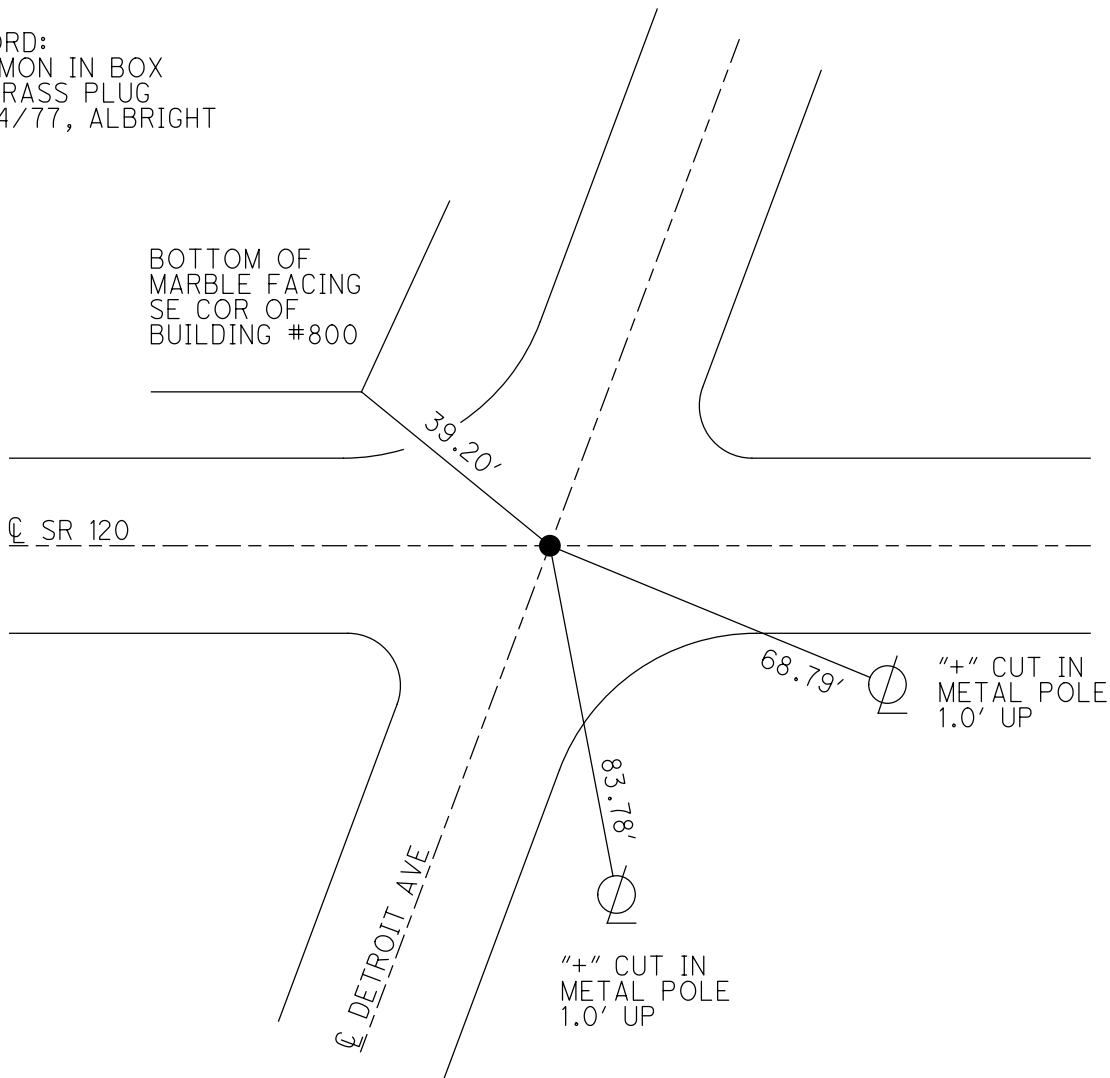

PERSONNEL	TITLE	PERSONNEL	TITLE
Albright			
Grduzinski			
Stableski			

PROJECT _____ DATE 10/24/77

PROJECT LIMITS _____ WEATHER _____

FROM STA. _____ TO STA. _____ TEMP 55°

DESCRIPTION MONUMENT REF. CENTRAL AVE - JACKMAN TO CHERRY

