

O.D.O.T. DISTRICT 2 SURVEY OFFICE (USE ONLY)

PERSONNEL _____ REFERENCE NO. 33 SHEET 8 OF 19

NOTES MENNITL DATE 1977 ROUTE SR 120

H.C. GRDUZINSKI WEATHER _____ COUNTY LUCAS

R.C. STUBLESKI TEMP. _____ TOWNSHIP CITY OF TOLEDO

DWG BY NIESE PID _____ SECTION 26
T 9 S R 7 E

TYPE MONUMENT MONBOX


ON SURFACE - ~~BELOW~~ ON

OFFSET \bar{C} PAVEMENT _____ LT : RT
_____ TO _____ EDGE PAVEMENT


STATION: 879+12

HORZ. DATUM: _____ GEOID: _____

GRID: NORTHING: _____ EASTING: _____

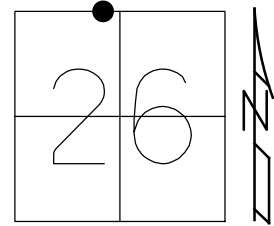

RECORD:
FD MONBOX
MENNITL

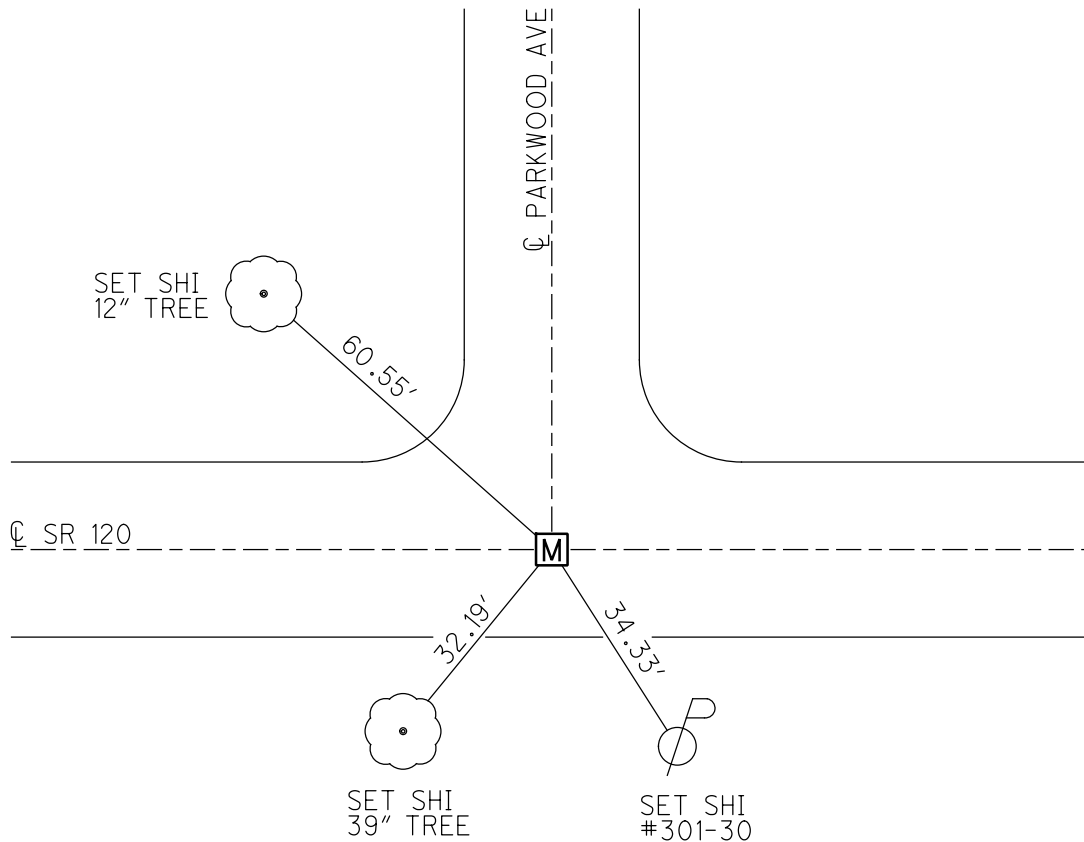

PERSONNEL TITLE PERSONNEL TITLE PROJECT _____ DATE _____

MEINHART _____
GRODZINSKI _____
STURLESKI _____ PROJECT LIMITS _____ WEATHER _____

FROM STA. _____ TO STA. _____ TEMP _____

DESCRIPTION MON. REF. CENTRAL AVE - JACKMAN TO CHERRY

