

O.D.O.T. DISTRICT 2 SURVEY OFFICE (USE ONLY)

PERSONNEL _____

REFERENCE NO. 34

SHEET 9 OF 19

NOTES MENNITL

DATE 1977

ROUTE SR 120

H.C. GRDUZINSKI

WEATHER _____

COUNTY LUCAS

R.C. STUBLESKI

TEMP. _____

TOWNSHIP CITY OF TOLEDO

DWG BY NIESE PID _____

SECTION 26

T 9 S R 7 E

TYPE MONUMENT MONBOX

ON SURFACE - ~~BELOW~~ ON


OFFSET \odot PAVEMENT _____ LT : RT

_____ TO _____ EDGE PAVEMENT


STATION: 884+93

HORZ. DATUM: _____ GEOID: _____

GRID: NORTHING: _____ EASTING: _____

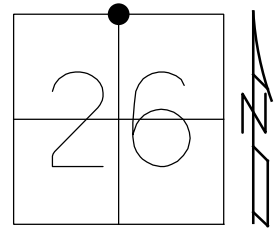

RECORD:
FD MONBOX
MENNITL

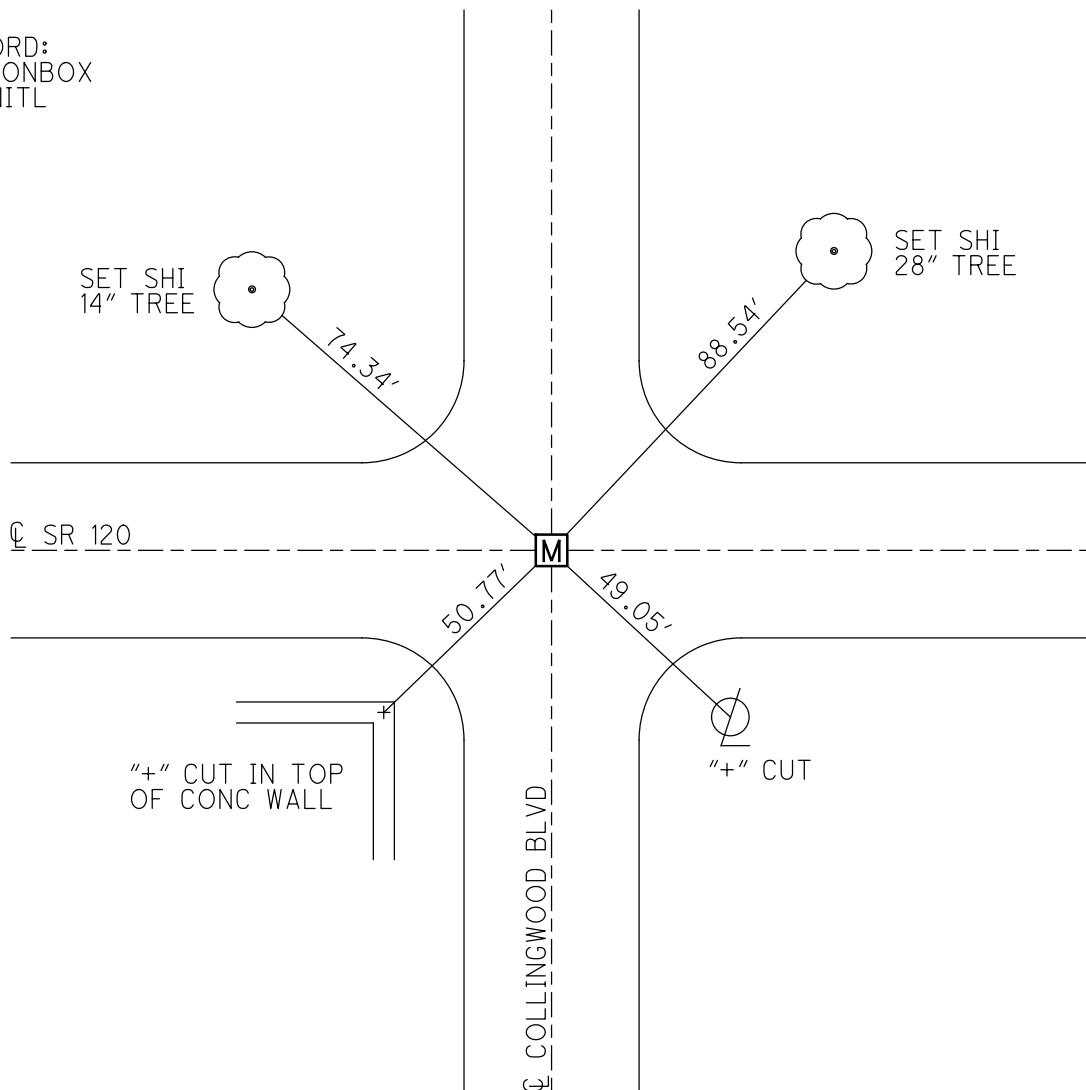

PERSONNEL	TITLE	PERSONNEL	TITLE	PROJECT	DATE
<u>MEINHART</u>	_____	_____	_____	_____	_____
<u>GRODZINSKI</u>	_____	_____	_____	PROJECT LIMITS	WEATHER
<u>STURLESKI</u>	_____	_____	_____	_____	_____

FROM STA. _____ TO STA. _____ TEMP. _____

DESCRIPTION MON. REF. CENTRAL AVE - JACKMAN TO CHERRY

