

O.D.O.T. DISTRICT 2 SURVEY OFFICE (USE ONLY)

PERSONNEL _____

REFERENCE NO. 39

SHEET 15 OF 19

NOTES TOMSIK

DATE 9/15/72

ROUTE SR 120

H.C. NEUSER

WEATHER _____

COUNTY LUCAS

R.C. VANYO
GRANATA

TEMP. _____

TOWNSHIP CITY OF TOLEDO

DWG BY NIESE PID _____

SECTION 24

T 9 S R 7 E

TYPE MONUMENT P.K. NAIL

ON SURFACE - BELOW _____

OFFSET ϕ PAVEMENT _____ LT : RT

_____ TO _____ EDGE PAVEMENT


STATION: 936+14

HORIZ.DATUM: _____


GEOID: _____

GRID: NORTHING: _____

EASTING: _____

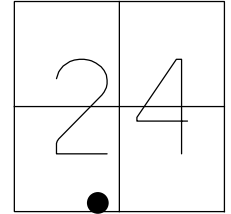

RECORD:
FD P.K. NAIL
9/15/72, TOMSIK

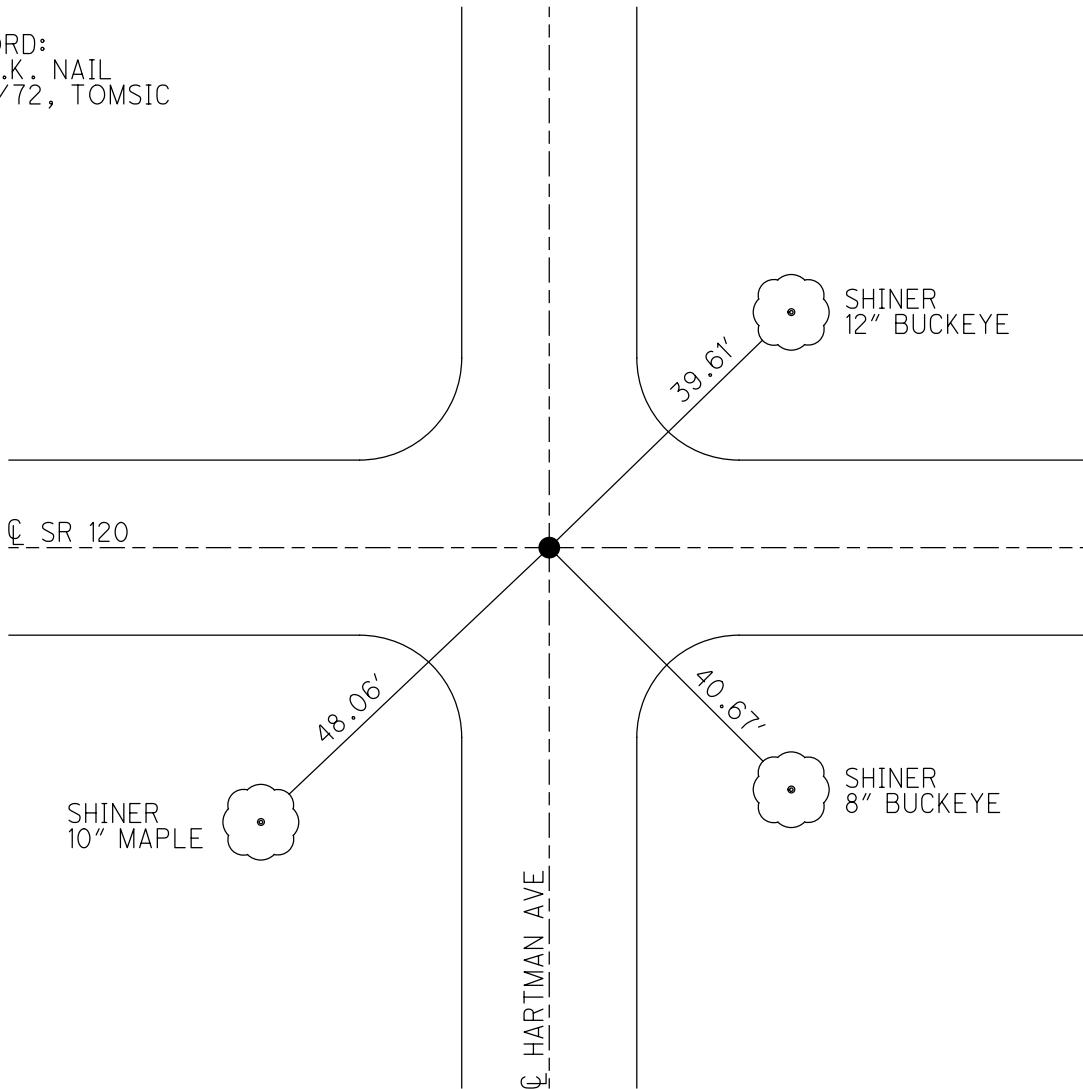

PERSONNEL TITLE PERSONNEL TITLE COUNTY Lucas DATE Sept. 15, 1972
 PERSONNEL TITLE PERSONNEL TITLE S. R. U.S. 120 WEATHER
 PERSONNEL TITLE PERSONNEL TITLE SEC. Central Ave TEMP.
 DESCRIPTION Central Ave. **TOLDO** JOB NO.

