

O.D.O.T. DISTRICT 2 SURVEY OFFICE (USE ONLY)

PERSONNEL _____

REFERENCE NO. 40

SHEET 16 OF 19

NOTES TOMSIK

DATE 9/15/72

ROUTE SR 120

H.C. NEUSER

WEATHER _____

COUNTY LUCAS

R.C. VANYO
GRANATA

TEMP. _____

TOWNSHIP CITY OF TOLEDO

DWG BY NIESE

PID _____

SECTION 24

T 9 S R 7 E

TYPE MONUMENT P.K. NAIL

ON SURFACE - BELOW _____

OFFSET \varnothing PAVEMENT _____ LT : RT

_____ TO _____ EDGE PAVEMENT


STATION: 941+42

HORZ. DATUM: _____


GEOID: _____

GRID: NORTHING: _____

EASTING: _____

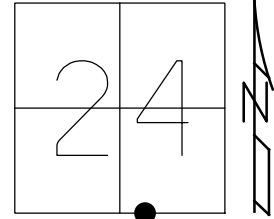

RECORD:
FD P.K. NAIL
9/15/72, TOMSIK

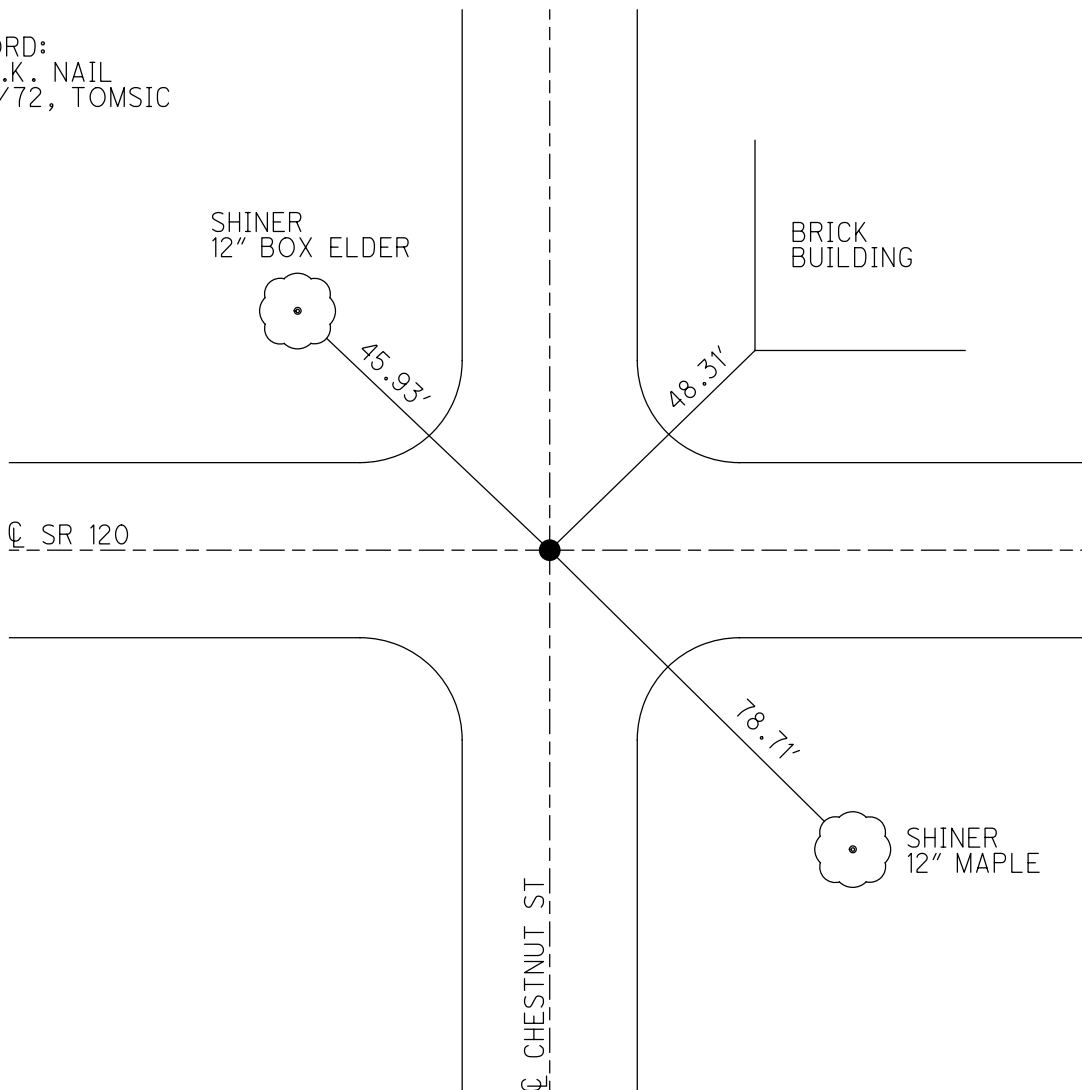

PERSONNEL TITLE PERSONNEL TITLE COUNTY Lucas DATE Sept. 15, 1972

Tomsio _____
 Neuser _____
 Vanyo _____
 Granata _____

S. R. U.S. 120 WEATHER _____
 SEC. Central Ave TEMP. _____
 DESCRIPTION Central Ave. **TOLDO** JOB NO. _____

