

O.D.O.T. DISTRICT 2 SURVEY OFFICE (USE ONLY)

PERSONNEL \_\_\_\_\_

REFERENCE NO. 41

SHEET 17 OF 19

NOTES TOMSIK

DATE 9/14/72

ROUTE SR 120

H.C. NEUSER

WEATHER \_\_\_\_\_

COUNTY LUCAS

R.C. VANYO

TEMP. \_\_\_\_\_

TOWNSHIP CITY OF TOLEDO

GRANATA

SECTION 24

DWG BY NIESE PID \_\_\_\_\_

T 9 S R 7 E

TYPE MONUMENT IRON BOLT

ON SURFACE - BELOW \_\_\_\_\_


OFFSET  $\text{C}$  PAVEMENT \_\_\_\_\_ LT : RT

\_\_\_\_\_ TO \_\_\_\_\_ EDGE PAVEMENT


STATION: 947+23

HORIZ.DATUM: \_\_\_\_\_ GEOID: \_\_\_\_\_

GRID: NORTHING: \_\_\_\_\_ EASTING: \_\_\_\_\_

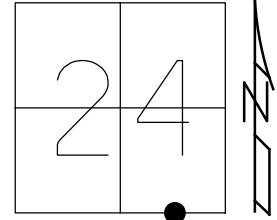

RECORD:  
FD IRON BOLT  
9/14/72, TOMSIK

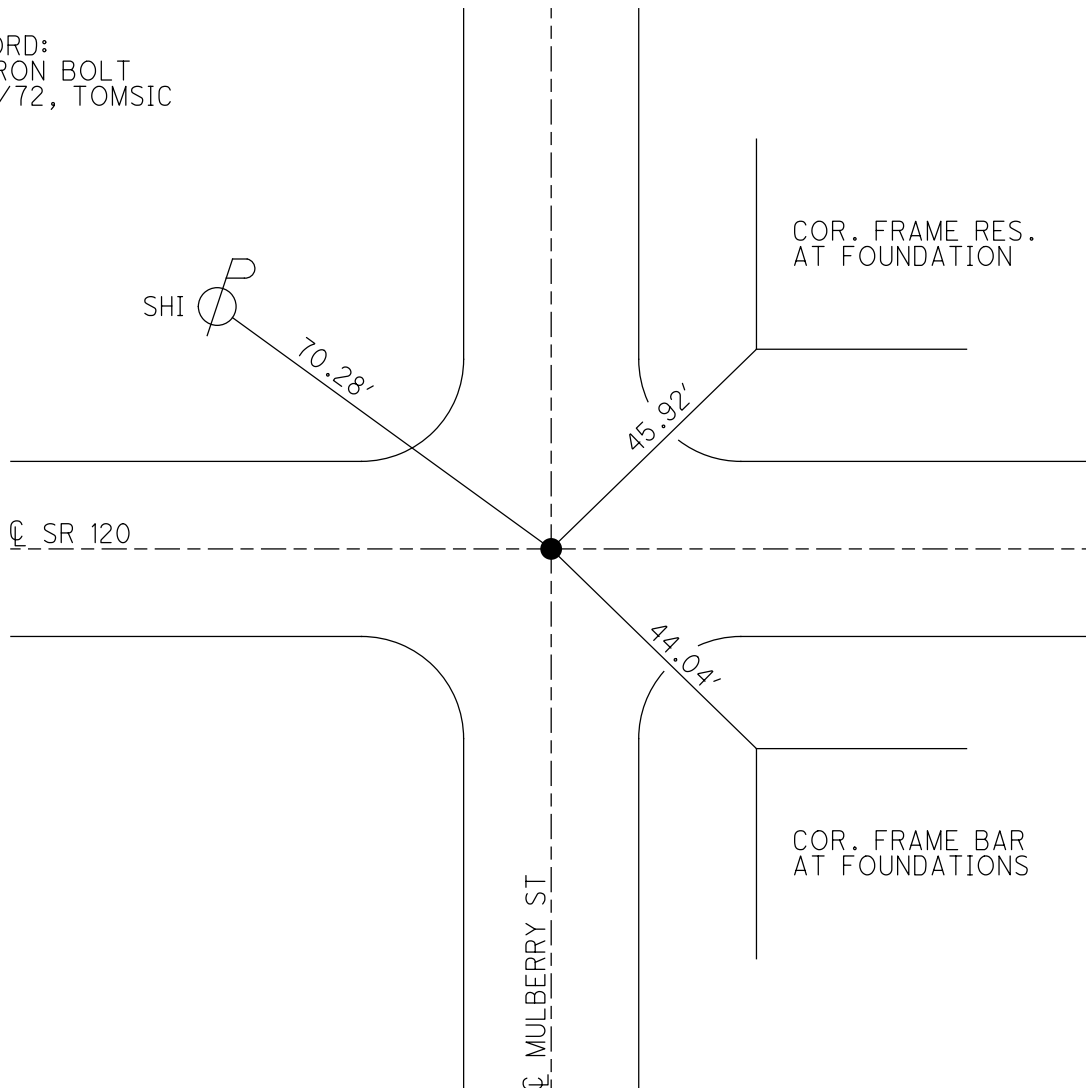

PERSONNEL	TITLE	PERSONNEL	TITLE	COUNTY	DATE
Tomsic				Lucas	Sept. 14, 1972
Neuser				S. R. U.S. 120	WEATHER
Vanyo				SEC. Central Ave	TEMP.
Granata					

DESCRIPTION Central Ave **TOLEDO** JOB NO. \_\_\_\_\_

