

O.D.O.T. DISTRICT 2 SURVEY OFFICE (USE ONLY)

PERSONNEL _____

REFERENCE NO. 43

SHEET 19 OF 19

NOTES TOMSIK

DATE 9/14/72

ROUTE SR 120

H.C. NEUSER

WEATHER _____

COUNTY LUCAS

R.C. VANYO

TEMP. _____

TOWNSHIP CITY OF TOLEDO

GRANATA

SECTION 24

DWG BY NIESE PID _____

T 9 S R 7 E

TYPE MONUMENT CMON

ON SURFACE - BELOW _____


OFFSET $\text{\textcircled{C}}$ PAVEMENT _____ LT : RT

_____ TO _____ EDGE PAVEMENT


STATION: 960+96

HORZ. DATUM: _____ GEOID: _____

GRID: NORTHING: _____ EASTING: _____

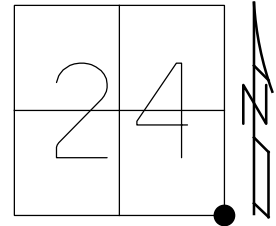

RECORD:
FD CMON
9/14/72, TOMSIK

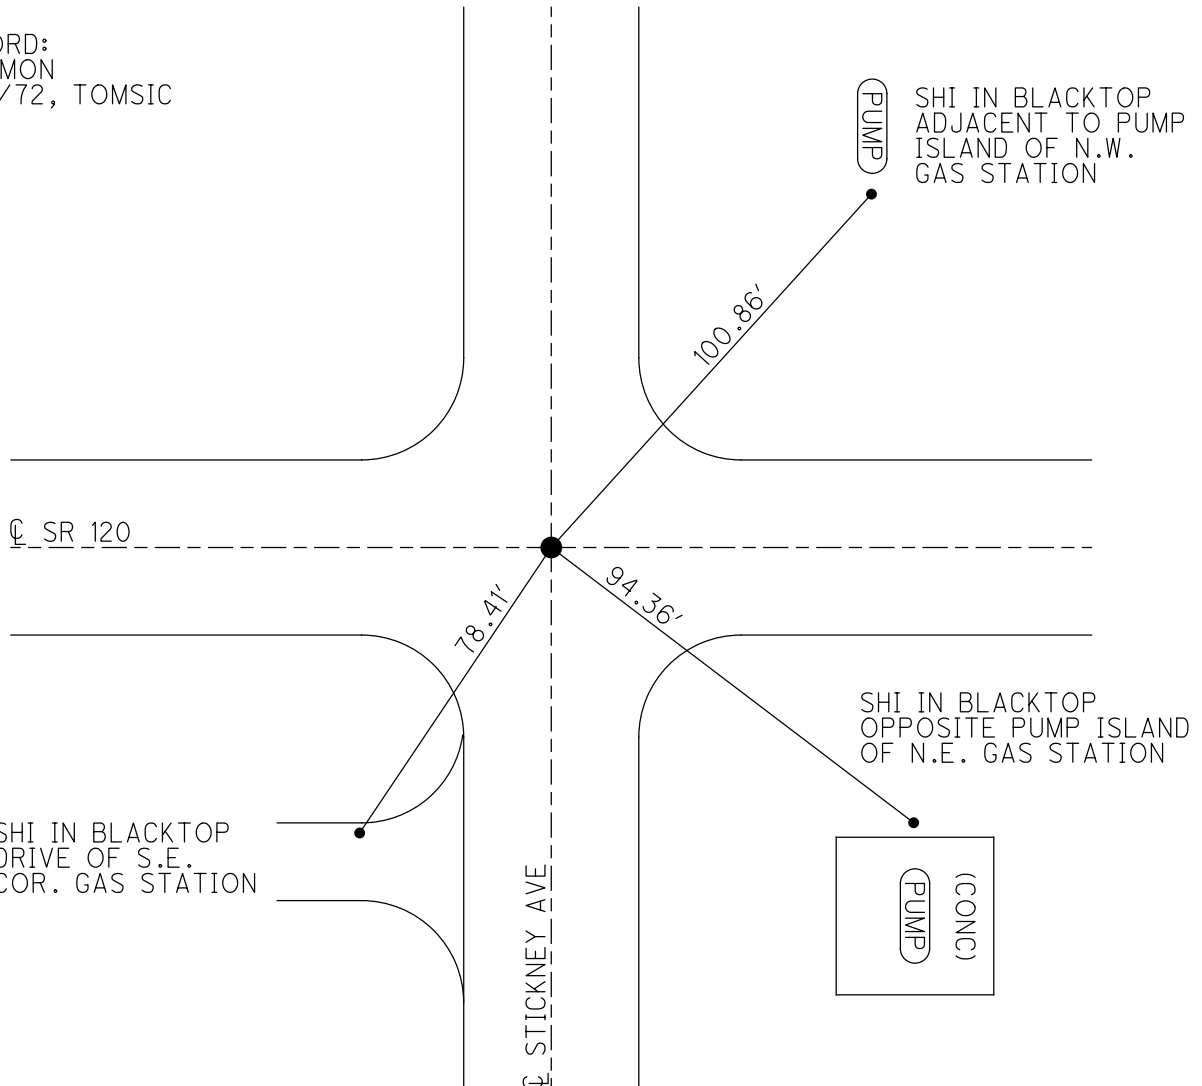

PERSONNEL TITLE PERSONNEL TITLE COUNTY Lucas DATE Sept. 14, 1972

Tomsic _____

Newser _____

Vanyo _____

Granata _____

S. R. U.S. 120 WEATHER _____

SEC. Central Ave TEMP. _____

DESCRIPTION Central Ave TOLEDO JOB NO. _____

