


FOR ANY QUESTIONS PLEASE CONTACT ODOT DISTRICT 2 REAL ESTATE AT 419-353-8131

Survey
July 1997


SEC II SYLVANIA TWP T9S R6E

LUCAS COUNTY	
SH.980, SEC SYLVANIA (PT) & F (PT)	
R/W PLANS	
DATE	DRAWN BY
REVISED	
LENGTH OF PROJECT	

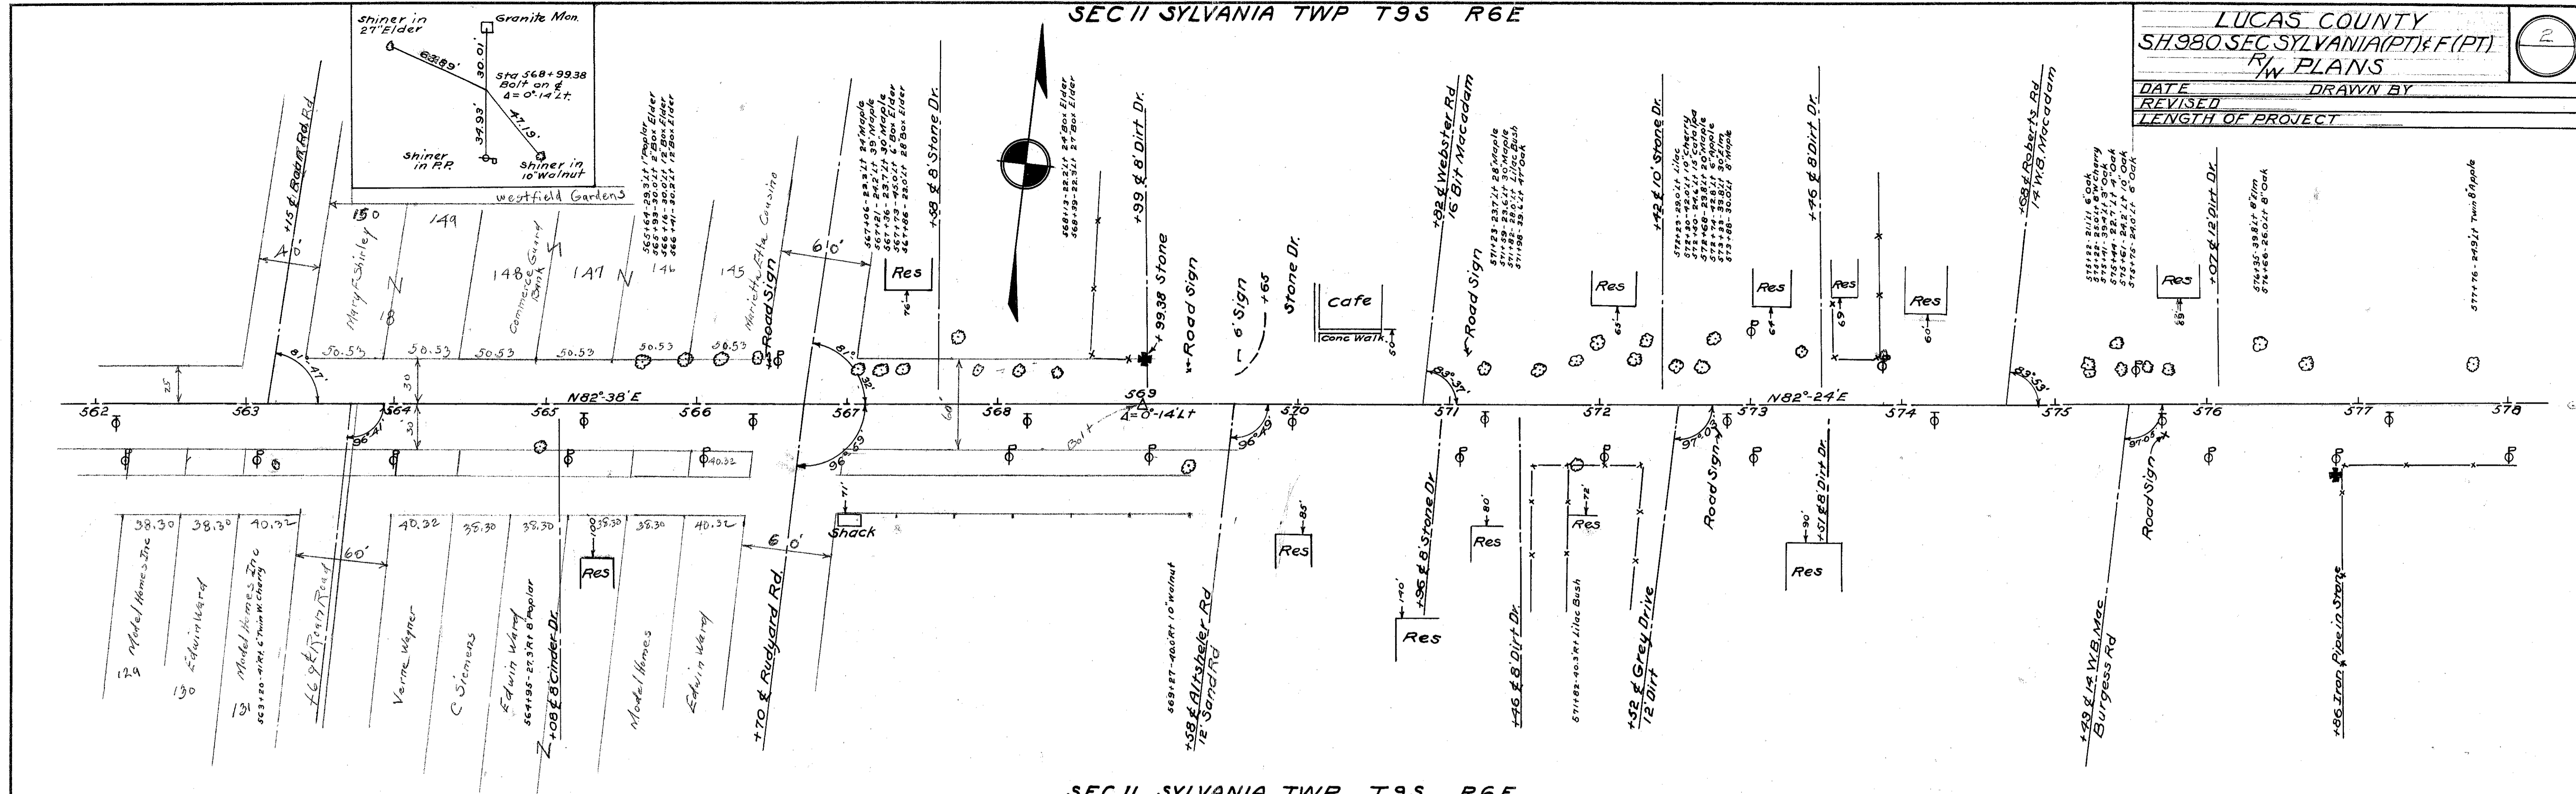

SEC II SYLVANIA TWP T9S R6E

SEC II SYLVANIA TWP T9S R6E

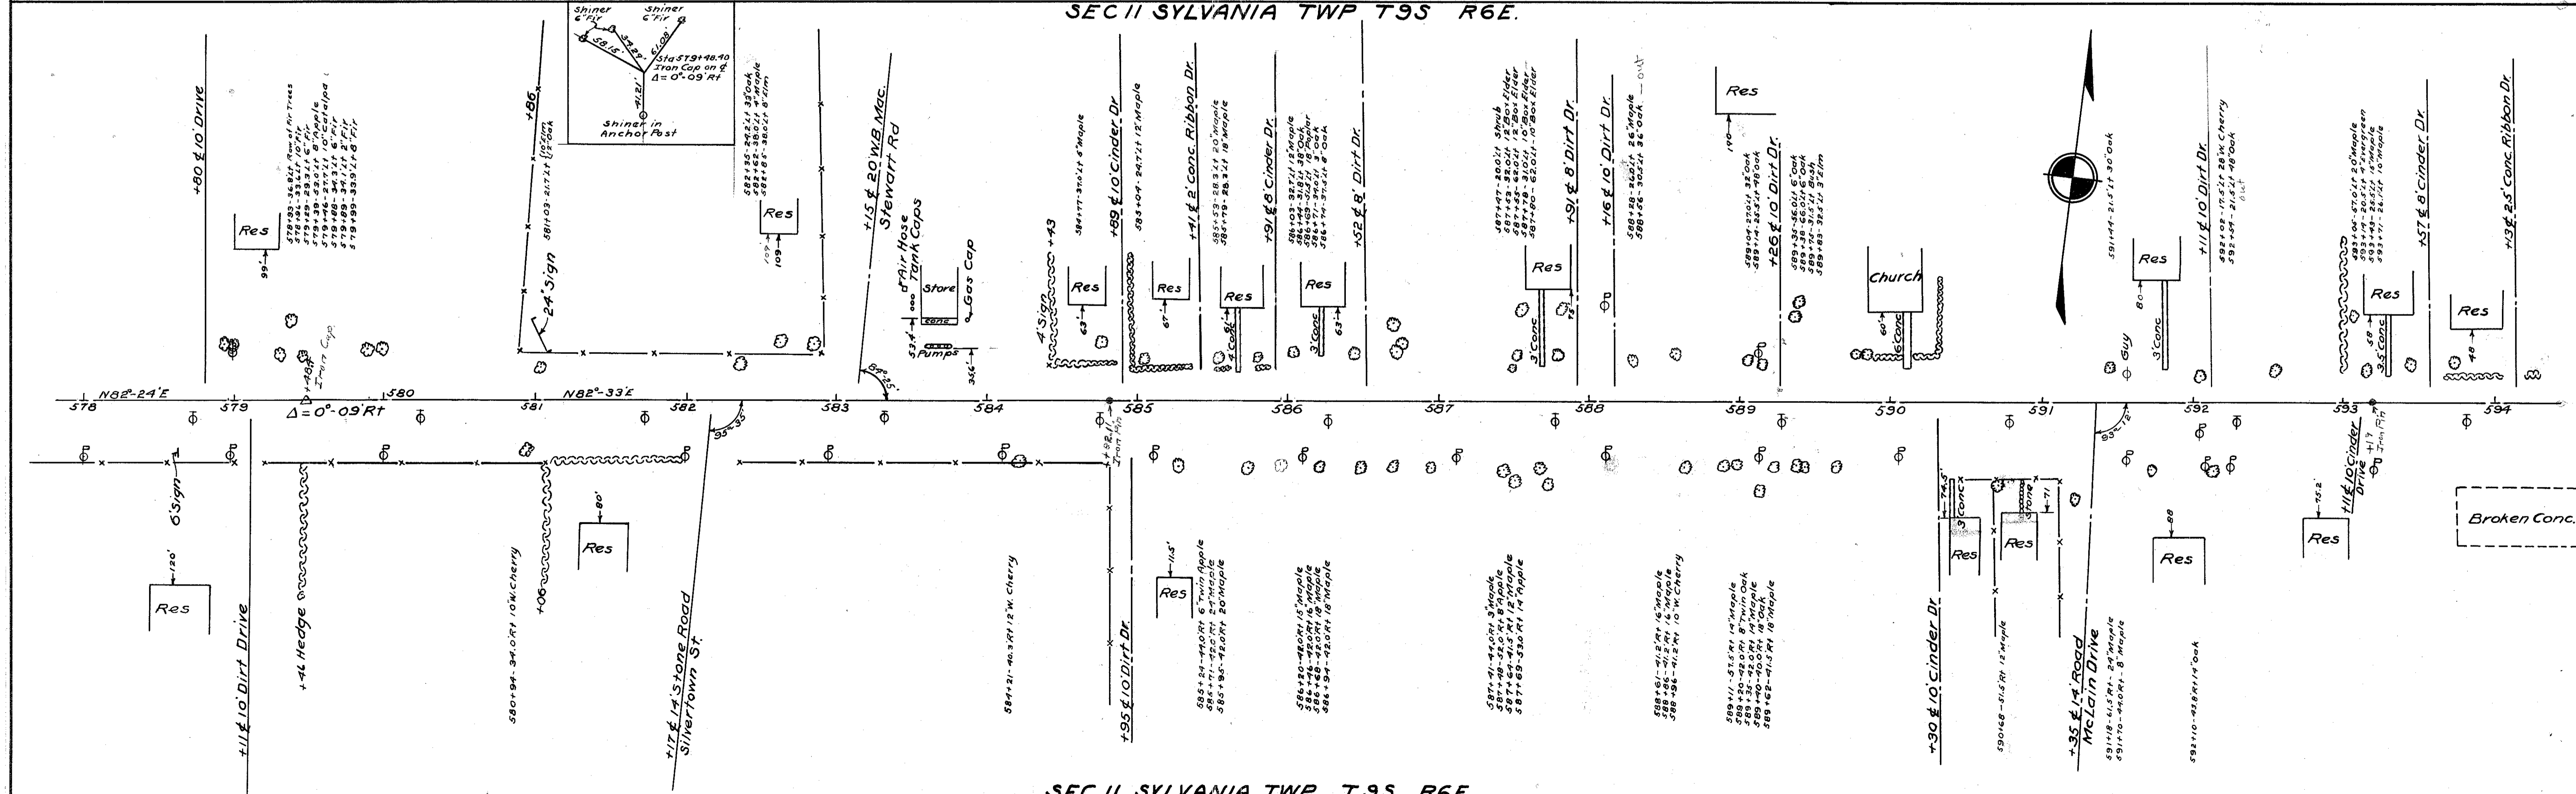

SEC II SYLVANIA TWP T9S R6E


FOR ANY QUESTIONS PLEASE CONTACT ODOT DISTRICT 2 REAL ESTATE AT 419-353-8131

SEC II SYLVANIA TWP. T9S. R6E

SEC 12 SYLVANIA TWP. T9S. R6E


LUCAS COUNTY
S.H.980 SEC. SYLVANIA (PT) & F (PT)
R/W PLANS

DATE _____ DRAWN BY _____
REVISED _____
LENGTH OF PROJECT _____

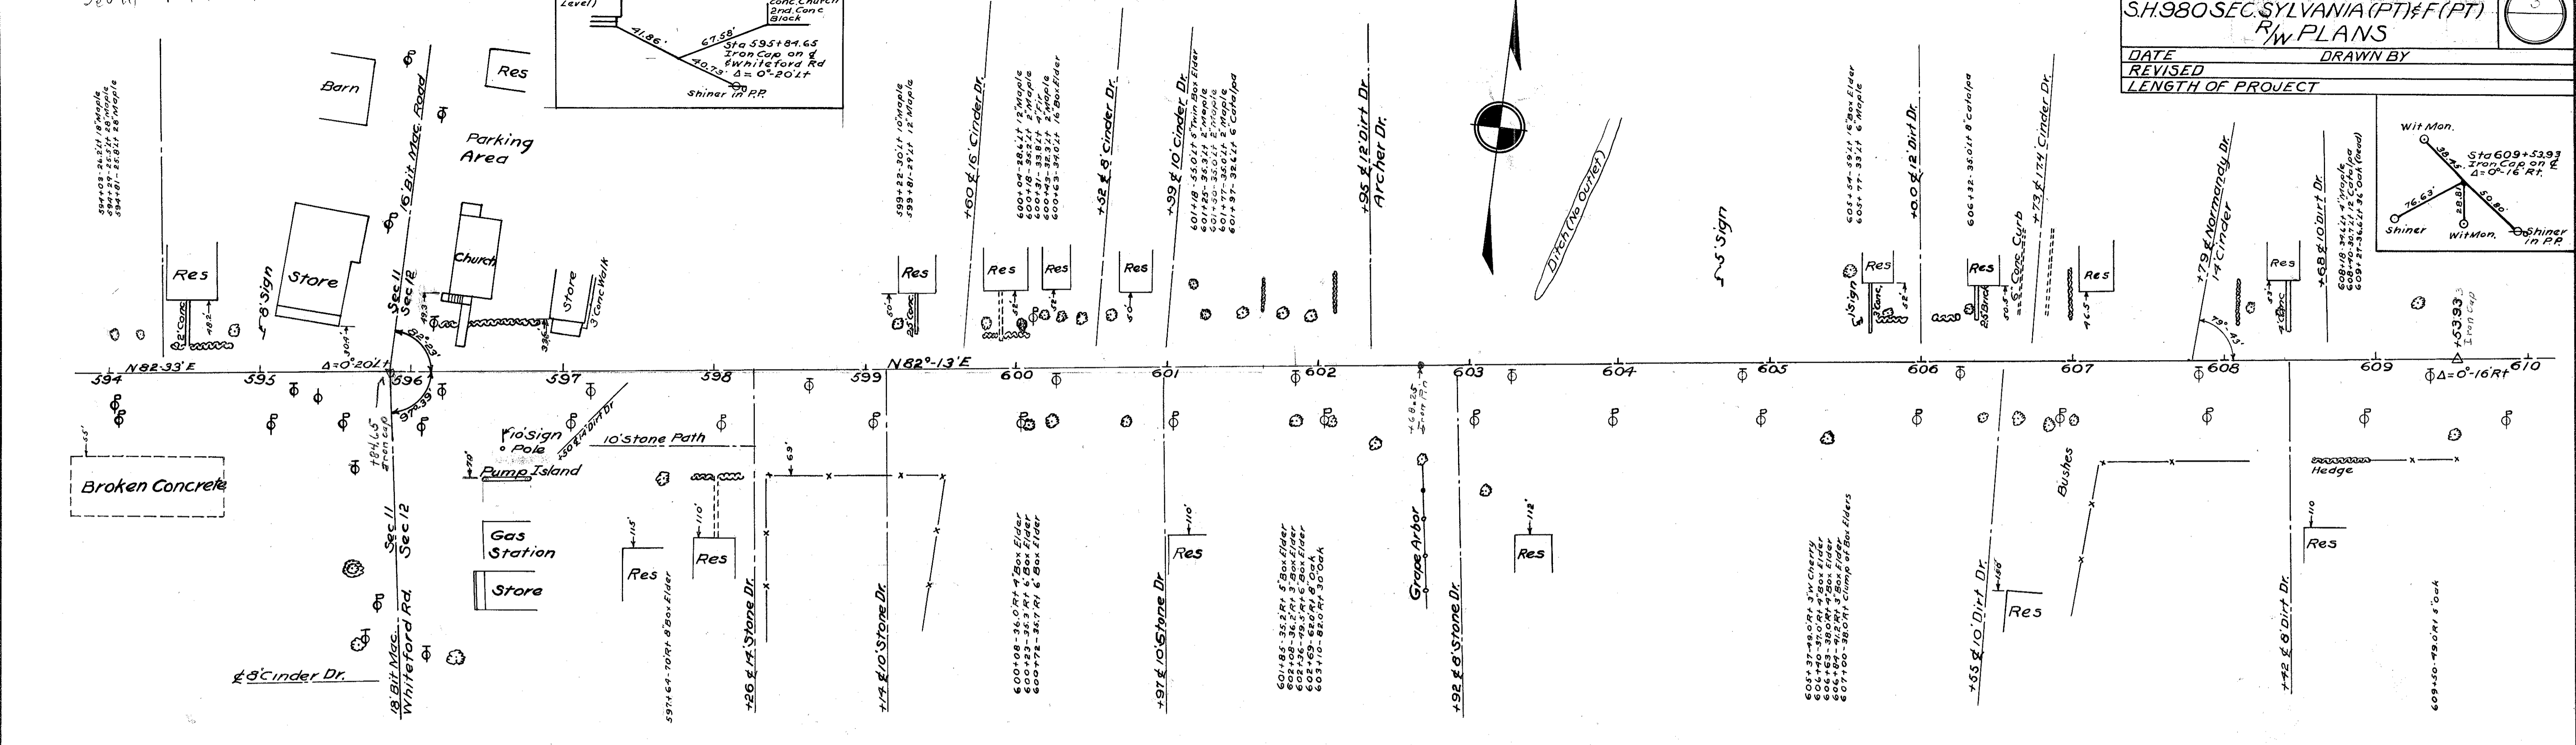

SEC II SYLVANIA TWP. T9S. R6E

SEC 12 SYLVANIA TWP. T9S. R6E
SEC 12 SYLVANIA TWP. T9S. R6E

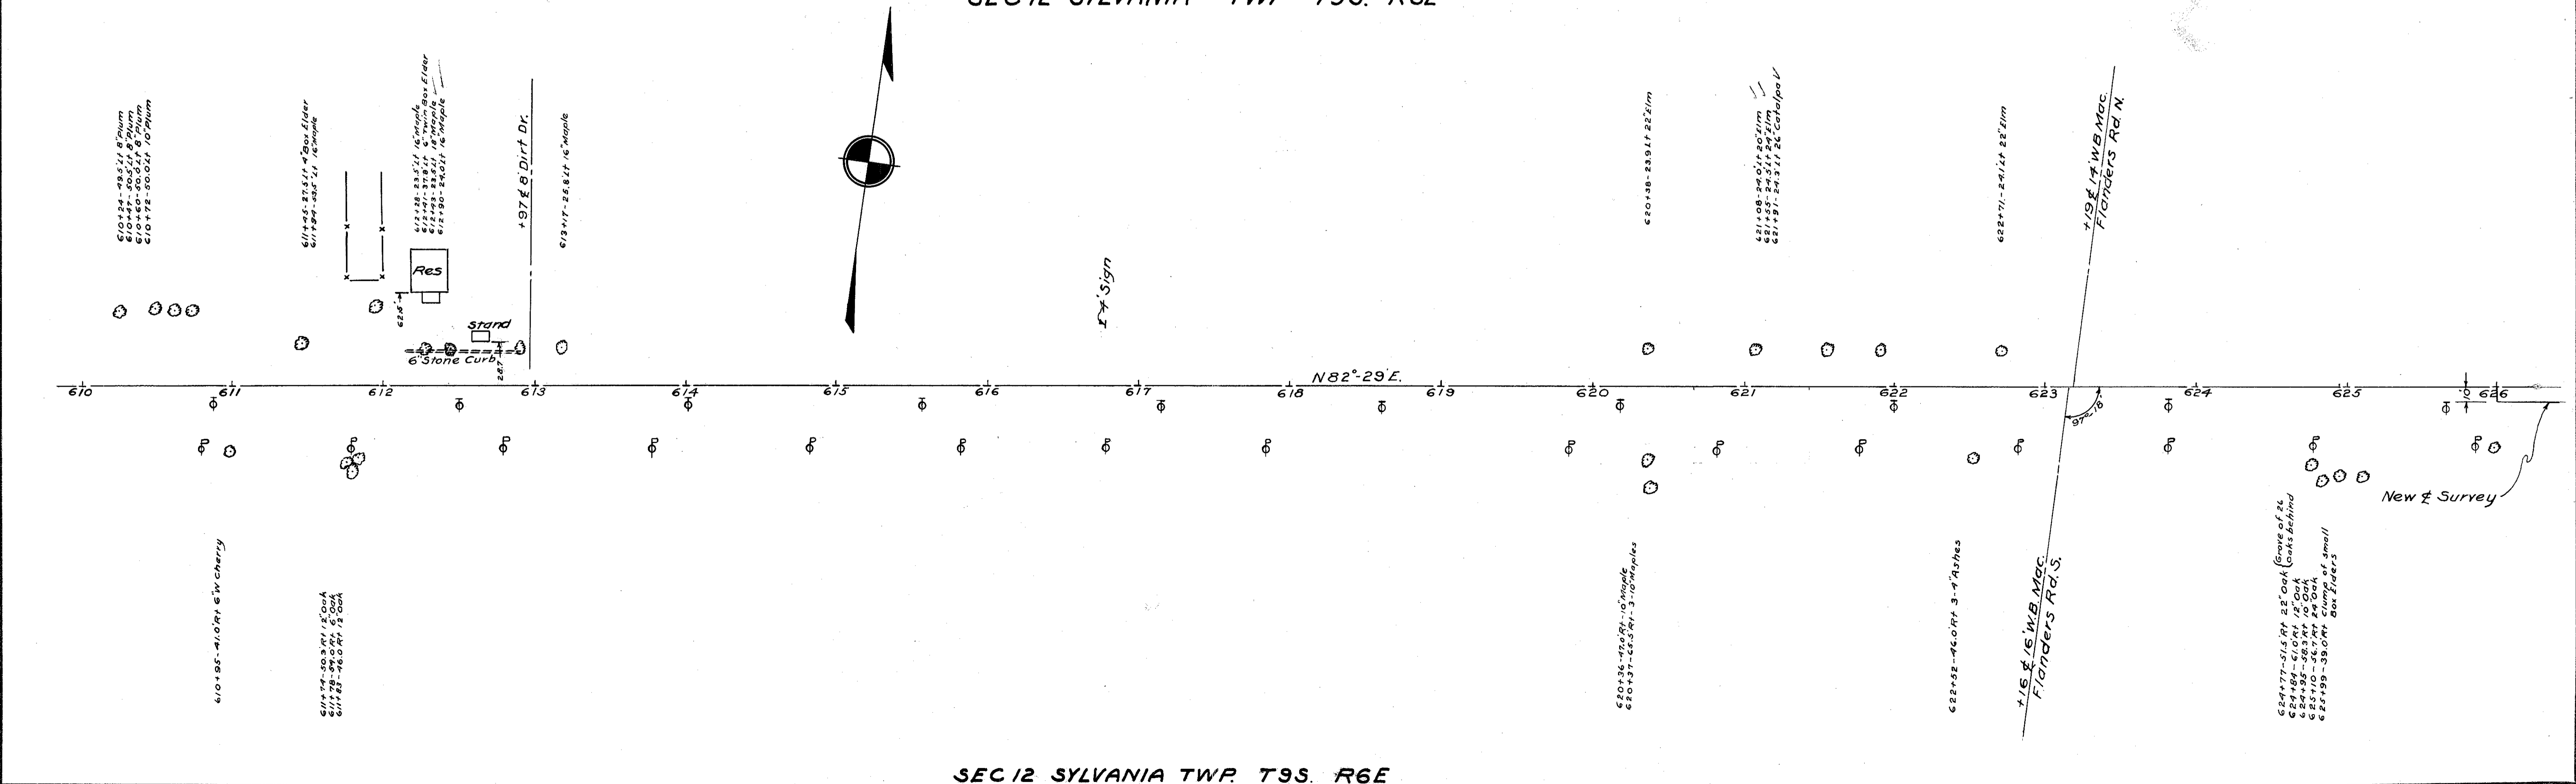

SEC 12 SYLVANIA TWP. T9S. R6E

FOR ANY QUESTIONS PLEASE CONTACT ODOT DISTRICT 2 REAL ESTATE AT 419-353-8131



Continued July 1987

SEC 12 SYLVANIA TWP T9S. R6E.

SEC 1


LUCAS COUNTY SH.980 SEC.SYLVANIA (PT)&F (PT) R/W PLANS

DATE REVISED DRAWN BY LENGTH OF PROJECT

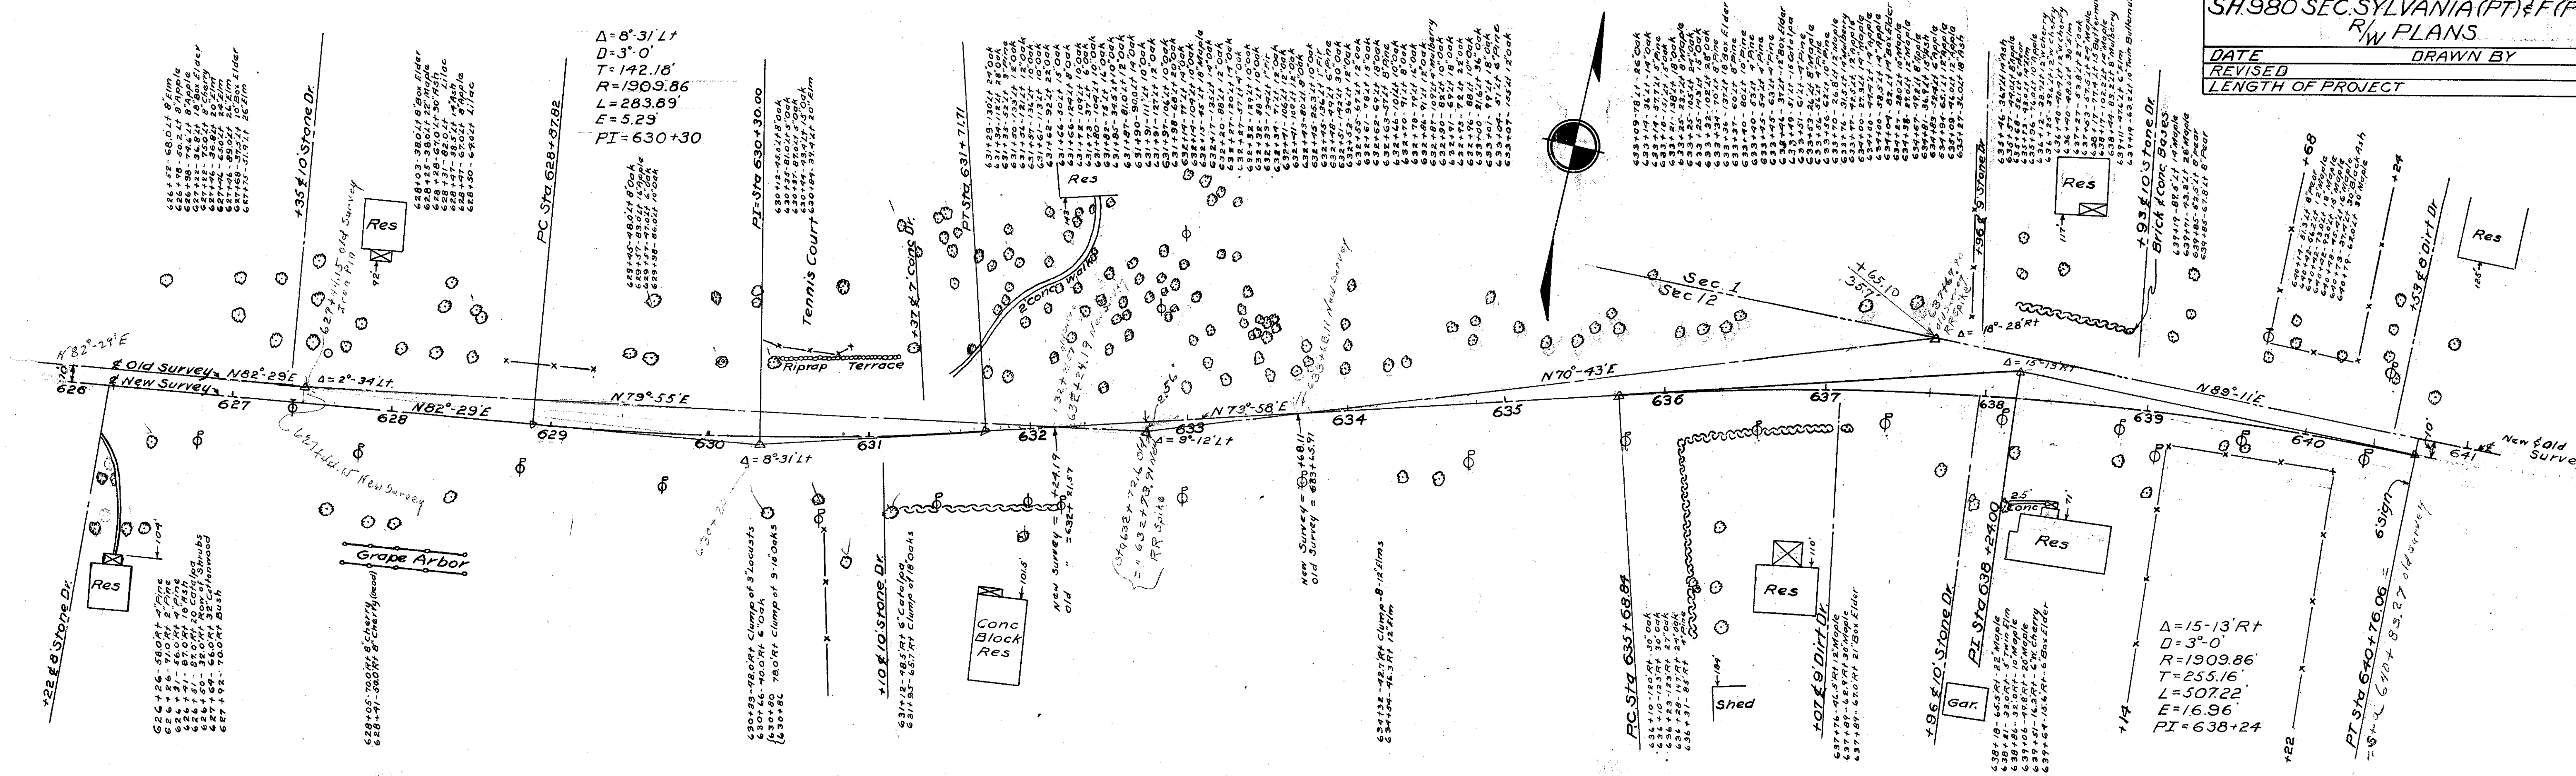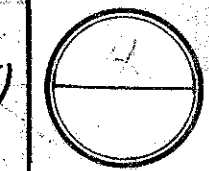

SEC 12 SYLVANIA TWP T9S. R6E
SEC 1 SYLVANIA TWP T9S R6E

SEC 6 WASHINGTON TWP T9S R7E

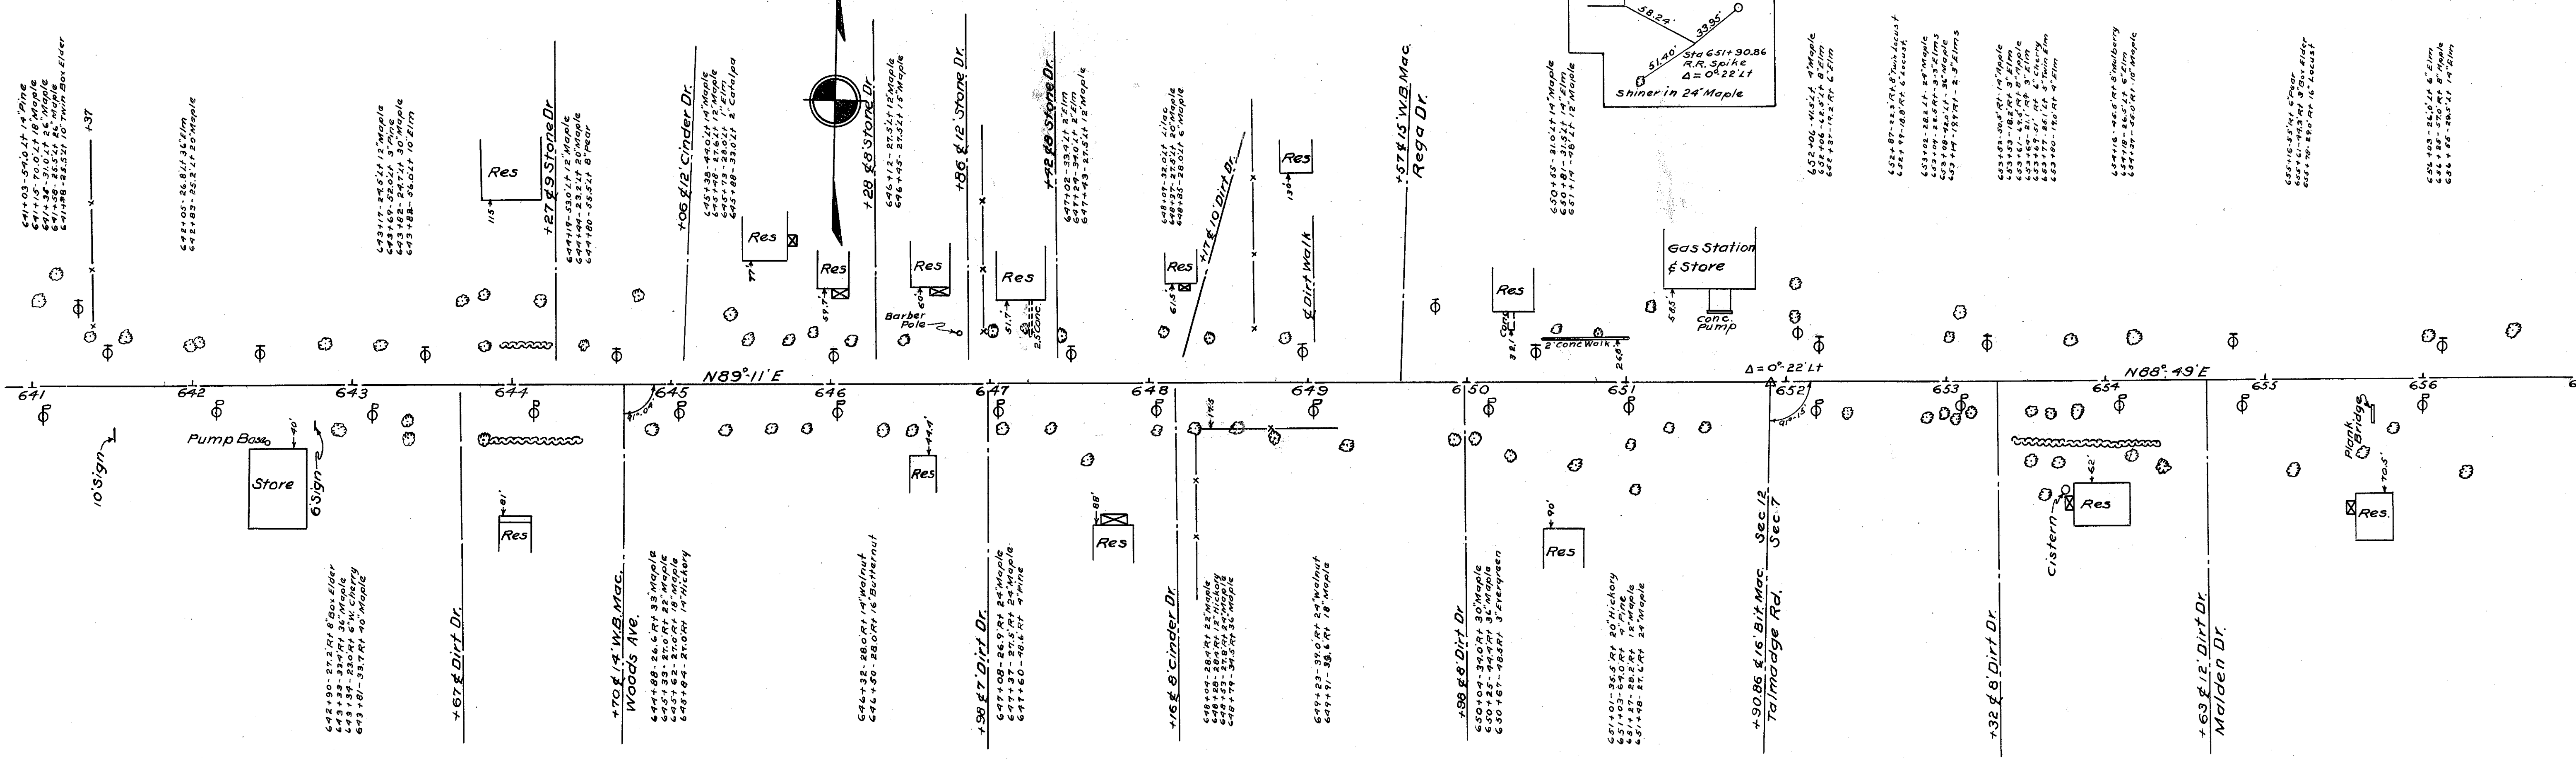

SEC 12 SYLVANIA TWP T9S R6E

SEC 7 WASHINGTON TWP T9S. R7E.


FOR ANY QUESTIONS PLEASE CONTACT ODOT DISTRICT 2 REAL ESTATE AT 419-353-8131

SEC 6 WASHINGTON TWP T9S R7E


LUCAS COUNTY
SH980 SEC. SYLVANIA (PT) & F (PT)
R/W PLANS

5

DATE _____ DRAWN BY _____
REVISED _____
LENGTH OF PROJECT _____

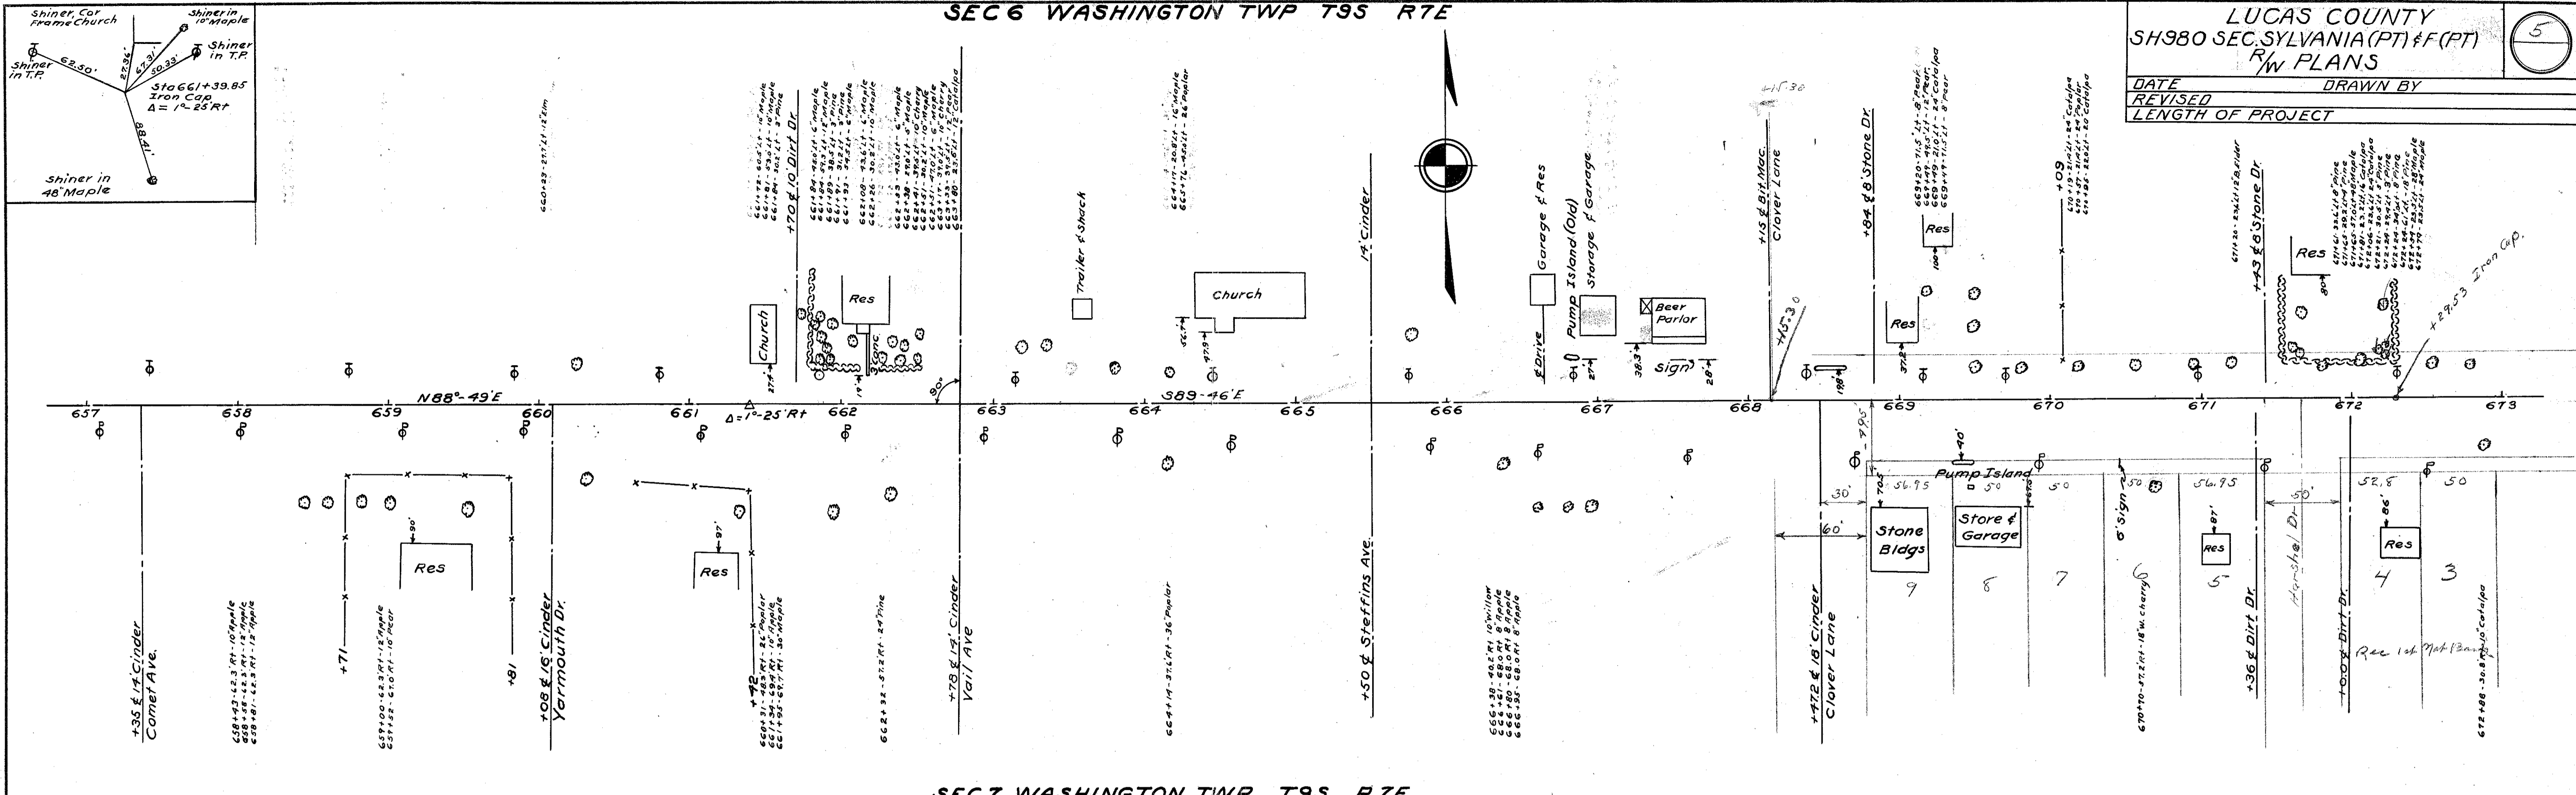

SEC 7 WASHINGTON TWP T9S R7E
SEC 6 WASHINGTON TWP T9S R7E

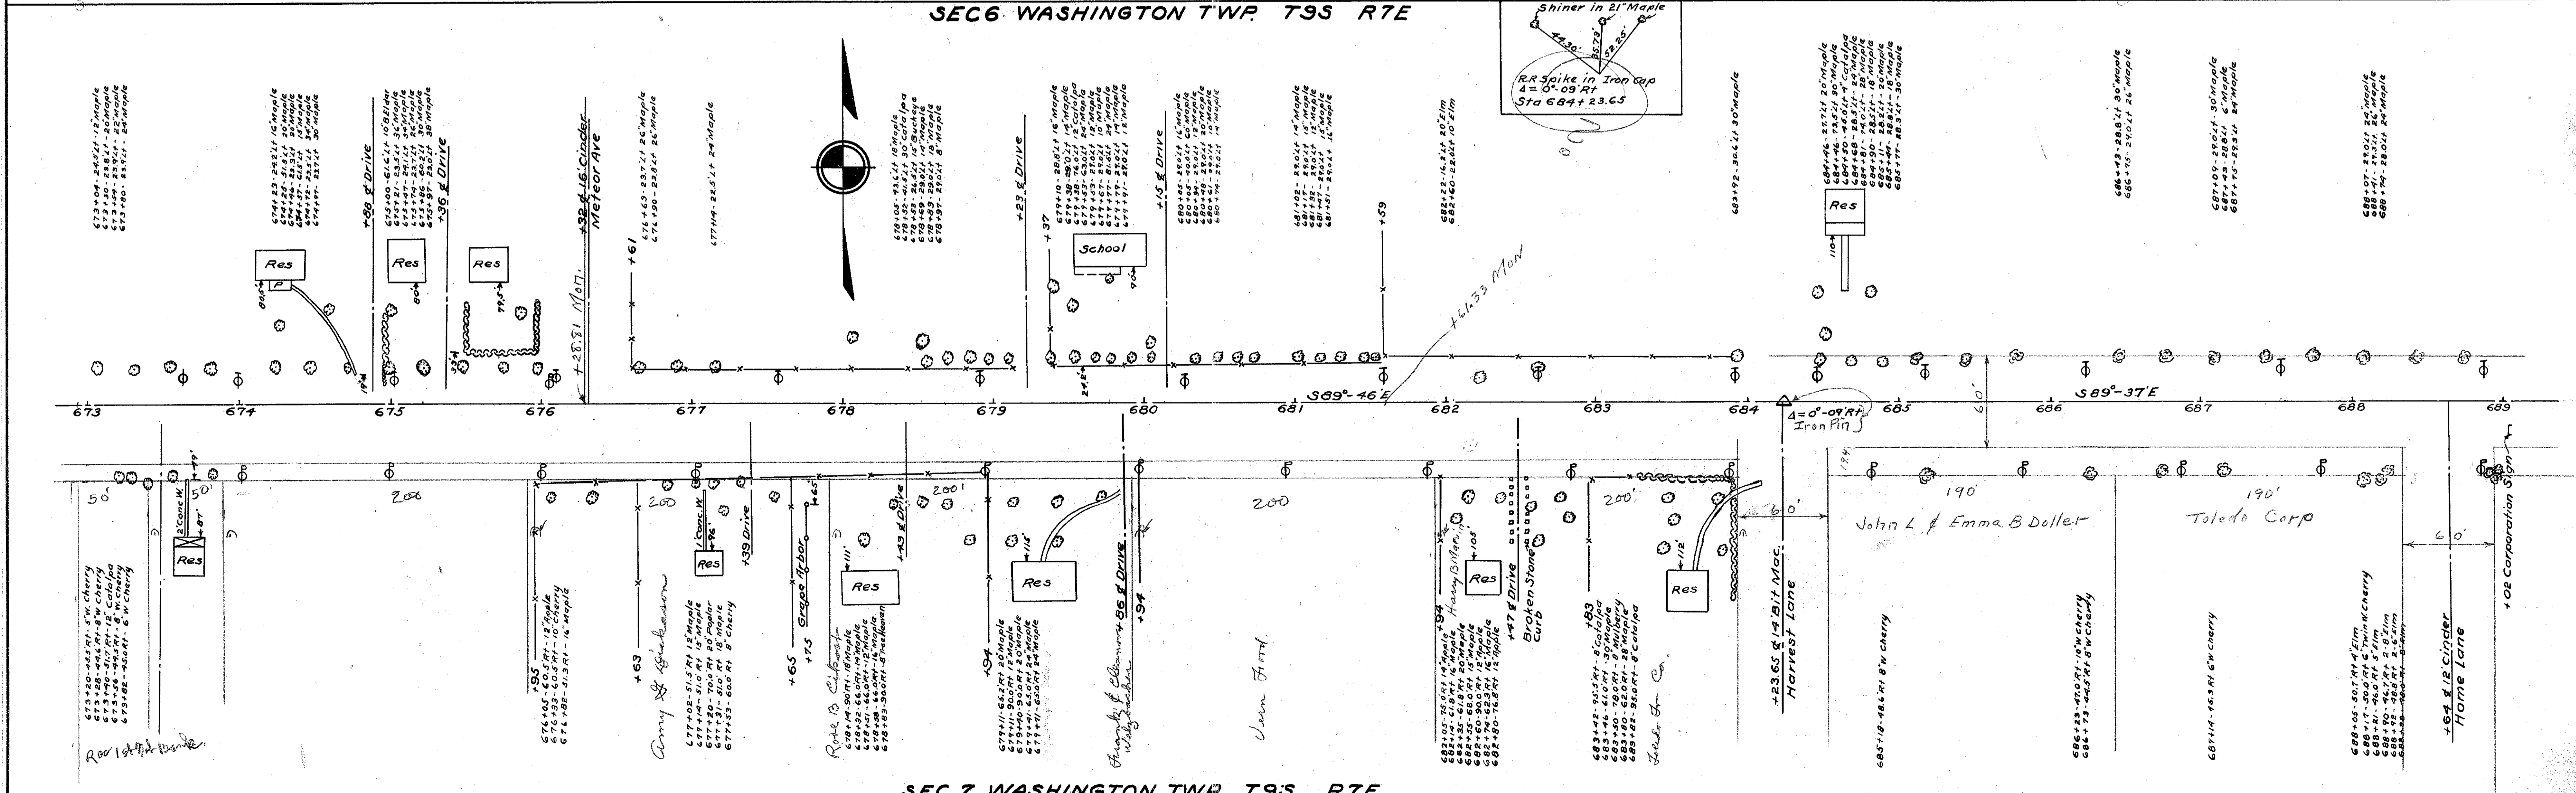



SEC 7 WASHINGTON TWP T9S R7E

Scanned
July 1997

SEC 6 WASHINGTON TWP T9S R7E


LUCAS COUNTY
SH.980 SEC.SYLVANIA(PT)&F(PT)
R/W PLANS

DATE _____ DRAWN BY _____
REVISED _____
LENGTH OF PROJECT _____

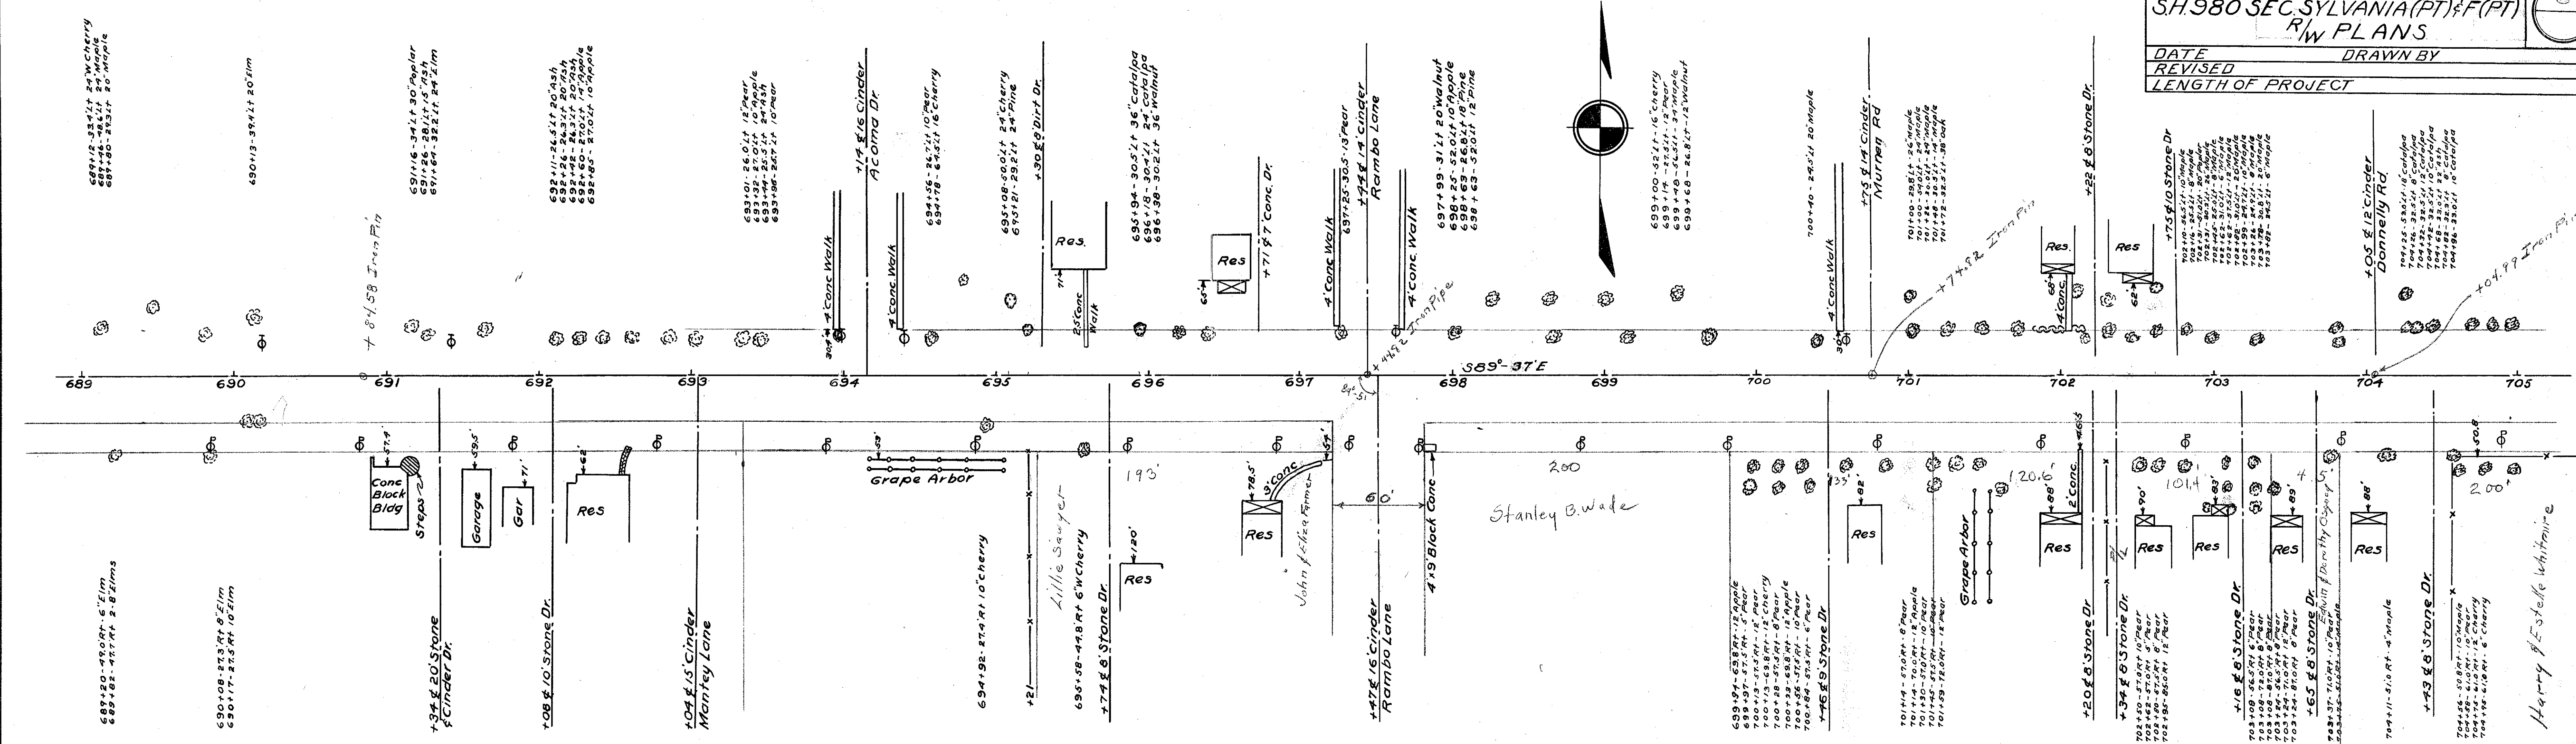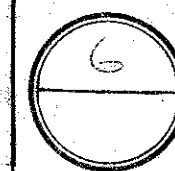

SEC 7 WASHINGTON TWP T9S R7E

SEC 5 WASHINGTON TWP T9S R7E

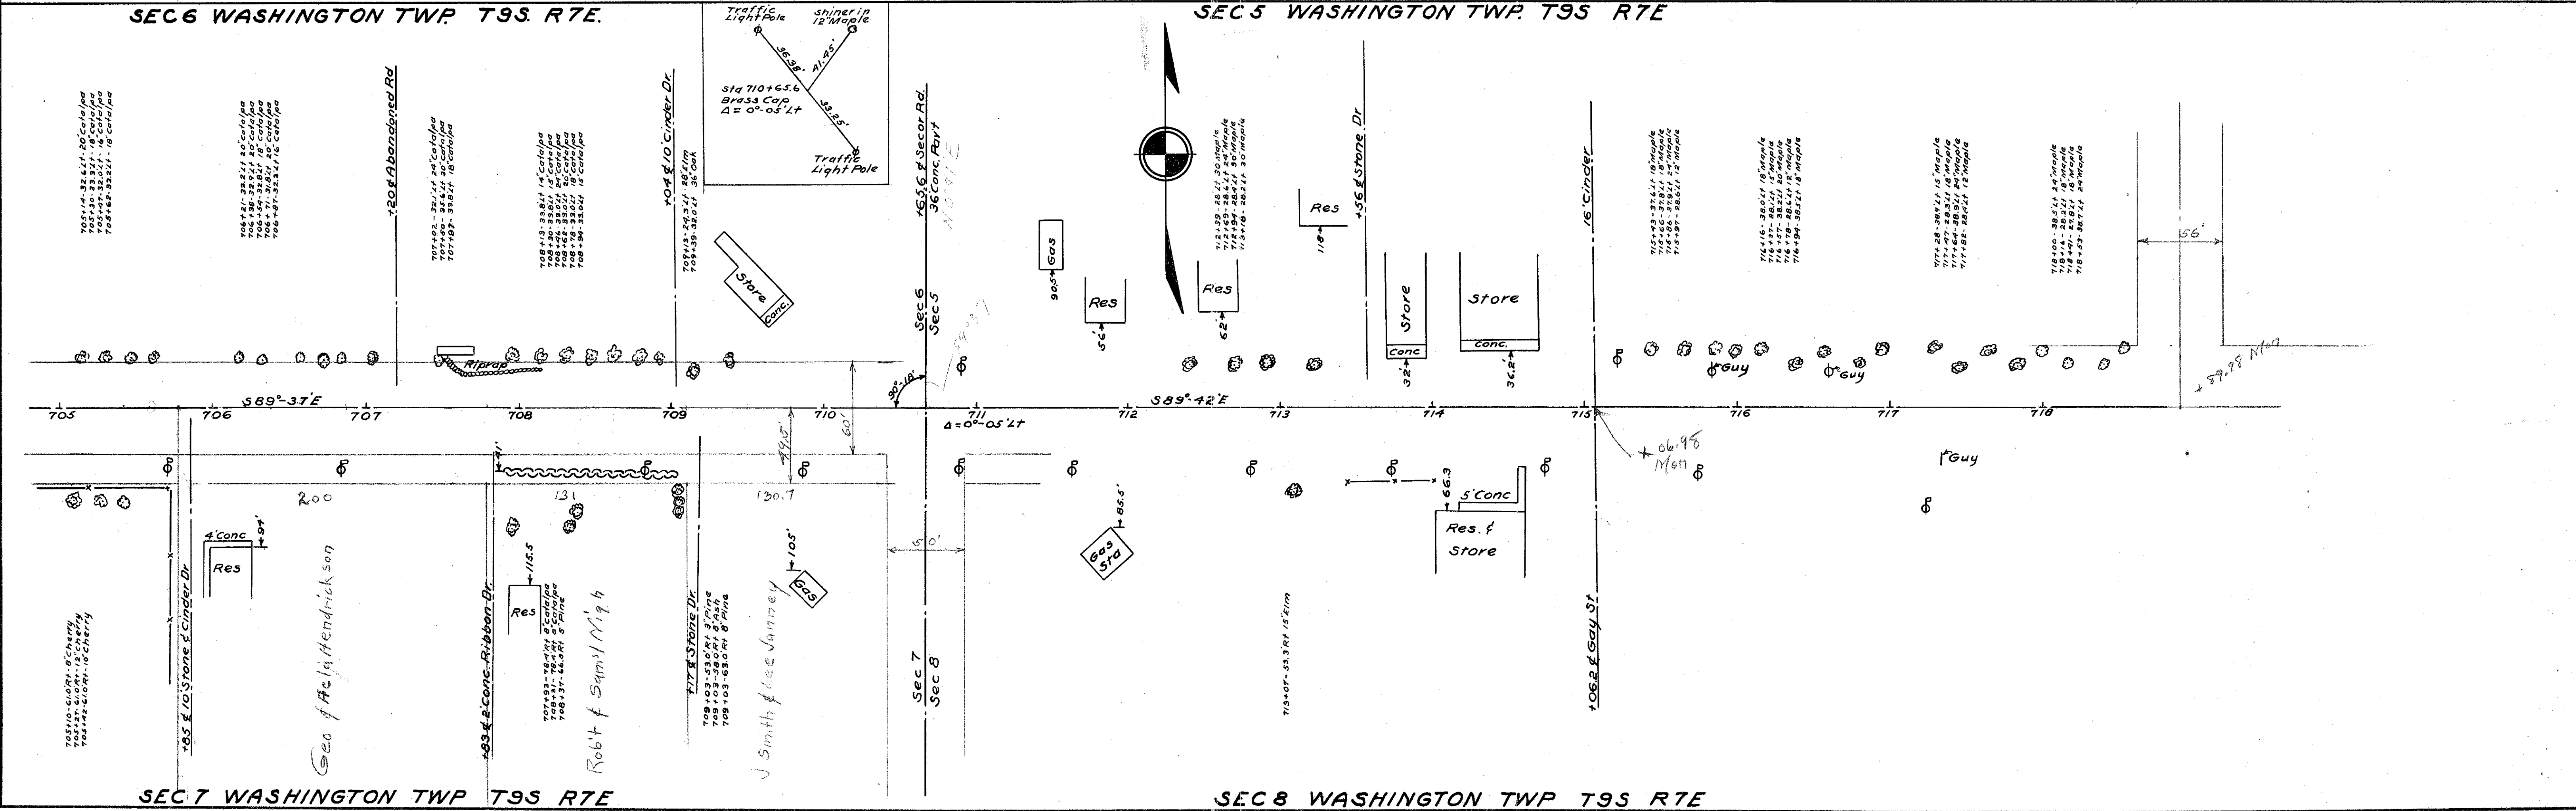

FOR ANY QUESTIONS PLEASE CONTACT ODOT DISTRICT 2 REAL ESTATE AT 419-353-8131