



O.D.O.T. DISTRICT 2 SURVEY OFFICE (USE ONLY)

PERSONNEL \_\_\_\_\_ REFERENCE NO. 1 SHEET 1 OF 18  
 NOTES RHOADES DATE 8/9/18 ROUTE SR 184  
 H.C. O'DONNELL WEATHER SUNNY COUNTY LUCAS  
 R.C. TRENKA TEMP. 70° TOWNSHIP SYLVANIA  
 SECTION 10  
 DWG BY NIESE PID 99662 T 9 N R 6 E

TYPE MONUMENT MAG/WASHER  
 ON SURFACE - ~~BELOW~~ ON \_\_\_\_\_  
 OFFSET  $\odot$  PAVEMENT 11.1' LT : ~~RT~~  
 - TO - EDGE PAVEMENT  
 STATION: 7+30.70

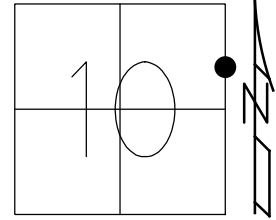

HORZ. DATUM: NAD83(2011) GEOID: 2012A  
 GRID: NORTHING: 748666.035 EASTING: 1645034.593

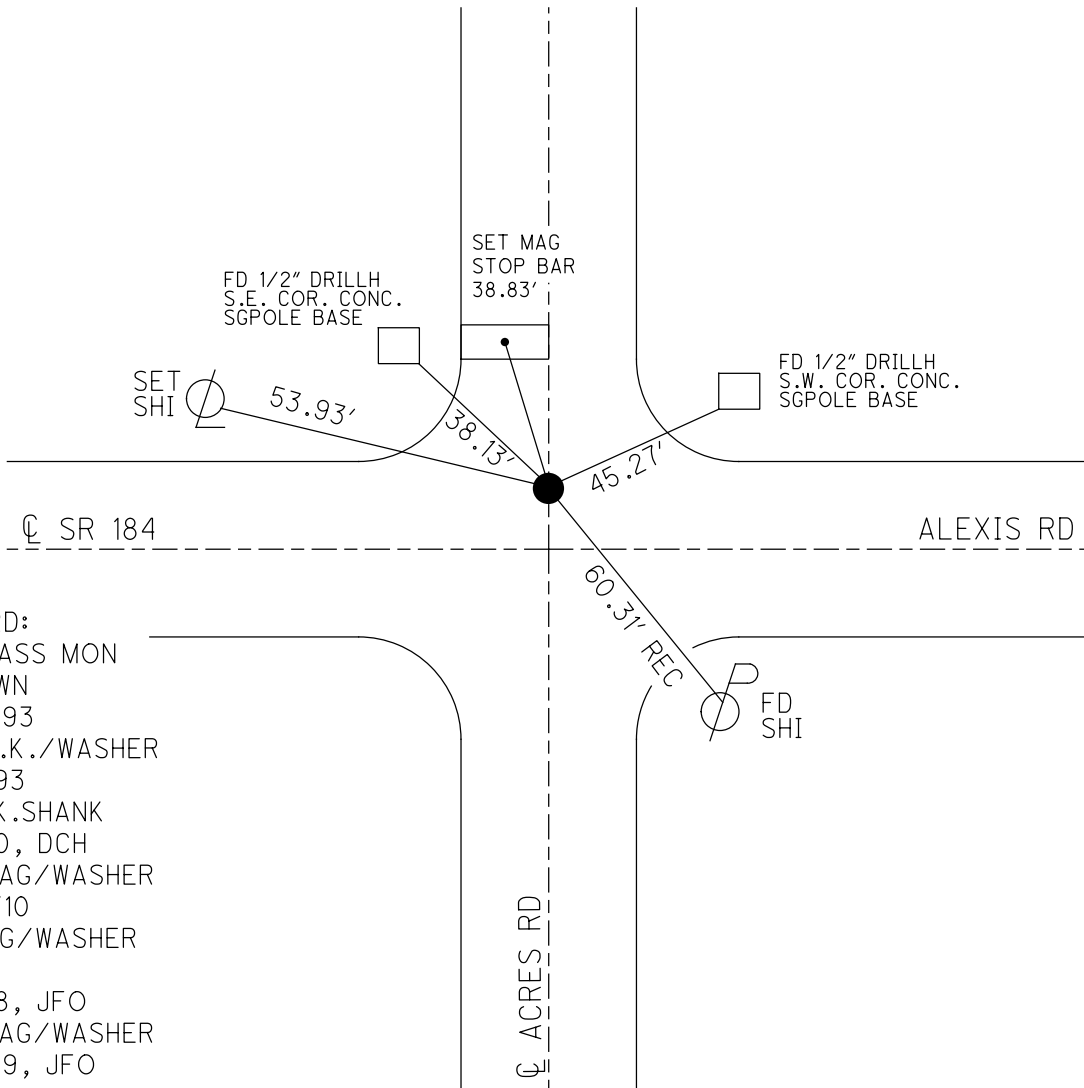


RECORD:  
 FD BRASS MON  
 2" DOWN  
 7/20/93  
 SET P.K./WASHER  
 8/12/93  
 FD P.K.SHANK  
 8/2/10, DCH  
 SET MAG/WASHER  
 10/12/10  
 FD MAG/WASHER  
 REF1  
 8/9/18, JFO  
 SET MAG/WASHER  
 9/17/19, JFO

O.D.O.T. DISTRICT 2 SURVEY OFFICE (USE ONLY)


PERSONNEL \_\_\_\_\_ REFERENCE NO. 1 SHEET 1 OF 18  
 NOTES FINTEL DATE 8/2/2010 ROUTE SR 184  
 H.C. ROUSOS WEATHER SUNNY COUNTY LUCAS  
 R.C. FINTEL TEMP. 80°F TOWNSHIP SYLVANIA  
 \_\_\_\_\_ SECTION 10  
 \_\_\_\_\_ T 9 S R 6 E

TYPE MONUMENT P.K.SHANK  
 ON SURFACE - ~~BELOW~~ \_\_\_\_\_ ON \_\_\_\_\_  
 LEFT - ☉ PAV'T - ~~RIGHT~~ 11.1'  
 \_\_\_\_\_ TO \_\_\_\_\_ EDGE PAVEMENT  
 S.L.M. 18+48

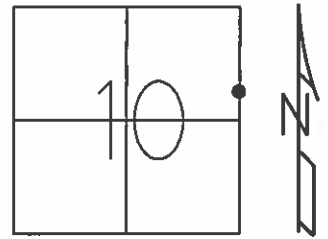

Grid: Northing: 748666.002 Easting: 1645034.366

RECORD:  
 FN. BRASS MON  
 2"DOWN  
 7/20/93  
 SET PK/WASHER  
 8/12/93  
 SET MAG NAIL/WASHER  
 10/12/10

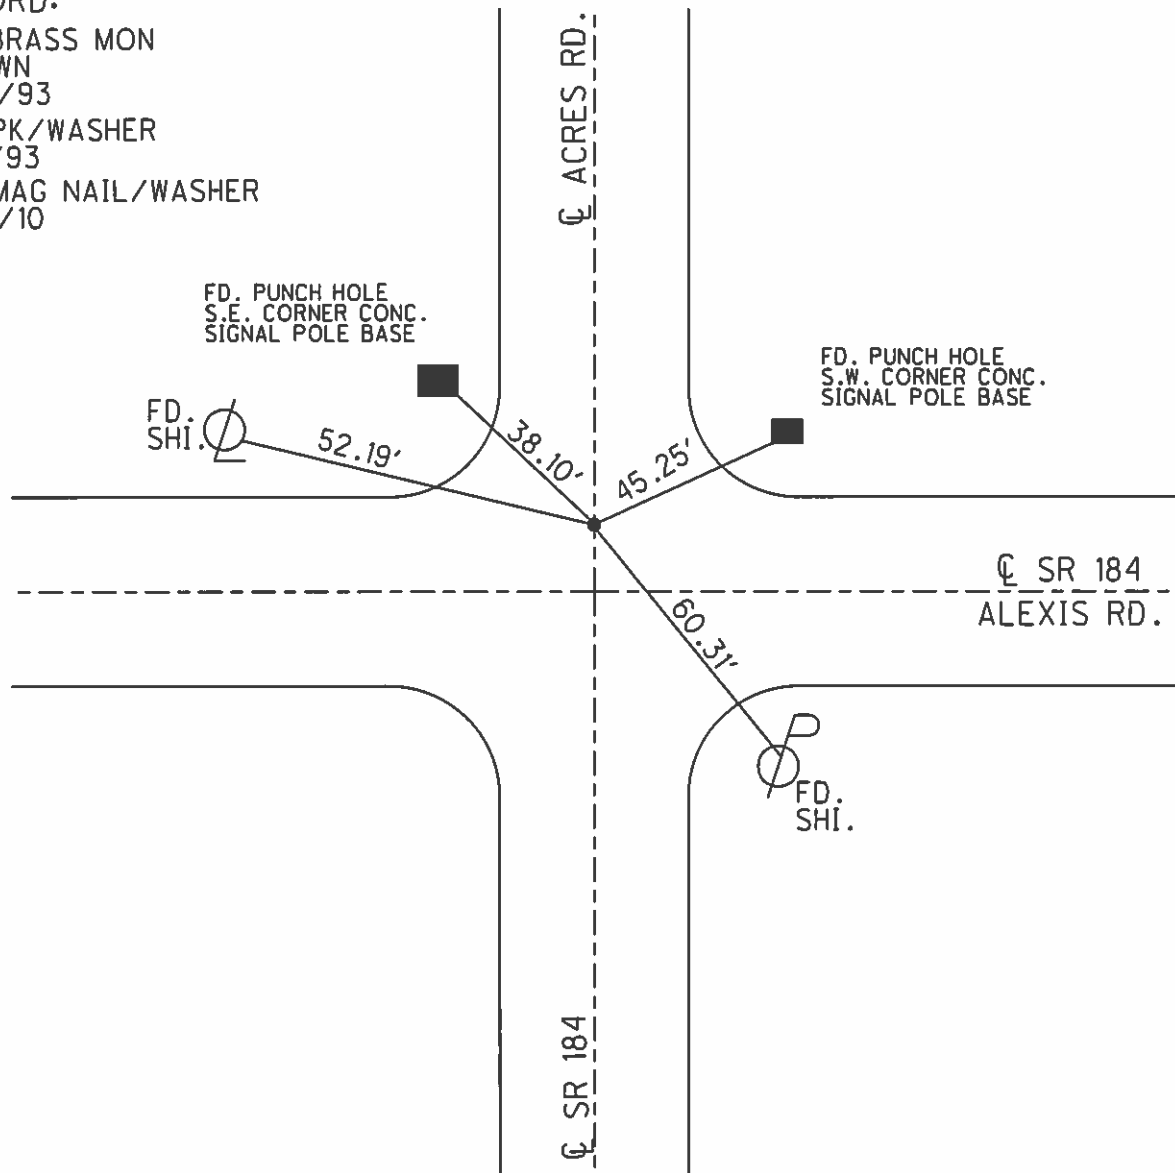

# O.D.O.T. DISTRICT 2 SURVEY OFFICE

PERSONNEL \_\_\_\_\_

REFERENCE NO. 1

SHEET 1 OF 20

NOTES LOEHARKE

H.C. CORDES

DATE 7-20-93

ROUTE S.R. 184

R.C. ROMERO

WEATHER CLEAR

COUNTY LUCAS

CANTERBURY

TEMP. +76

TOWNSHIP \_\_\_\_\_

SECTION \_\_\_\_\_

Set P.K. / WASHER  
8-12-93

T. \_\_\_\_\_ R. \_\_\_\_\_



TYPE MONUMENT BRASS MON

ON SURFACE - BELOW 2"

LEFT - C PAV'T. - RIGHT 11.1


TO \_\_\_\_\_ EDGE PAVEMENT

S.L.M. 18 + 48

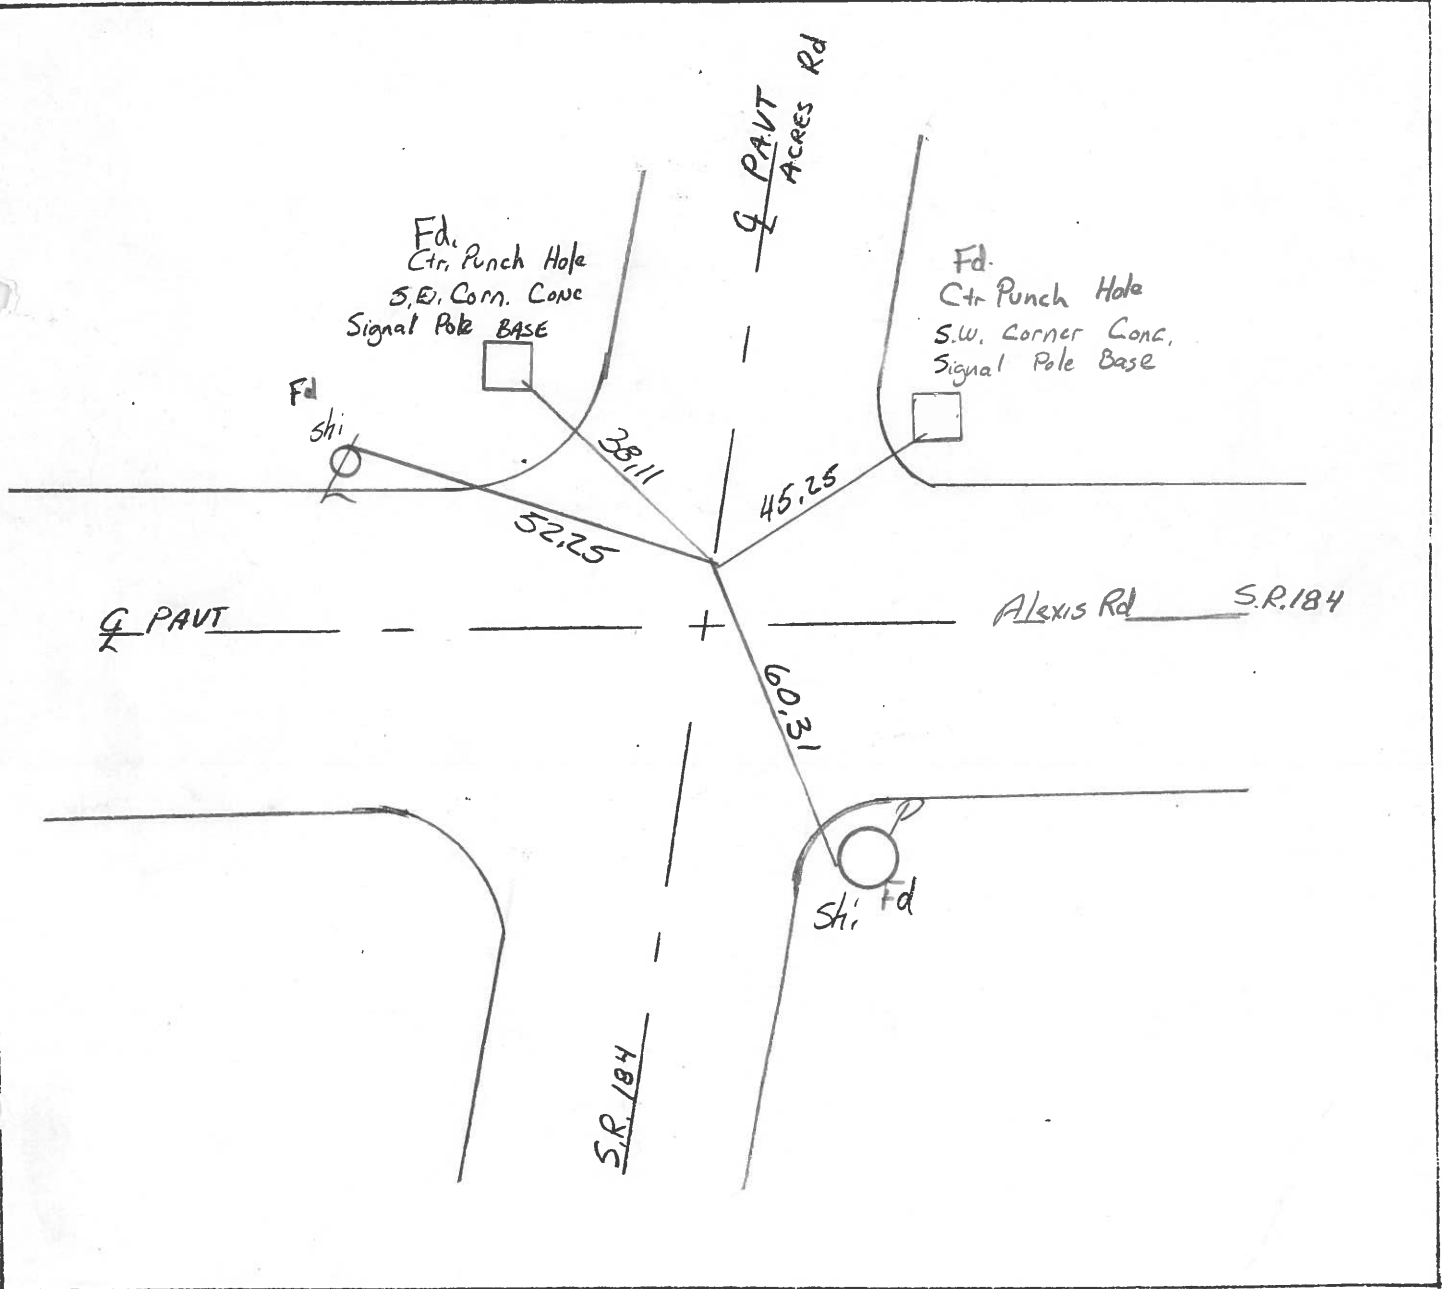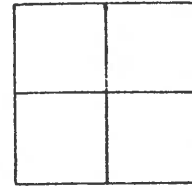

PERSONNEL	TITLE	PERSONNEL	TITLE	COUNTY	DATE	WEATHER	TEMP.
Stone				Lucas	19 Feb. 76	Cloudy	34°
Michalak				S. R.	184		
Curtis				SEC.	0.00		

DESCRIPTION References to Control Points JOB NO. \_\_\_\_\_

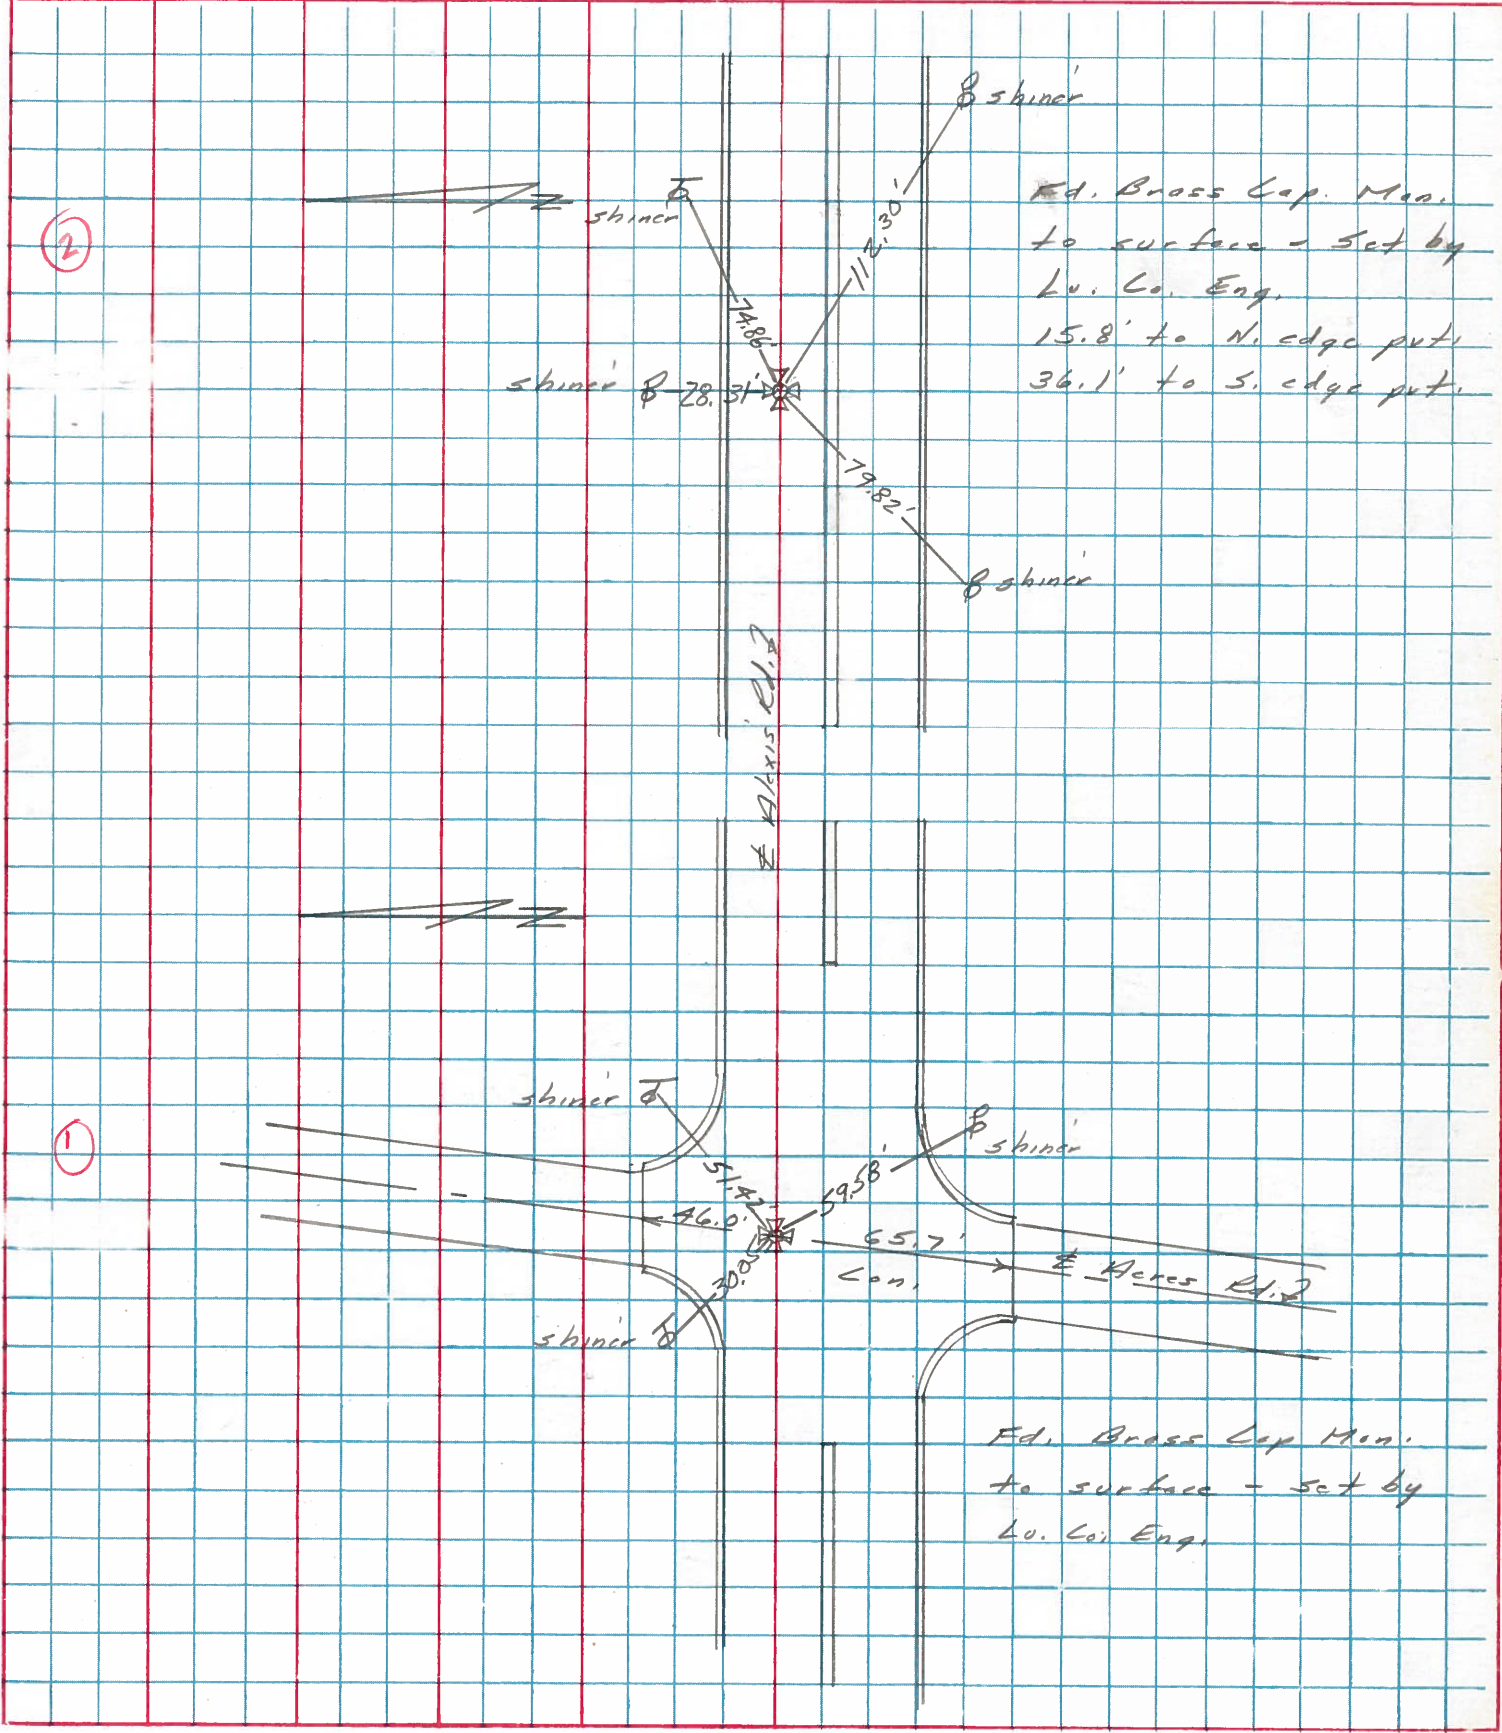

PERSONNEL	TITLE	PERSONNEL	TITLE	COUNTY	DATE
Stone	Notes			Lucas	18 June 68
Beck	Klog			S. R. 23-24-25 Bypass	WEATHER Fair
Michalak	Tape			SEC. Alexis Rd.	TEMP. 65°
Schroder	Tape				

DESCRIPTION References to Control Points JOB NO. \_\_\_\_\_

