



O.D.O.T. DISTRICT 2 SURVEY OFFICE (USE ONLY)

PERSONNEL \_\_\_\_\_ REFERENCE NO. 3 SHEET 3 OF 18  
 NOTES RHOADES DATE 8/9/18 ROUTE SR 184  
 H.C. O'DONNELL WEATHER SUNNY COUNTY LUCAS  
 R.C. TRENKA TEMP. 70° TOWNSHIP SYLVANIA  
 DWG BY NIESE PID 99662 SECTION 11  
 T 9 N R 6 E

TYPE MONUMENT HOLE  
 ON SURFACE - ~~BELOW~~ ON  
 OFFSET  $\text{C}$  PAVEMENT -- LT : RT  
- TO - EDGE PAVEMENT  
 STATION: 17+79.05

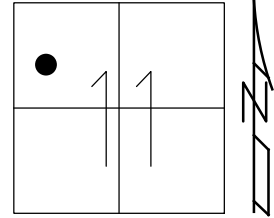


HORZ. DATUM: NAD83(2011) GEOID: 2012A  
 GRID: NORTHING: 748820.374 EASTING: 1646071.480

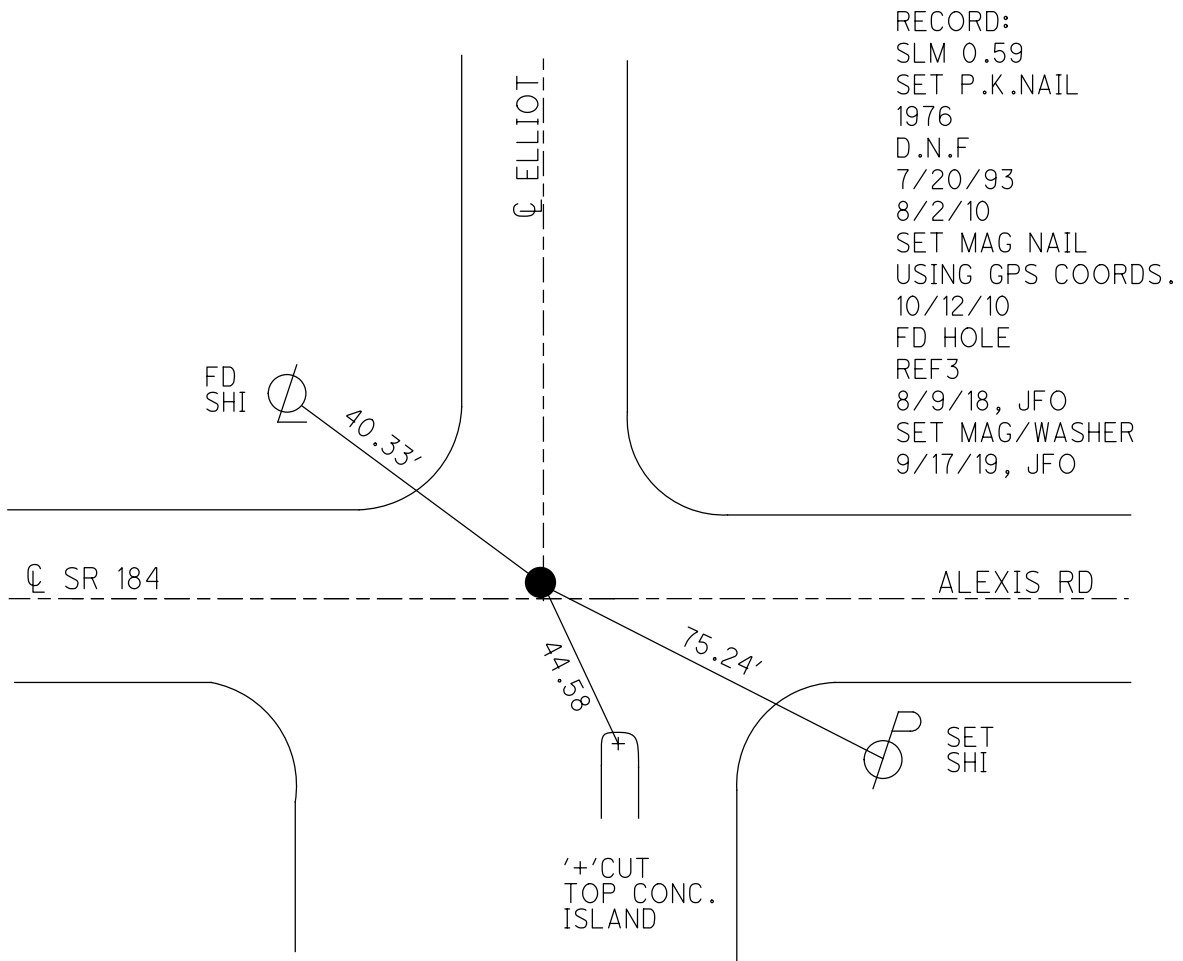

O.D.O.T. DISTRICT 2 SURVEY OFFICE (USE ONLY)

PERSONNEL \_\_\_\_\_ REFERENCE NO. 3 SHEET 3 OF 18  
 NOTES HOMAN DATE 8/2/10 ROUTE SR. 184  
 H.C. ROUSOS WEATHER SUNNY COUNTY LUCAS  
 R.C. HOMAN TEMP. 80° F TOWNSHIP SYLVANIA  
 \_\_\_\_\_ SECTION 11  
 \_\_\_\_\_ T 9 S R 6 E


TYPE MONUMENT DNF  
 ON SURFACE - BELOW \_\_\_\_\_  
 LEFT - ☉ PAV'T - RIGHT \_\_\_\_\_  
 \_\_\_\_\_ TO \_\_\_\_\_ EDGE PAVEMENT  
 S.L.M. 29+04

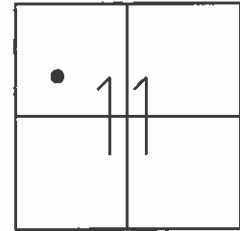

Grid: Northing: 748820.392 Easting: 1646071.292

RECORD:  
 SLM. 0.59  
 SET PK. AS PER  
 REFERENCES  
 1976  
 36.0' TO S. CURB  
 D.N.F.  
 DID NOT RESET  
 7/20/93  
 SET MAG NAIL  
 USING GPS COORDS.  
 10/12/10

USED LIGHT POLE PULL  
 TO ESTABLISH REF. PT.  
 AREA

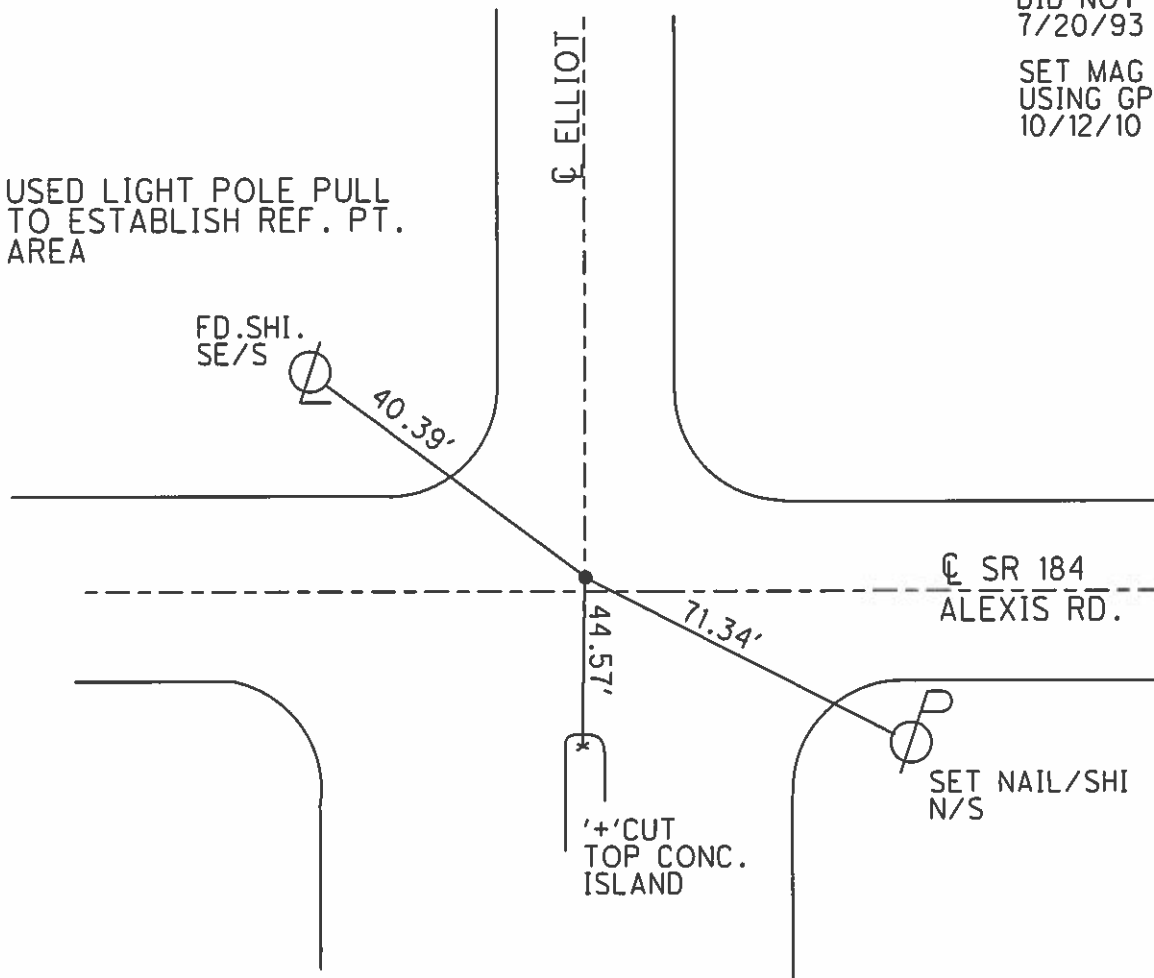

O.D.O.T. DISTRICT 2 SURVEY OFFICE

PERSONNEL \_\_\_\_\_

REFERENCE NO. 3

SHEET 3 OF 20

NOTES LOEHRKE

H.C. \_\_\_\_\_

R.C. \_\_\_\_\_

DATE 7-20-93

WEATHER Clear

TEMP. +78

ROUTE S.R. 184

COUNTY LUCAS

TOWNSHIP \_\_\_\_\_

SECTION \_\_\_\_\_

T. \_\_\_\_\_ R. \_\_\_\_\_


TYPE MONUMENT P.K. - Did Not Find - Did Not

ON SURFACE - BELOW


LEFT- & PAV'T. - RIGHT

TO \_\_\_\_\_ EDGE PAVEMENT

S.L.M. \_\_\_\_\_

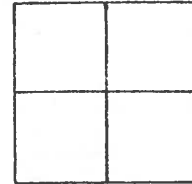

Record 1976  
 Set P.K. AS PER  
 References.  
 36.0' TO S. FACE CURB

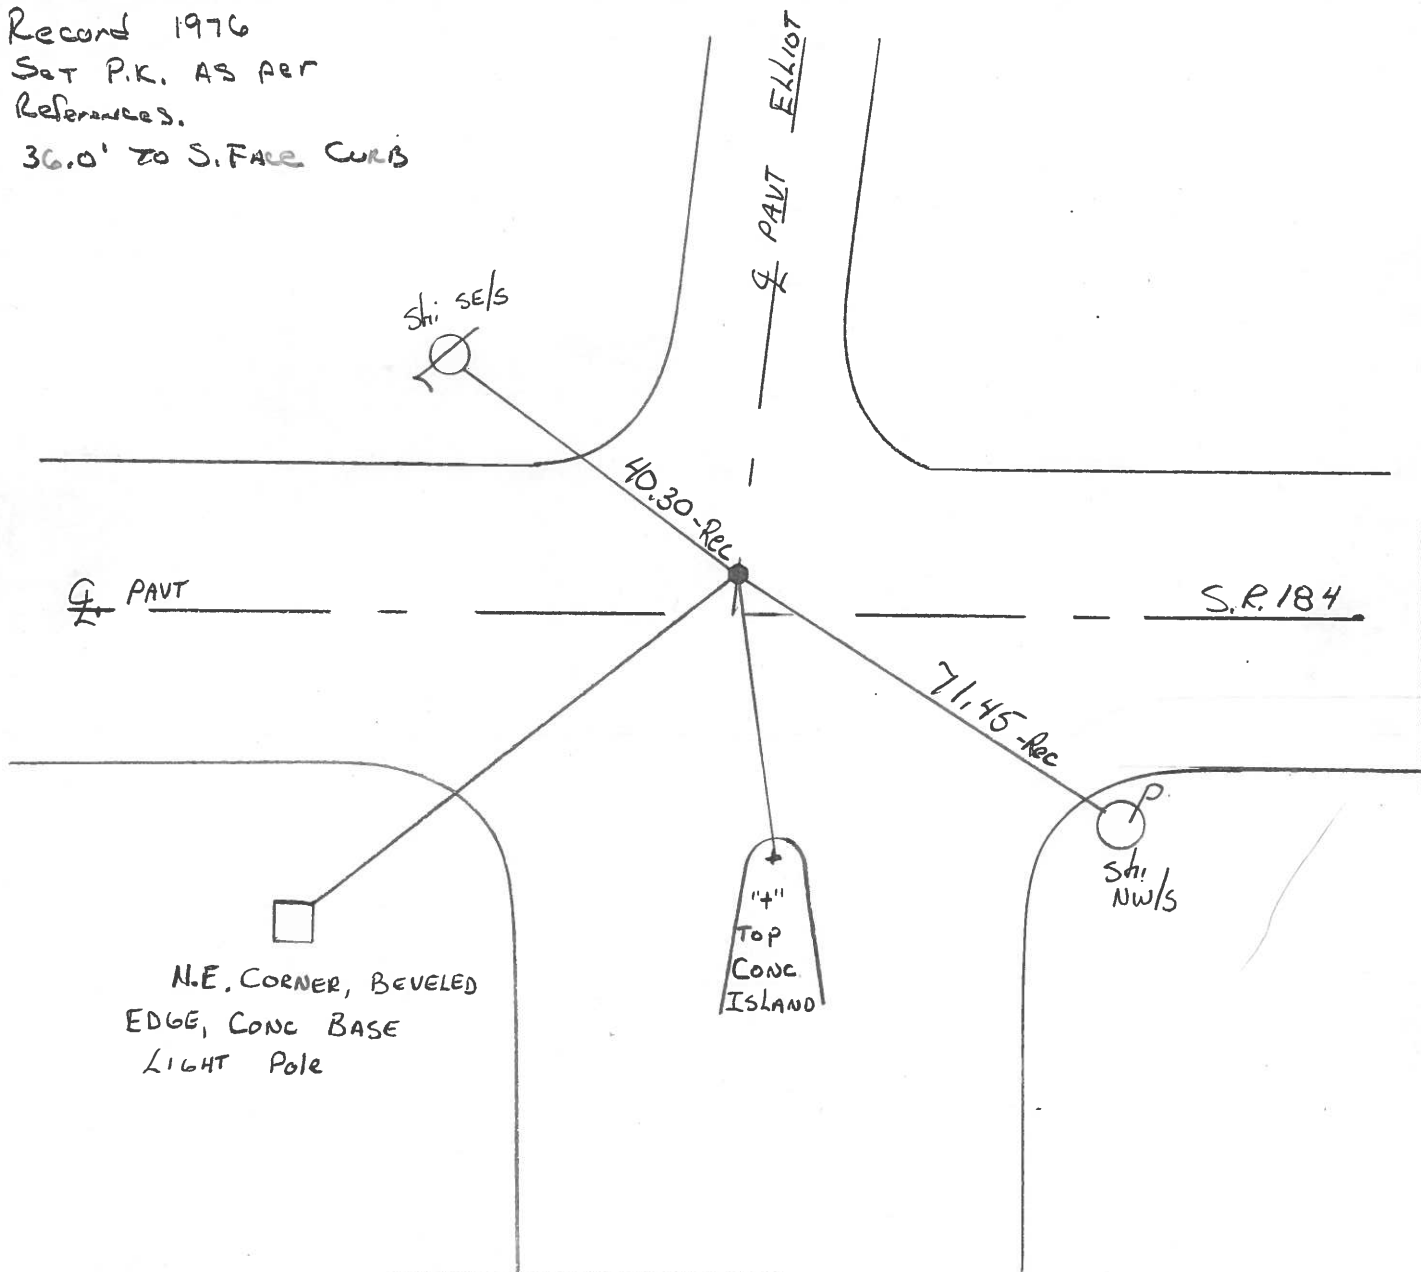


N.E. CORNER, BEVELED  
 EDGE, CONC BASE  
 LIGHT Pole

1" Top  
 CONC  
 ISLAND

PERSONNEL	TITLE	PERSONNEL	TITLE	COUNTY	DATE	WEATHER	TEMP.
Stone				Lucas	19 Feb. 76	Cloudy	34°
Michalak				S. R.	184		
Curtis				SEC.	0.00		


DESCRIPTION References to Control Points JOB NO. \_\_\_\_\_

LEFT CENTER LINE RIGHT

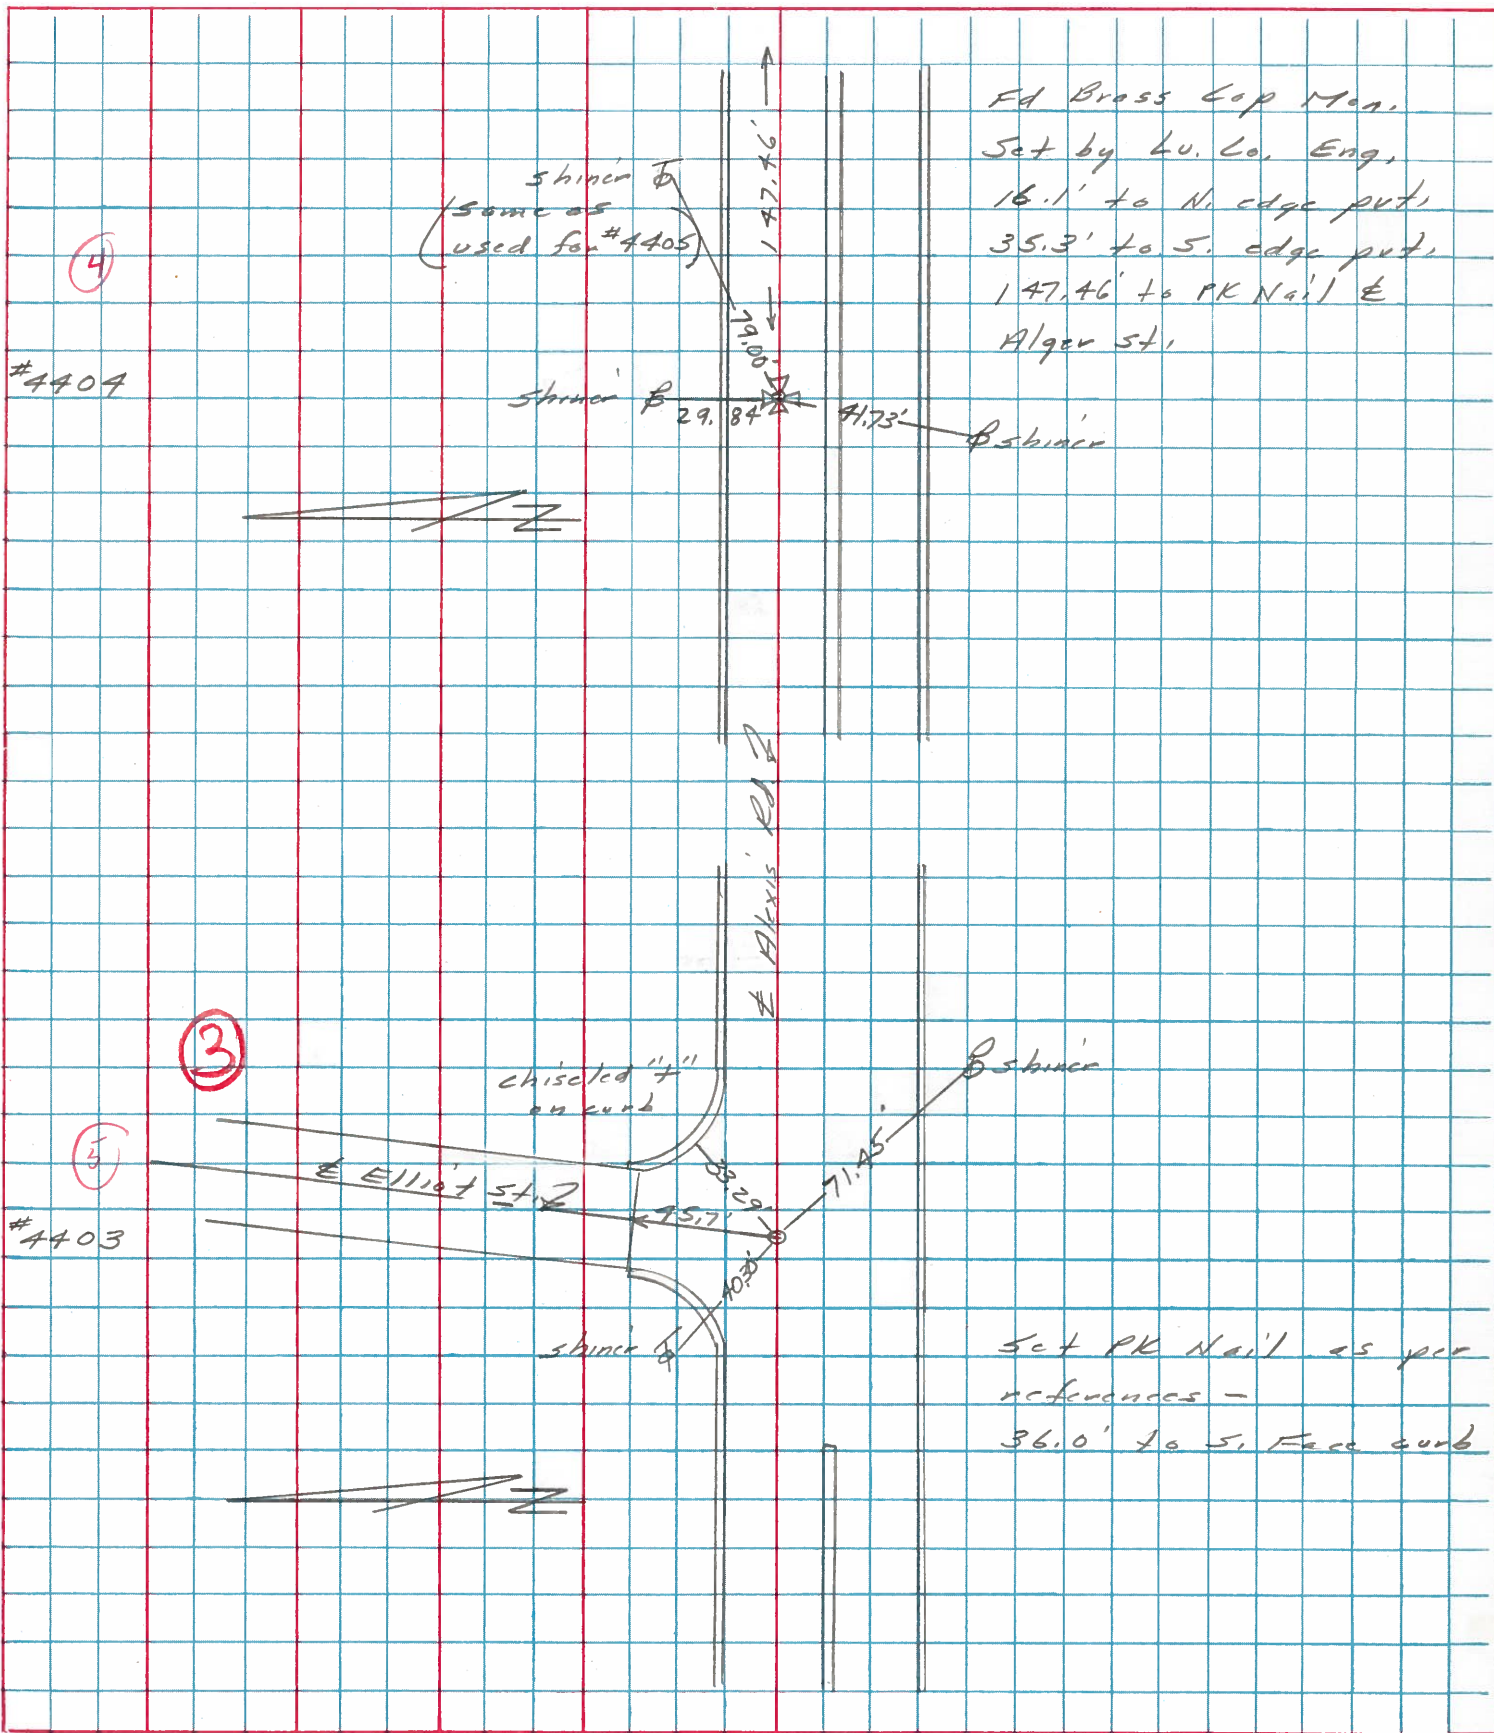

PERSONNEL	TITLE	PERSONNEL	TITLE	COUNTY	DATE	WEATHER	TEMP.
Selove	Notes			Lucas	18 June 68	Fair	65°
Beck	Flag			S. R. 23-24-25- Elyssse			
Michalak	Tape			SEC. Alexis Rd			
Schroder	Tape						

DESCRIPTION References to Control Points JOB NO. \_\_\_\_\_

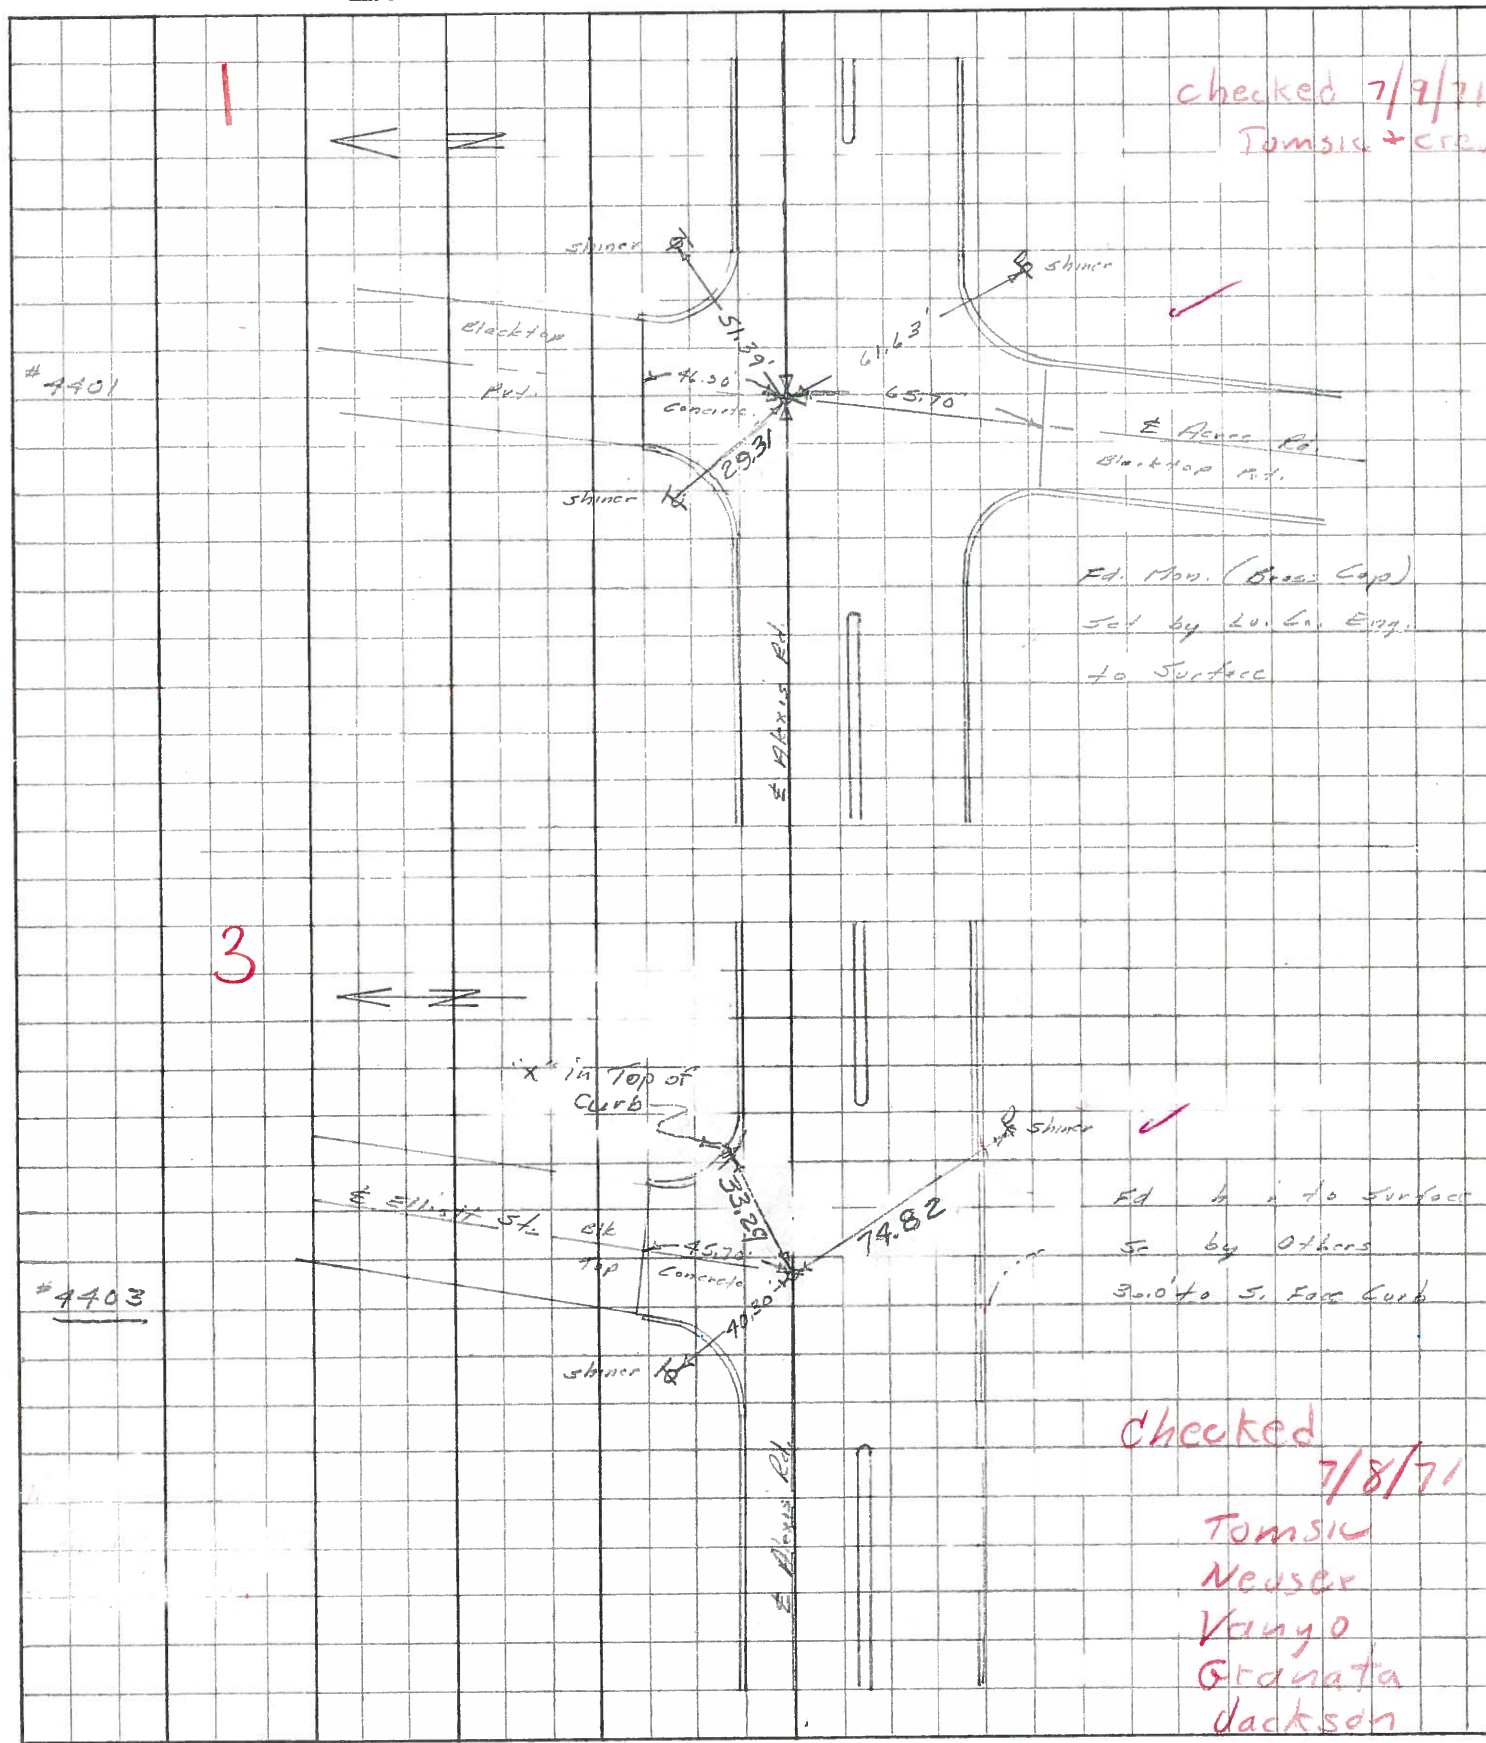

checked 7/9/71  
Tomsic + crew

Ed. Man. (Base Cap)  
Set by Lu. Co. Engg.  
to Surface

Ed h i to Surface  
Set by Others  
30.0' to S. Face Curb

checked 7/8/71  
Tomsic  
Neuser  
Vanyo  
Granata  
Jackson