

O.D.O.T. DISTRICT 2 SURVEY OFFICE (USE ONLY)

PERSONNEL

REFERENCE NO. 4

SHEET 4 OF 18

NOTES RHOADES

DATE 8/9/18

ROUTE SR 184

H.C. O'DONNELL

WEATHER SUNNY

COUNTY LUCAS

R.C. TRENKA

TEMP. 70°

TOWNSHIP SYLVANIA

SECTION 11

DWG BY NIESE

PID 99662

T 9 N R 6 E

TYPE MONUMENT MAG/WASHER

ON SURFACE - ~~BELOW~~ ON

OFFSET 10.0' LT : ~~RT~~

16.1' TO LT EDGE PAVEMENT



STATION: 20+11.36

HORIZ.DATUM: NAD83(2011)

GEOID: 2012A

GRID: NORTHING: 748854.545

EASTING: 1646301.282

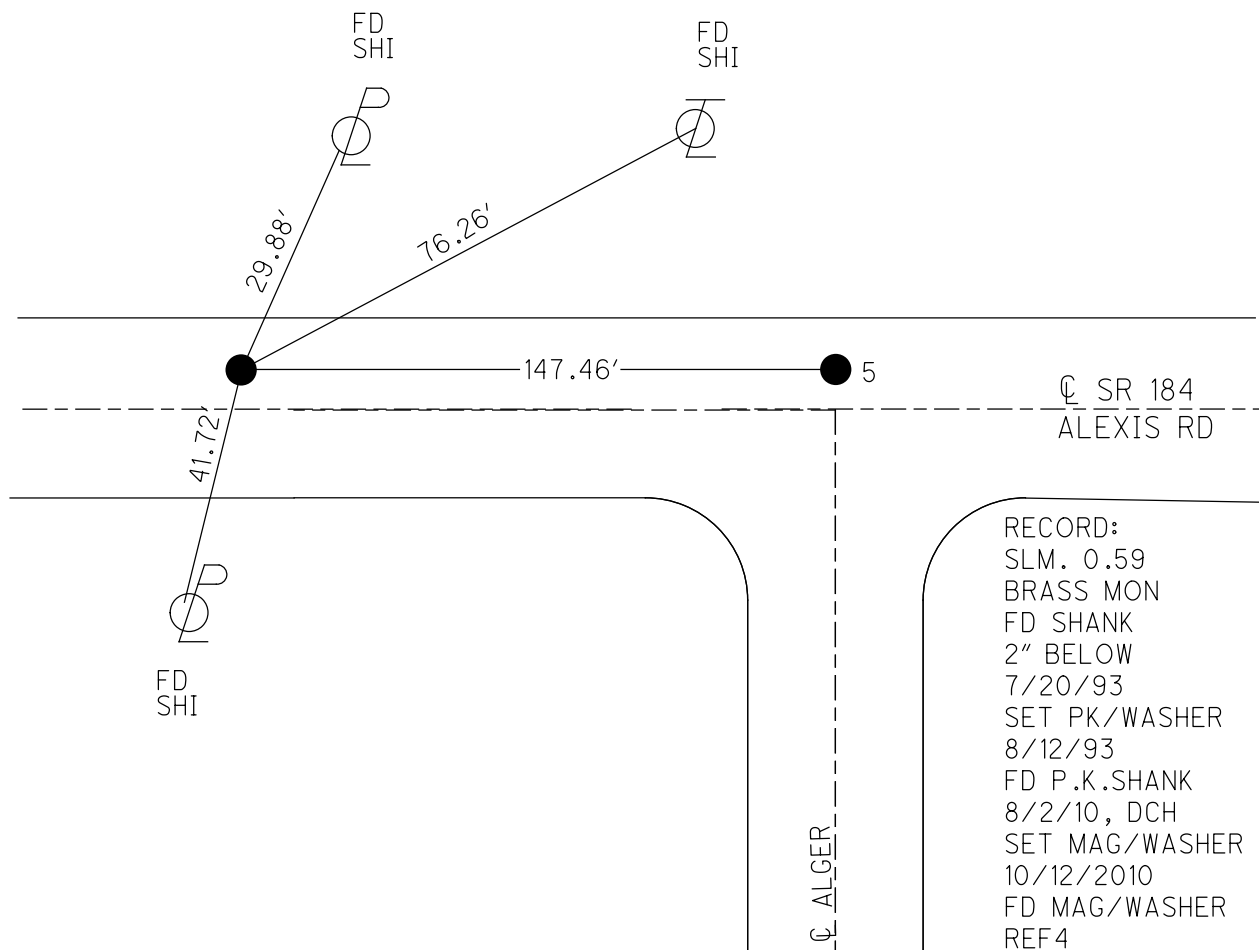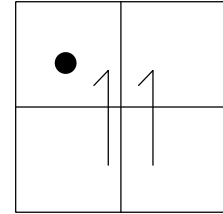

RECORD:
 SLM. 0.59
 BRASS MON
 FD SHANK
 2" BELOW
 7/20/93
 SET PK/WASHER
 8/12/93
 FD P.K.SHANK
 8/2/10, DCH
 SET MAG/WASHER
 10/12/2010
 FD MAG/WASHER
 REF4
 8/9/18, JFO
 SET MAG/WASHER
 9/17/19, JFO

O.D.O.T. DISTRICT 2 SURVEY OFFICE (USE ONLY)

PERSONNEL

REFERENCE NO. 4

SHEET 4 OF 18

NOTES FINTEL

DATE 8/02/2010

ROUTE SR. 184

H.C. ROUSOS

WEATHER SUNNY

COUNTY LUCAS

R.C. FINTEL

TEMP. 83°F

TOWNSHIP SYLVANIA

SECTION 11

T 9 S R 6 E


TYPE MONUMENT P.K.SHANK

ON SURFACE - ~~BELOW~~ ON

LEFT - ☉ PAV'T - ~~RIGHT~~ 10.0'

16.1' TO LT. EDGE PAVEMENT

S.L.M. STA. 31+28

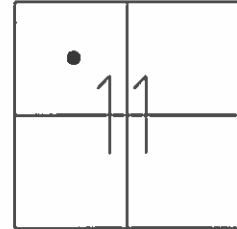

Grid: Northing: 748854.598 Easting: 1646301.057


RECORD:

SLM. 0.59
BRASS MON.

FD. SHANK
2" BELOW
7/20/93

SET PK/WASHER
8/12/93

SET MAG/WASHER
10/12/2010

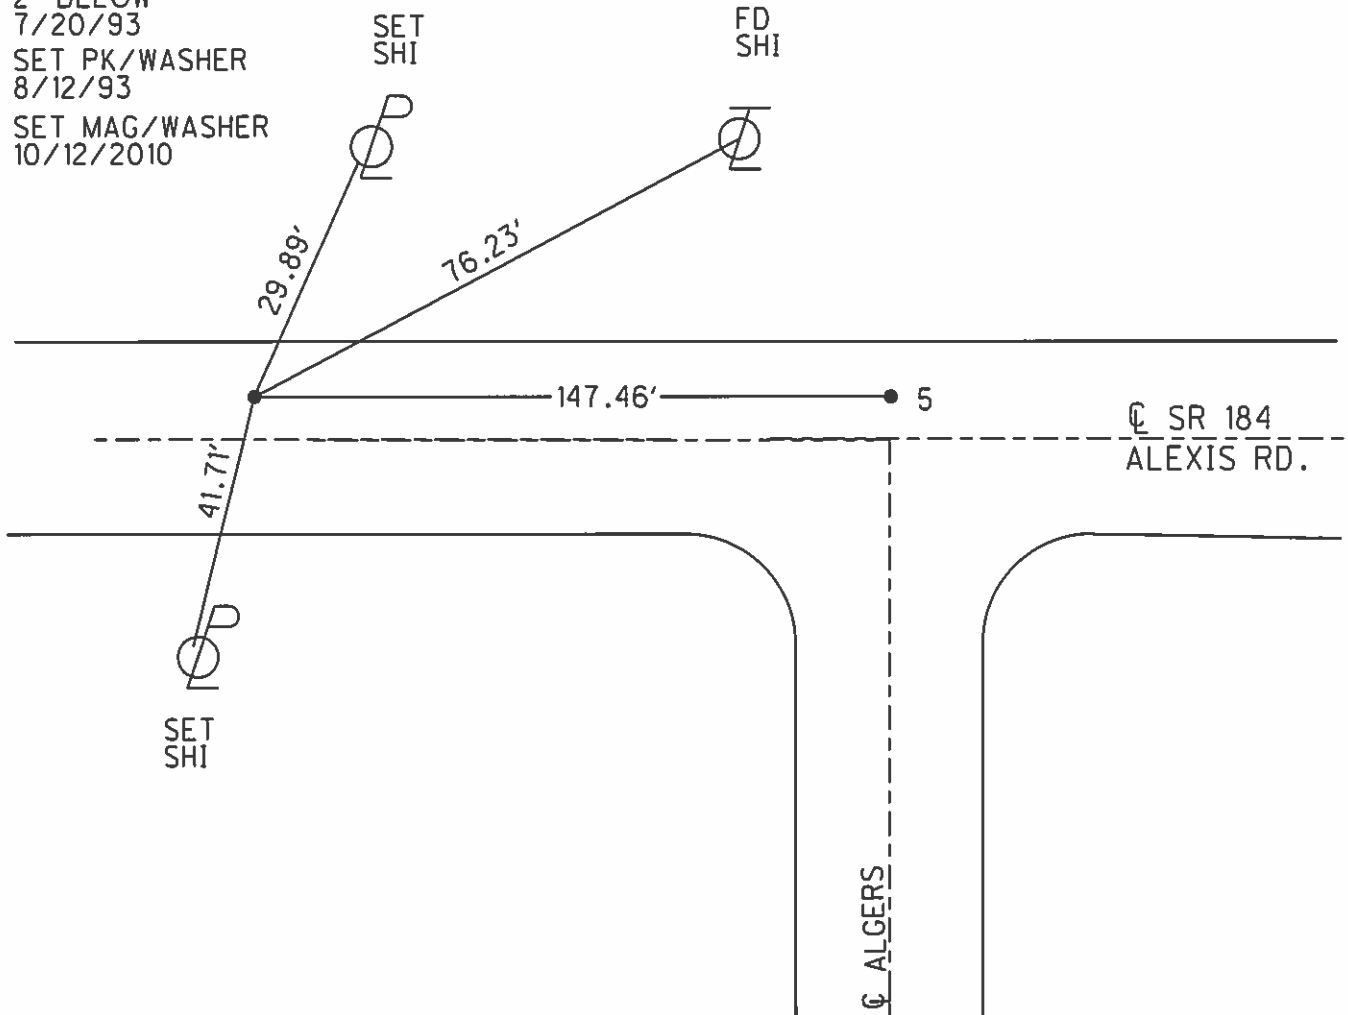

O.D.O.T. DISTRICT 2 SURVEY OFFICE

PERSONNEL _____

REFERENCE NO. 4 E 5

SHEET 4 OF 20



NOTES COEHAKE
 H.C. CORDES
 R.C. ROMETO
CANTERBURY

DATE 7-20-93
 WEATHER CLEAR
 TEMP. +78

ROUTE S.R. 184
 COUNTY LUCAS
 TOWNSHIP _____
 SECTION _____
 T _____ R _____


Set P.K./WASHERS
 B-12-93

TYPE MONUMENT BRASS MON ^A PK Shank ^B
 ON SURFACE - BELOW 2" Below
 LEFT- & PAV'T. - RIGHT 10.0
16.1 TO Lt. EDGE PAVEMENT
 S.L.M. A = 31+28 B = 32+75

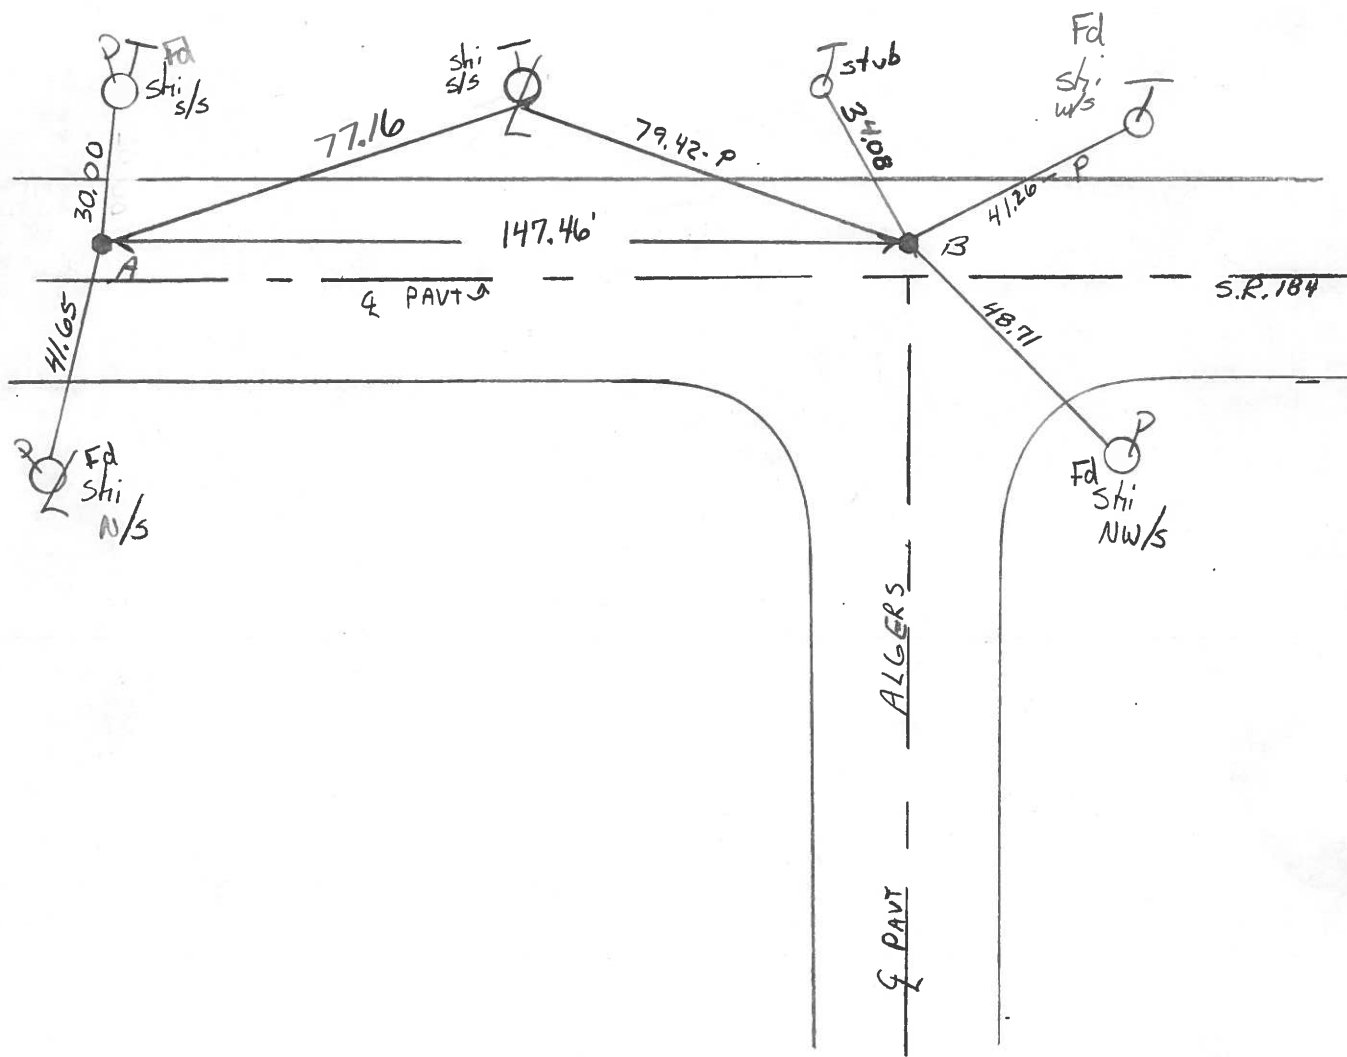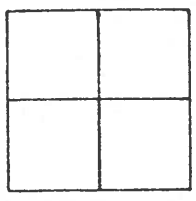

PERSONNEL	TITLE	PERSONNEL	TITLE	COUNTY	DATE
Stone				Lucas	19 Feb. 76
Michalak				S. R. 184	WEATHER Cloudy
Curtis				SEC. 0.00	TEMP. 34°

DESCRIPTION References to Control Points JOB NO. _____
 LEFT CENTER LINE RIGHT

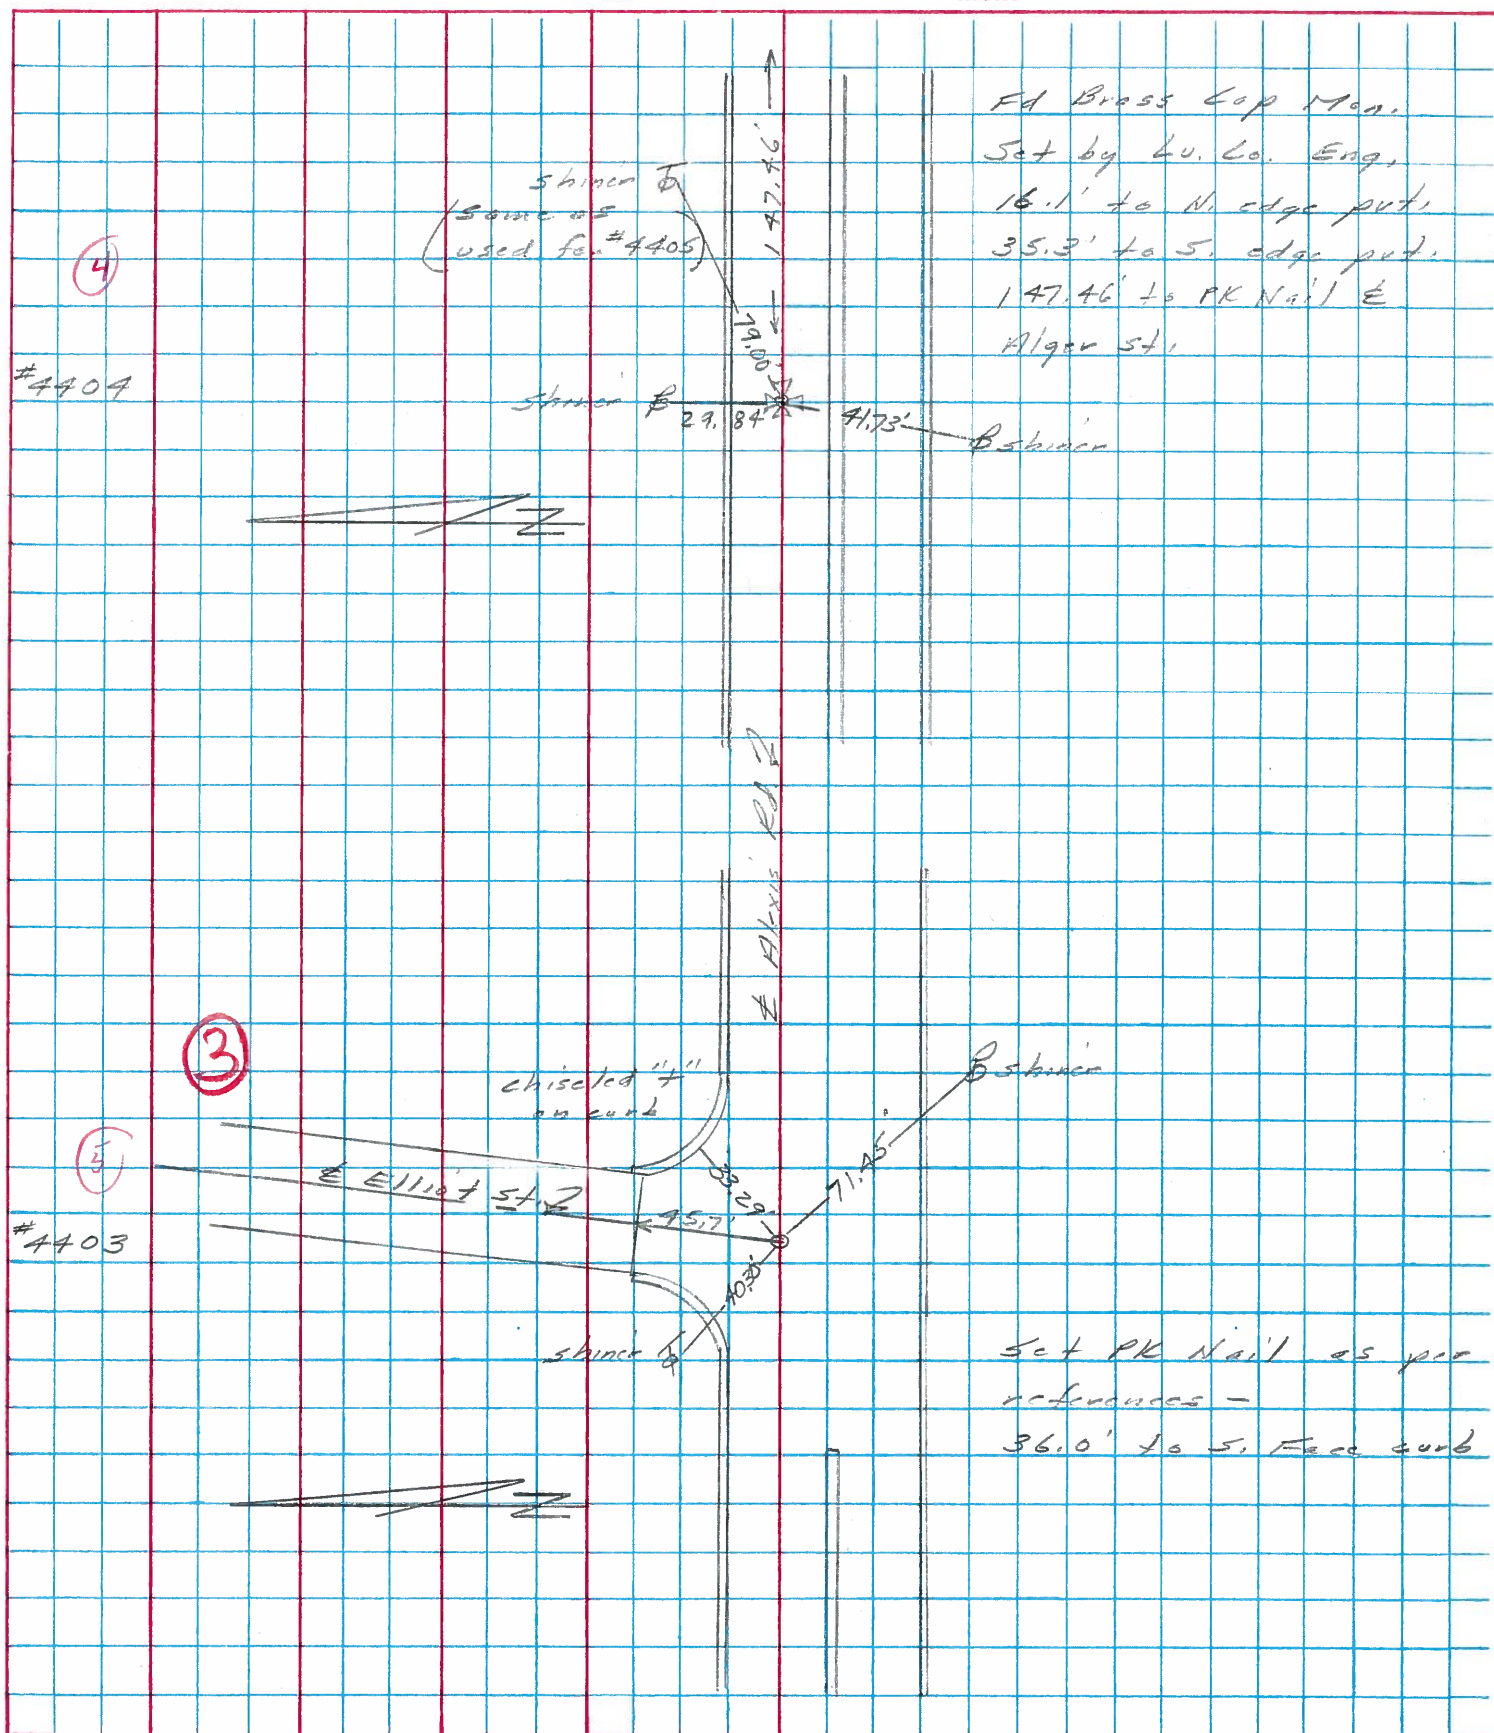

Set PK Nail as per references -
 36.0' to S. Face curb

PERSONNEL	TITLE	PERSONNEL	TITLE	COUNTY	DATE	WEATHER	TEMP.
Stone	Notes			Lucas	18 June 68	Fair	60°
Beck	Flag			S. R. 23-24-25 Bypass			
Michaelak	Tape						
Schroeder	Tape			Alexis Rd.			

DESCRIPTION References to Control Points JOB NO. _____

LEFT CENTER LINE RIGHT

