

O.D.O.T. DISTRICT 2 SURVEY OFFICE (USE ONLY)

PERSONNEL

REFERENCE NO. 5

SHEET 5 OF 18

NOTES RHOADES
 H.C. O'DONNELL
 R.C. TRENKA

DATE 8/9/18
 WEATHER SUNNY
 TEMP. 70°

ROUTE SR 184
 COUNTY LUCAS
 TOWNSHIP SYLVANIA
 SECTION 11
 T 9 N R 6 E

DWG BY NIESE PID 99662

TYPE MONUMENT MAG/WASHER

ON SURFACE - ~~BELOW~~ ON

OFFSET 10.0' LT : ~~RT~~
16.1' TO LT EDGE PAVEMENT



STATION: 21+57.80

HORZ. DATUM: NAD83(2011)

GEOID: 2012A

GRID: NORTHING: 748876.201

EASTING: 1646446.146

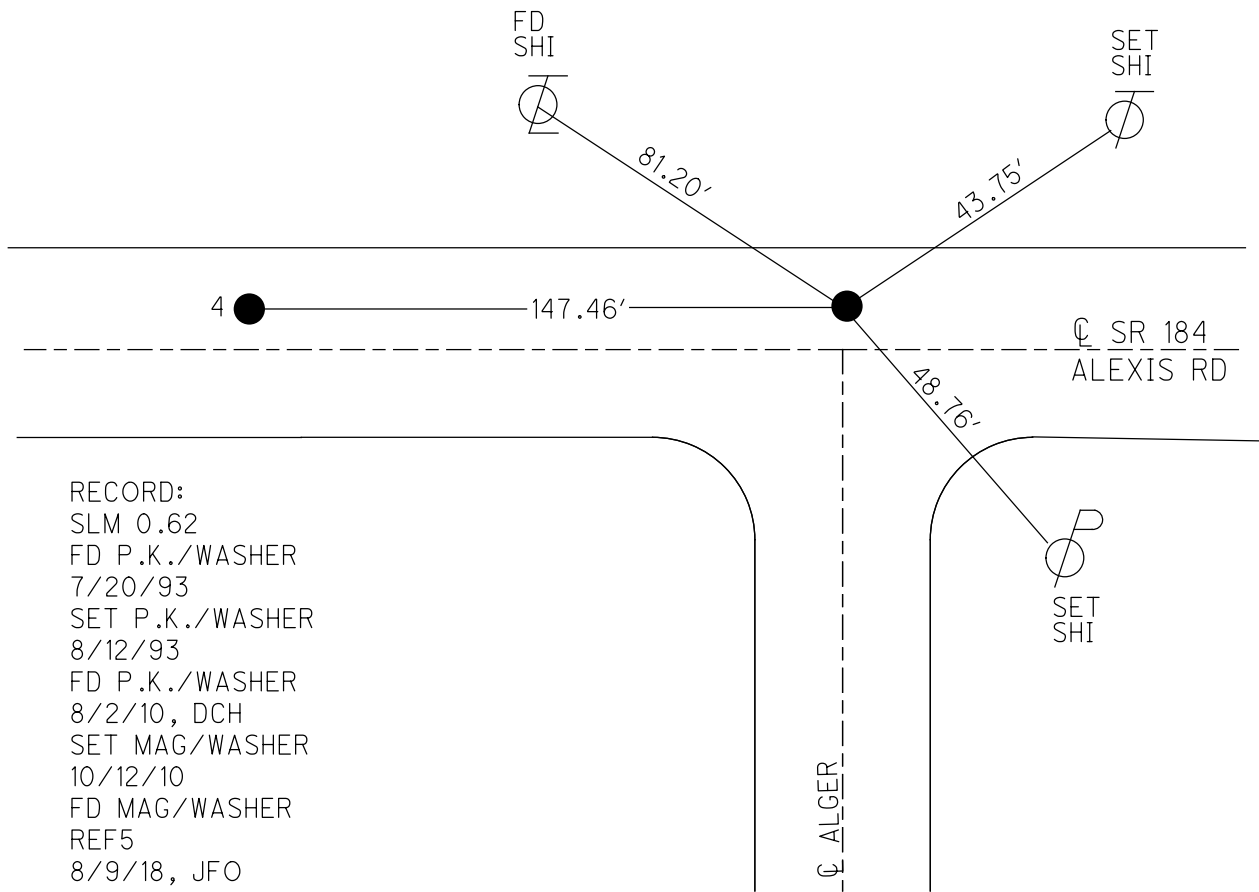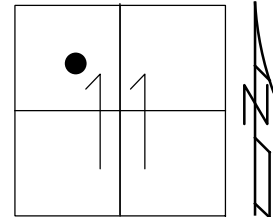

RECORD:
 SLM 0.62
 FD P.K./WASHER
 7/20/93
 SET P.K./WASHER
 8/12/93
 FD P.K./WASHER
 8/2/10, DCH
 SET MAG/WASHER
 10/12/10
 FD MAG/WASHER
 REF5
 8/9/18, JFO
 SET MAG/WASHER
 9/17/19, JFO

O.D.O.T. DISTRICT 2 SURVEY OFFICE (USE ONLY)

PERSONNEL _____

REFERENCE NO. 5

SHEET 5 OF 18

NOTES FINTEL

DATE 8/02/2010

ROUTE SR. 184

H.C. ROUSOS

WEATHER SUNNY

COUNTY LUCAS

R.C. FINTEL

TEMP. 83' F

TOWNSHIP SYLVANIA

SECTION 11

T 9 S R 6 E

TYPE MONUMENT PK/WASHER


ON SURFACE - ~~BELOW~~ ON

LEFT - ☉ PAV'T - ~~RIGHT~~ 10.0'


16.1' TO LT. EDGE PAVEMENT

S.L.M. Sta. 32+75

Grid: Northing: 748876.252 Easting: 1646445.945

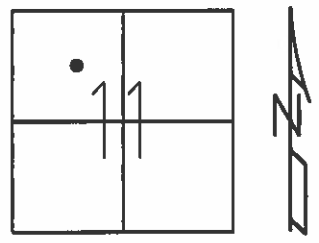

RECORD:
 SLM.0.62
 Fd. PK/Washer
 7/20/93
 SET PK/WASHER
 8/12/93
 SET MAG/WASHER
 10/12/2010

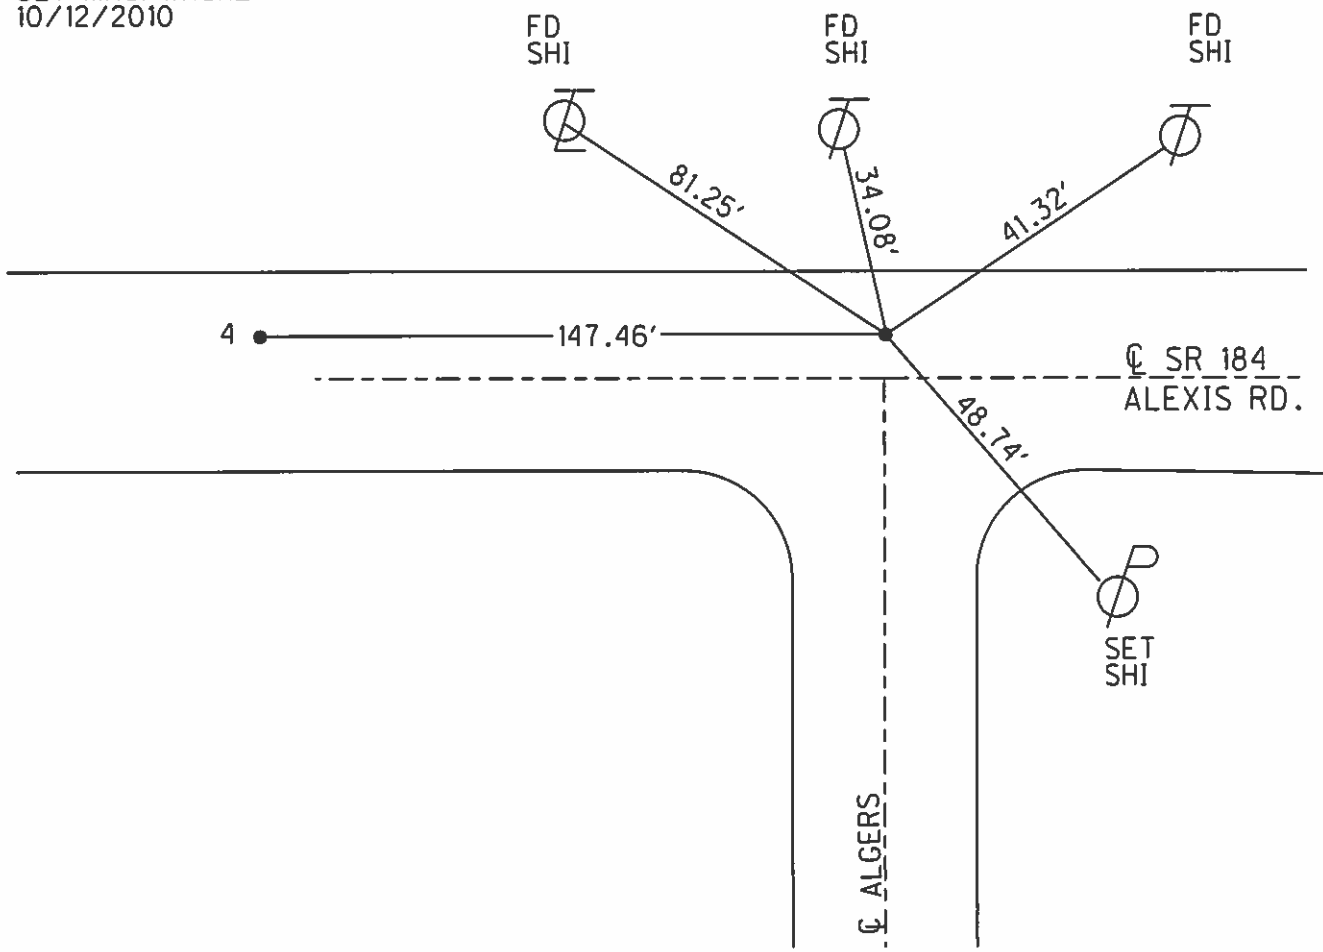

O.D.O.T. DISTRICT 2 SURVEY OFFICE

PERSONNEL _____

REFERENCE NO. 4 & 5

SHEET 4 OF 20

NOTES LOEHARKE

H.C. CORDES

R.C. ROMETO

CANTERBURY

DATE 7-20-93

WEATHER CLEAR

TEMP. +78

Set P.K./WASHERS
8-12-93

ROUTE S.R. 184

COUNTY LUCAS

TOWNSHIP _____

SECTION _____

T _____ R _____



TYPE MONUMENT BRASS ^A Mon ^B P.K Shank

ON SURFACE - BELOW 2" Below

LEFT - & PAV'T. - RIGHT 10.0

16.1 TO Lt. EDGE PAVEMENT


S.L.M. A = 31 + 28 B = 32 + 75

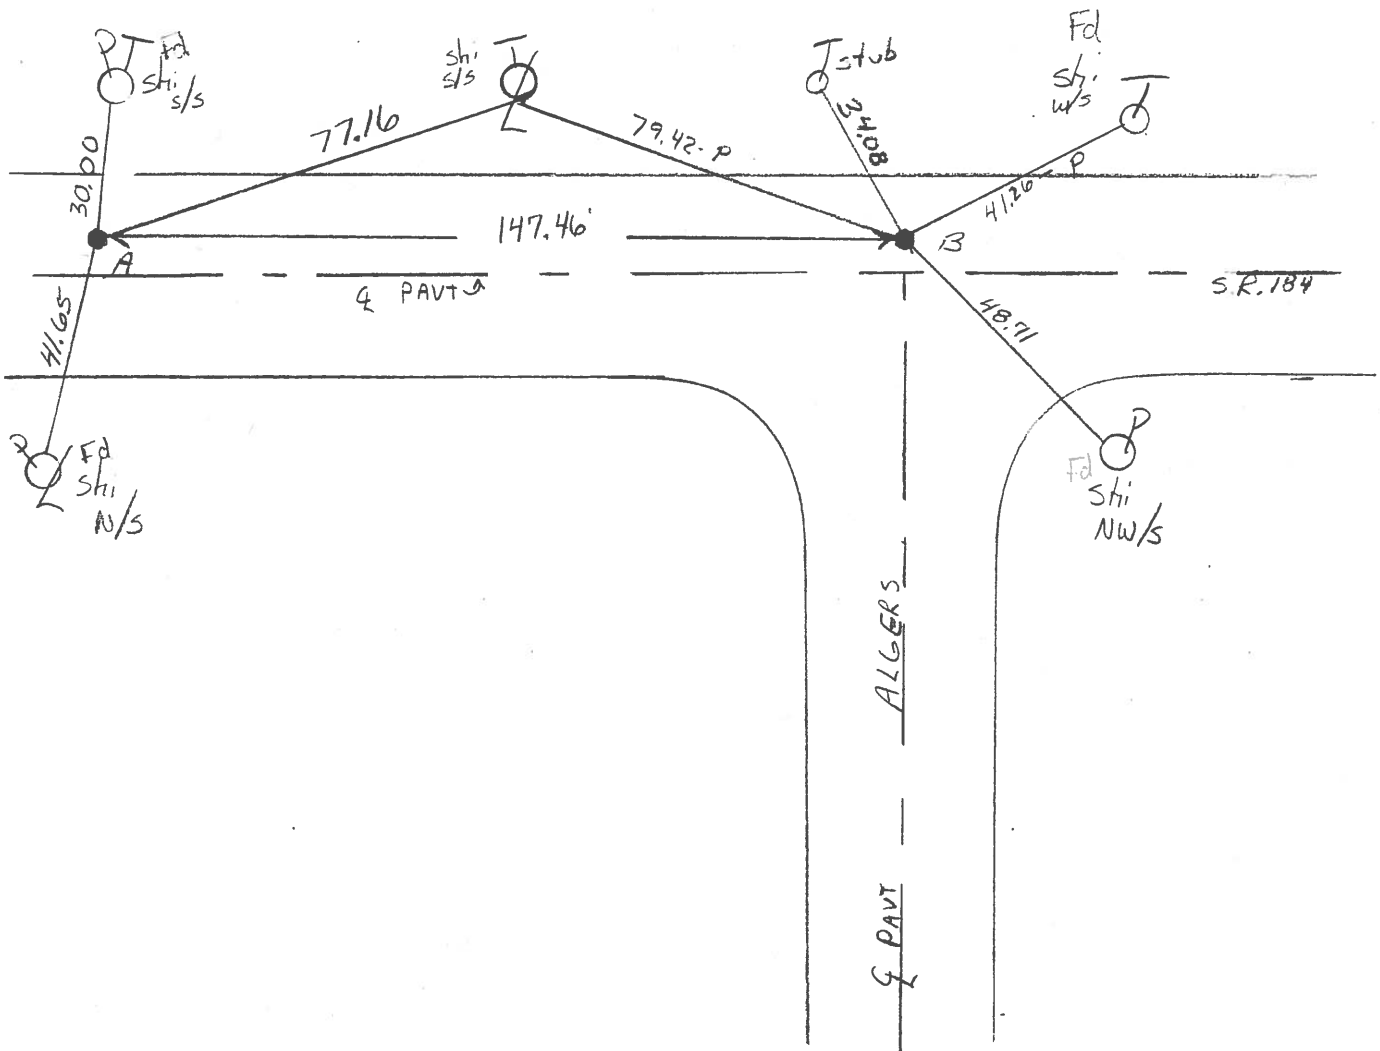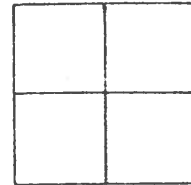

PERSONNEL	TITLE	PERSONNEL	TITLE
Stone			
Michalok			
Curtis			

COUNTY Lucas DATE 19 Feb. 76
 S. R. 184 WEATHER Cloudy
 SEC. 0100 TEMP. 35°

DESCRIPTION References to Control Points JOB NO. _____
 LEFT CENTER LINE RIGHT

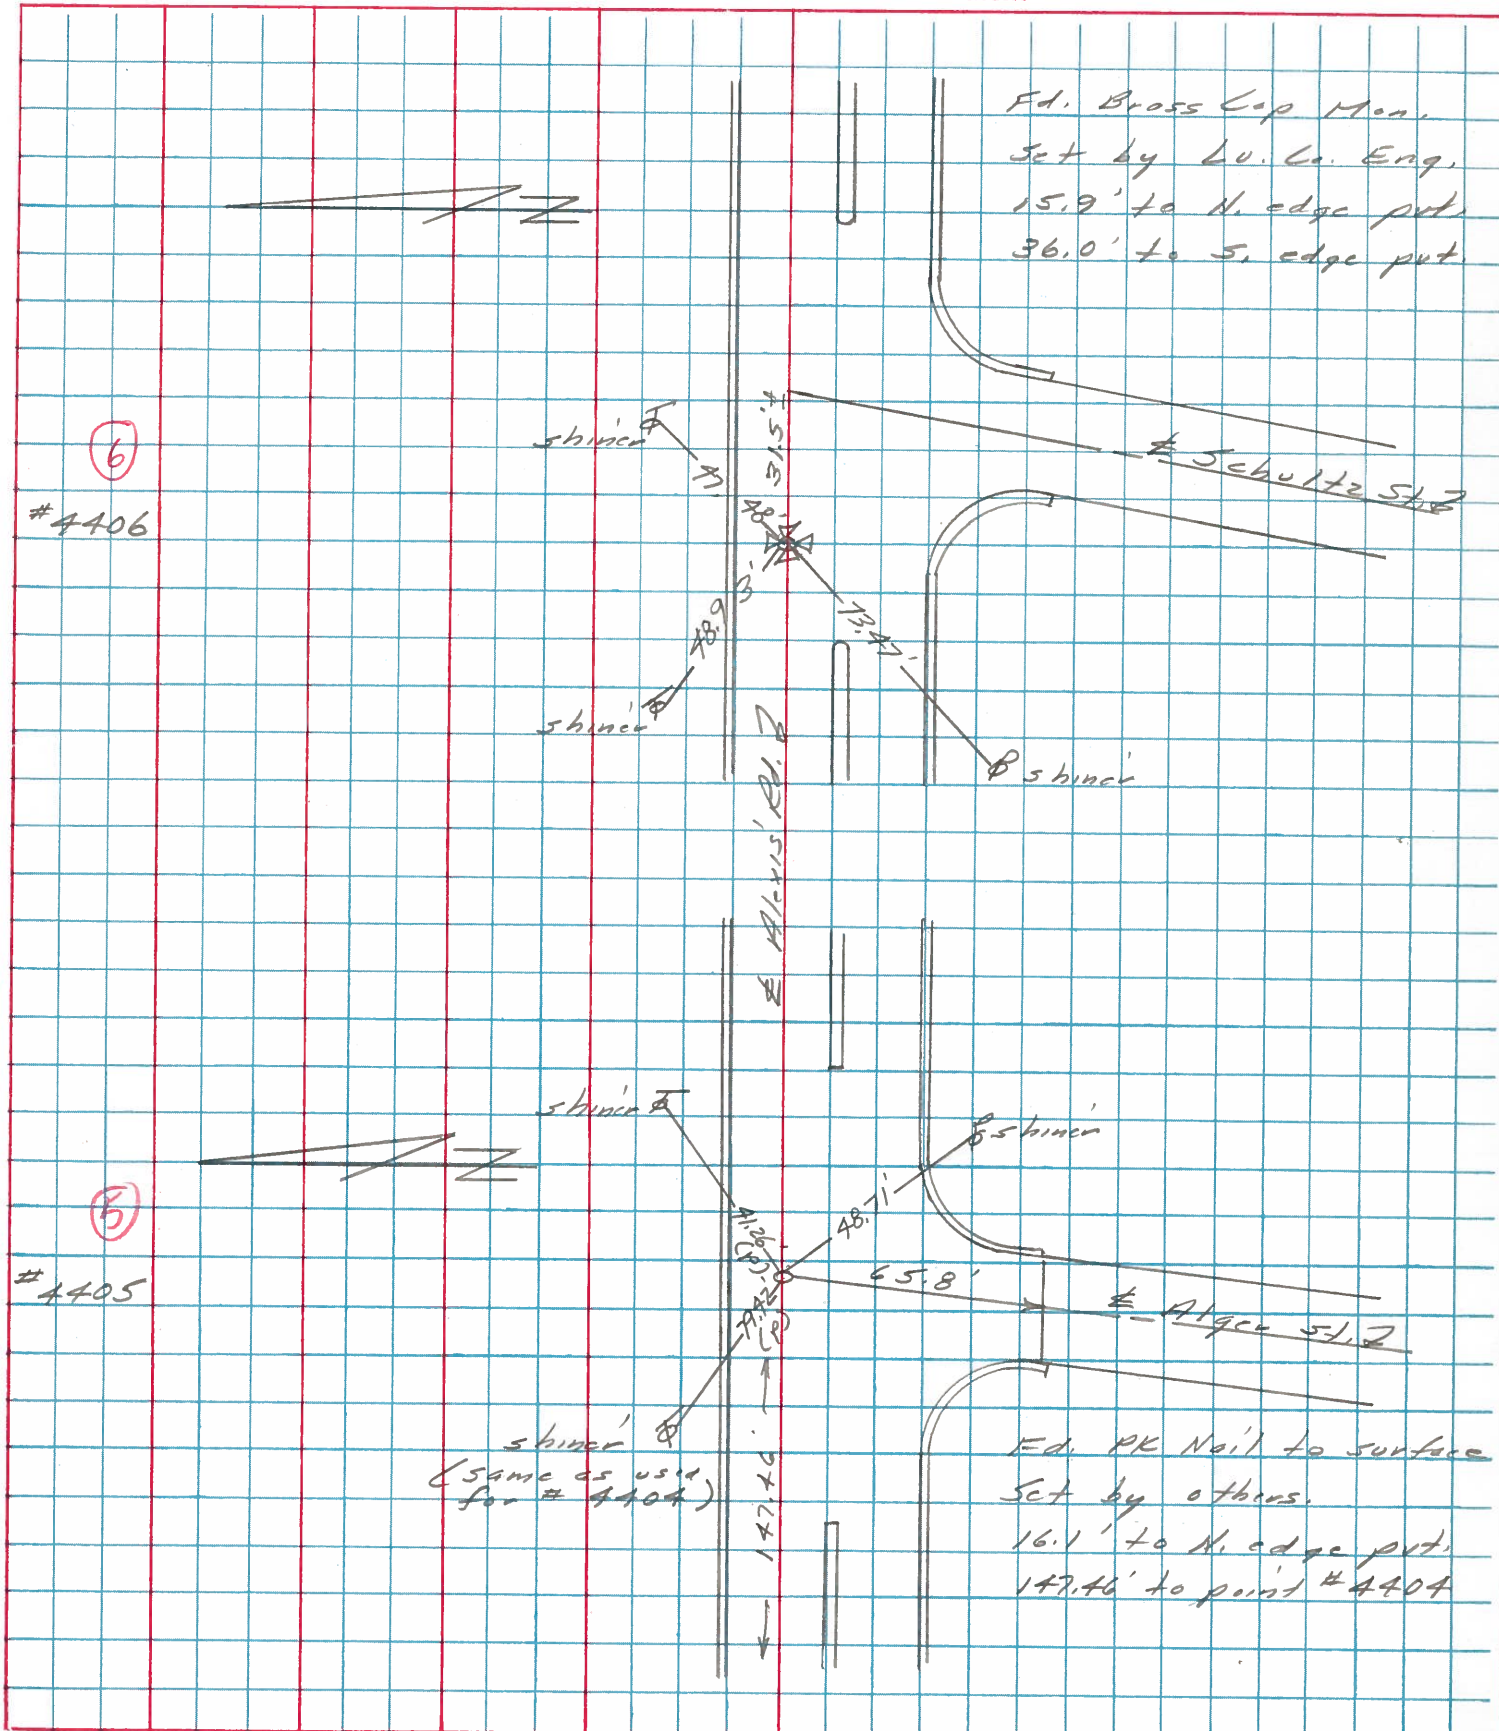

PERSONNEL	TITLE	PERSONNEL	TITLE	COUNTY	DATE
Stone	Notes			Lucas	18 June 68
Beck	Flag			S. R. 24.25 Bypass	WEATHER Fair
Michalak	Tape			SEC. Alexis Rd.	TEMP. 66°
Schroder	Tape				

DESCRIPTION References to Control Points JOB NO. _____

