

O.D.O.T. DISTRICT 2 SURVEY OFFICE (USE ONLY)

PERSONNEL

REFERENCE NO. 8 A

SHEET 9 OF 18

NOTES RHOADES

DATE 8/9/18

ROUTE SR 184

H.C. O'DONNELL

WEATHER SUNNY

COUNTY LUCAS

R.C. TRENKA

TEMP. 74°

TOWNSHIP SYLVANIA

SECTION 11

DWG BY NIESE PID 99662

T 9 N R 6 E

TYPE MONUMENT MAG/WASHER

ON SURFACE - ~~BELOW~~ ON

OFFSET Q PAVEMENT ON LT : RT

- TO - EDGE PAVEMENT


STATION: 33+34.55

HORIZ.DATUM: NAD83(2011)


GEOID: 2012A

GRID: NORTHING: 749007.031

EASTING: 1647610.497

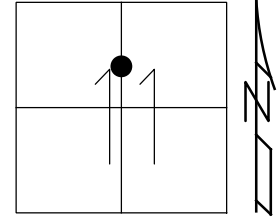


RECORD:  
 SLM 0.84  
 FD BRASS MON  
 7/20/93  
 FD BRASS MON  
 8/2/10  
 FD MAG/WASHER  
 REFA8  
 8/9/18, JFO  
 SET MAG/WASHER  
 9/17/19, JFO

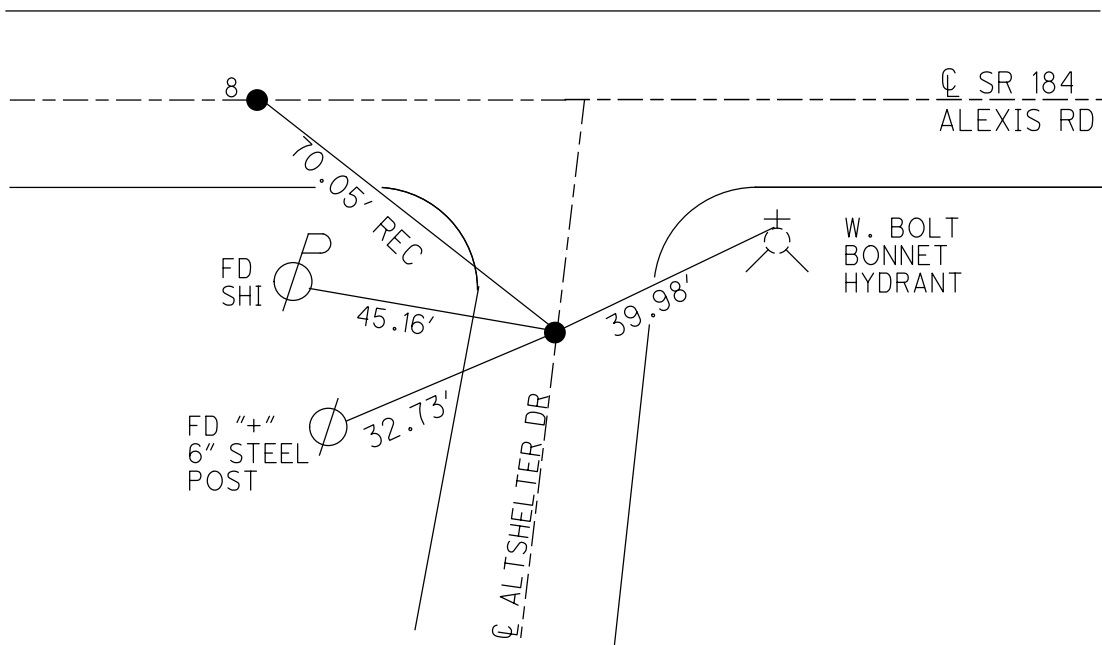

O.D.O.T. DISTRICT 2 SURVEY OFFICE (USE ONLY)

PERSONNEL _____	REFERENCE NO. <u>8 A</u>	SHEET <u>9</u> OF <u>18</u>
NOTES <u>FINTEL</u>	DATE <u>8/2/10</u>	ROUTE <u>SR. 184</u>
H.C. <u>ROUSOS</u>	WEATHER <u>SUNNY</u>	COUNTY <u>LUCAS</u>
R.C. <u>FINTEL</u>	TEMP. <u>87°F</u>	TOWNSHIP <u>SYLVANIA</u>
_____	_____	SECTION <u>11</u>
_____	_____	T. <u>9</u> S R. <u>6</u> E

TYPE MONUMENT BRASS MONUMENT  
 ON SURFACE - ~~BELOW~~ ON  
~~LEFT -~~ CL PAV'T - ~~RIGHT~~ ON  
TO EDGE PAVEMENT  
 S.L.M. 43+93

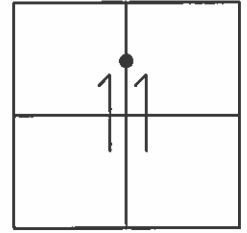

Grid: Northing: 749007.041 Easting: 1647610.346

RECORD:  
 SLM. 0.84  
 FD. BRASS MONUMENT  
 7/20/93  
 FD. BRASS MONUMENT  
 8/2/10

