

O.D.O.T. DISTRICT 2 SURVEY OFFICE (USE ONLY)

PERSONNEL

REFERENCE NO. 10

SHEET 11 OF 18

NOTES RHOADES DATE 8/9/18
 H.C. O'DONNELL WEATHER SUNNY
 R.C. TRENKA TEMP. 74°

ROUTE SR 184
 COUNTY LUCAS
 TOWNSHIP SYLVANIA
 SECTION 11

DWG BY NIESE PID 99662

T 9 N R 6 E

TYPE MONUMENT MAG/WASHER

ON SURFACE - ~~BELOW~~ ON

OFFSET CL PAVEMENT 10.2' LT : ~~RT~~

16.0' TO LT EDGE PAVEMENT


STATION: 43+23.11

HORZ.DATUM: NAD83(2011)


GEOID: 2012A

GRID: NORTHING: 749203.086

EASTING: 1648586.543

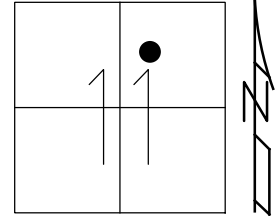


RECORD:
 SLM 1.03
 FD SHANK
 BRASS MON
 2" DOWN
 7/20/93
 8/2/10, DCH
 SET P.K./WASHER
 8/12/93
 SET MAG/WASHER
 10/13/10
 FD MAG/WASHER
 REF10
 8/9/18, JFO
 SET MAG/WASHER
 9/17/19, JFO

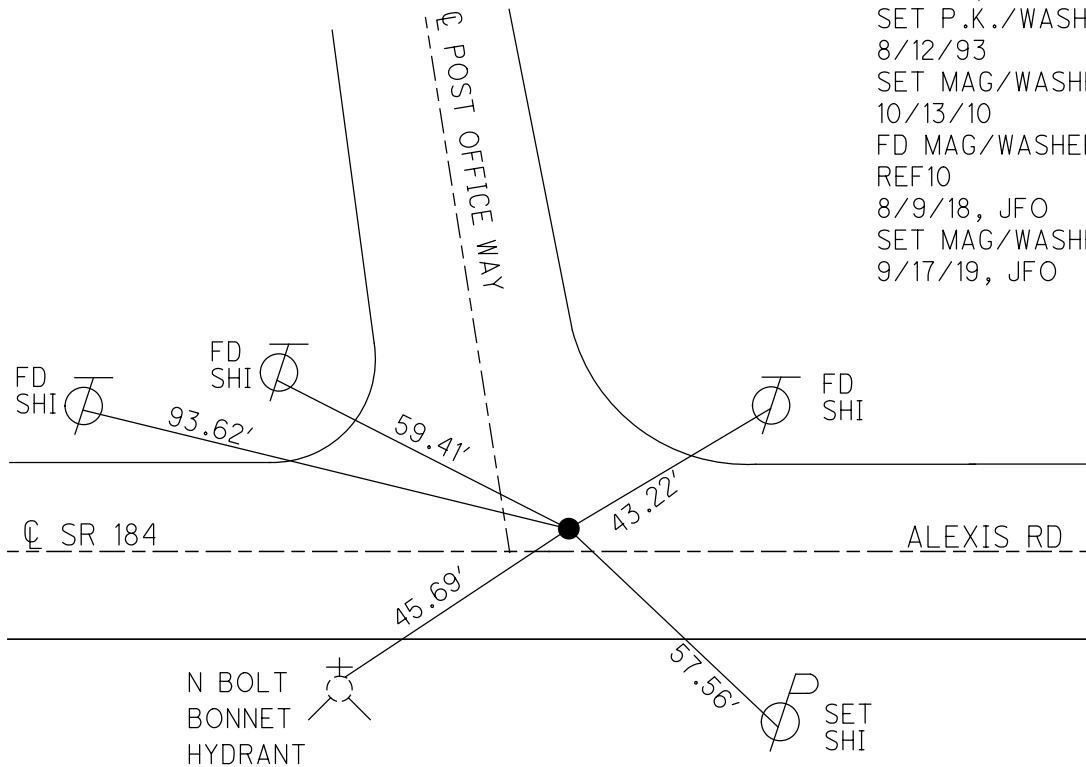

O.D.O.T. DISTRICT 2 SURVEY OFFICE (USE ONLY)

PERSONNEL _____ REFERENCE NO. 10 SHEET 11 OF 18
 NOTES FINTEL DATE 8/2/10 ROUTE SR. 184
 H.C. ROUSOS WEATHER SUNNY COUNTY LUCAS
 R.C. FINTEL TEMP. 88°F TOWNSHIP SYLVANIA
 _____ SECTION 11
 _____ T 9 S R 6 E


TYPE MONUMENT SHANK OF BRASS MON.
~~ON SURFACE~~ - BELOW 2"
 LEFT - ☉ PAV'T - ~~RIGHT~~ 10.2'
16.0' TO LT. EDGE PAVEMENT
 S.L.M. 54+41

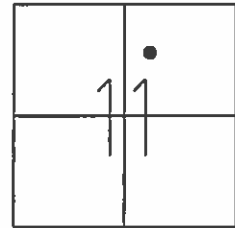

Grid: Northing: 749203.060 Easting: 1648586.383

RECORD:

SLM. 1.03
 FD. SHANK OF
 BRASS MONUMENT
 2" DOWN
 7/20/93
 SET PK/WASHER
 8/12/93
 SETMAG NAIL/WASHER
 10/13/10

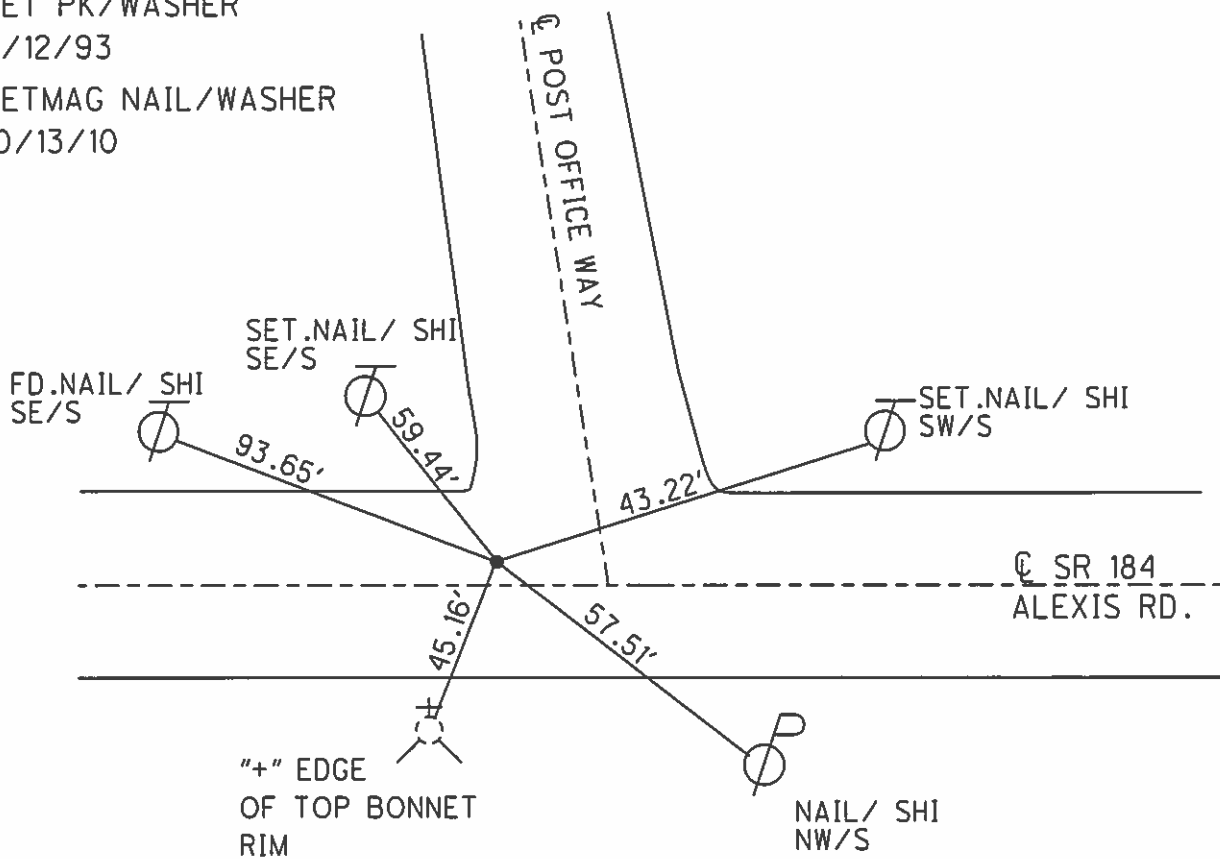

O.D.O.T. DISTRICT 2 SURVEY OFFICE

PERSONNEL _____

REFERENCE NO. 10

SHEET 9 OF 20

NOTES LOEHRKE

H.C. CORDES

R.C. ROMETO

CANTERBURY

DATE 7-20-93

WEATHER CLEAR

TEMP. +80

Set P.I.K./WASHER

8-12-93

ROUTE S.R. #184

COUNTY LUCAS

TOWNSHIP _____

SECTION _____

T. _____ R. _____



TYPE MONUMENT SHANK of BRASS Mon

~~ON~~ SURFACE - BELOW 2"

LEFT- & PAV'T. - ~~RIGHT~~ 10.2'

160 TO LT EDGE PAVEMENT CURB

S.L.M. 54 + 41

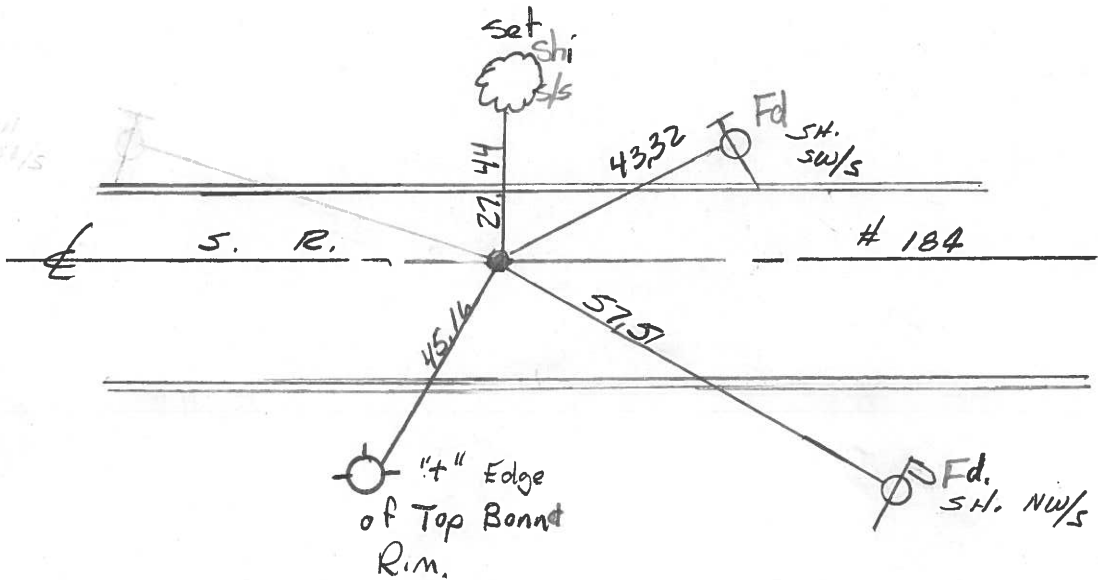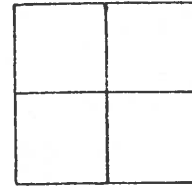

PERSONNEL TITLE PERSONNEL TITLE

Stone
Michalak
Curtis

COUNTY Lucas

DATE 19 Feb. 76

S. R. 187

WEATHER Cloudy


SEC.

TEMP. 37°

DESCRIPTION

References to Control Points
LEFT CENTER LINE RIGHT

JOB NO.

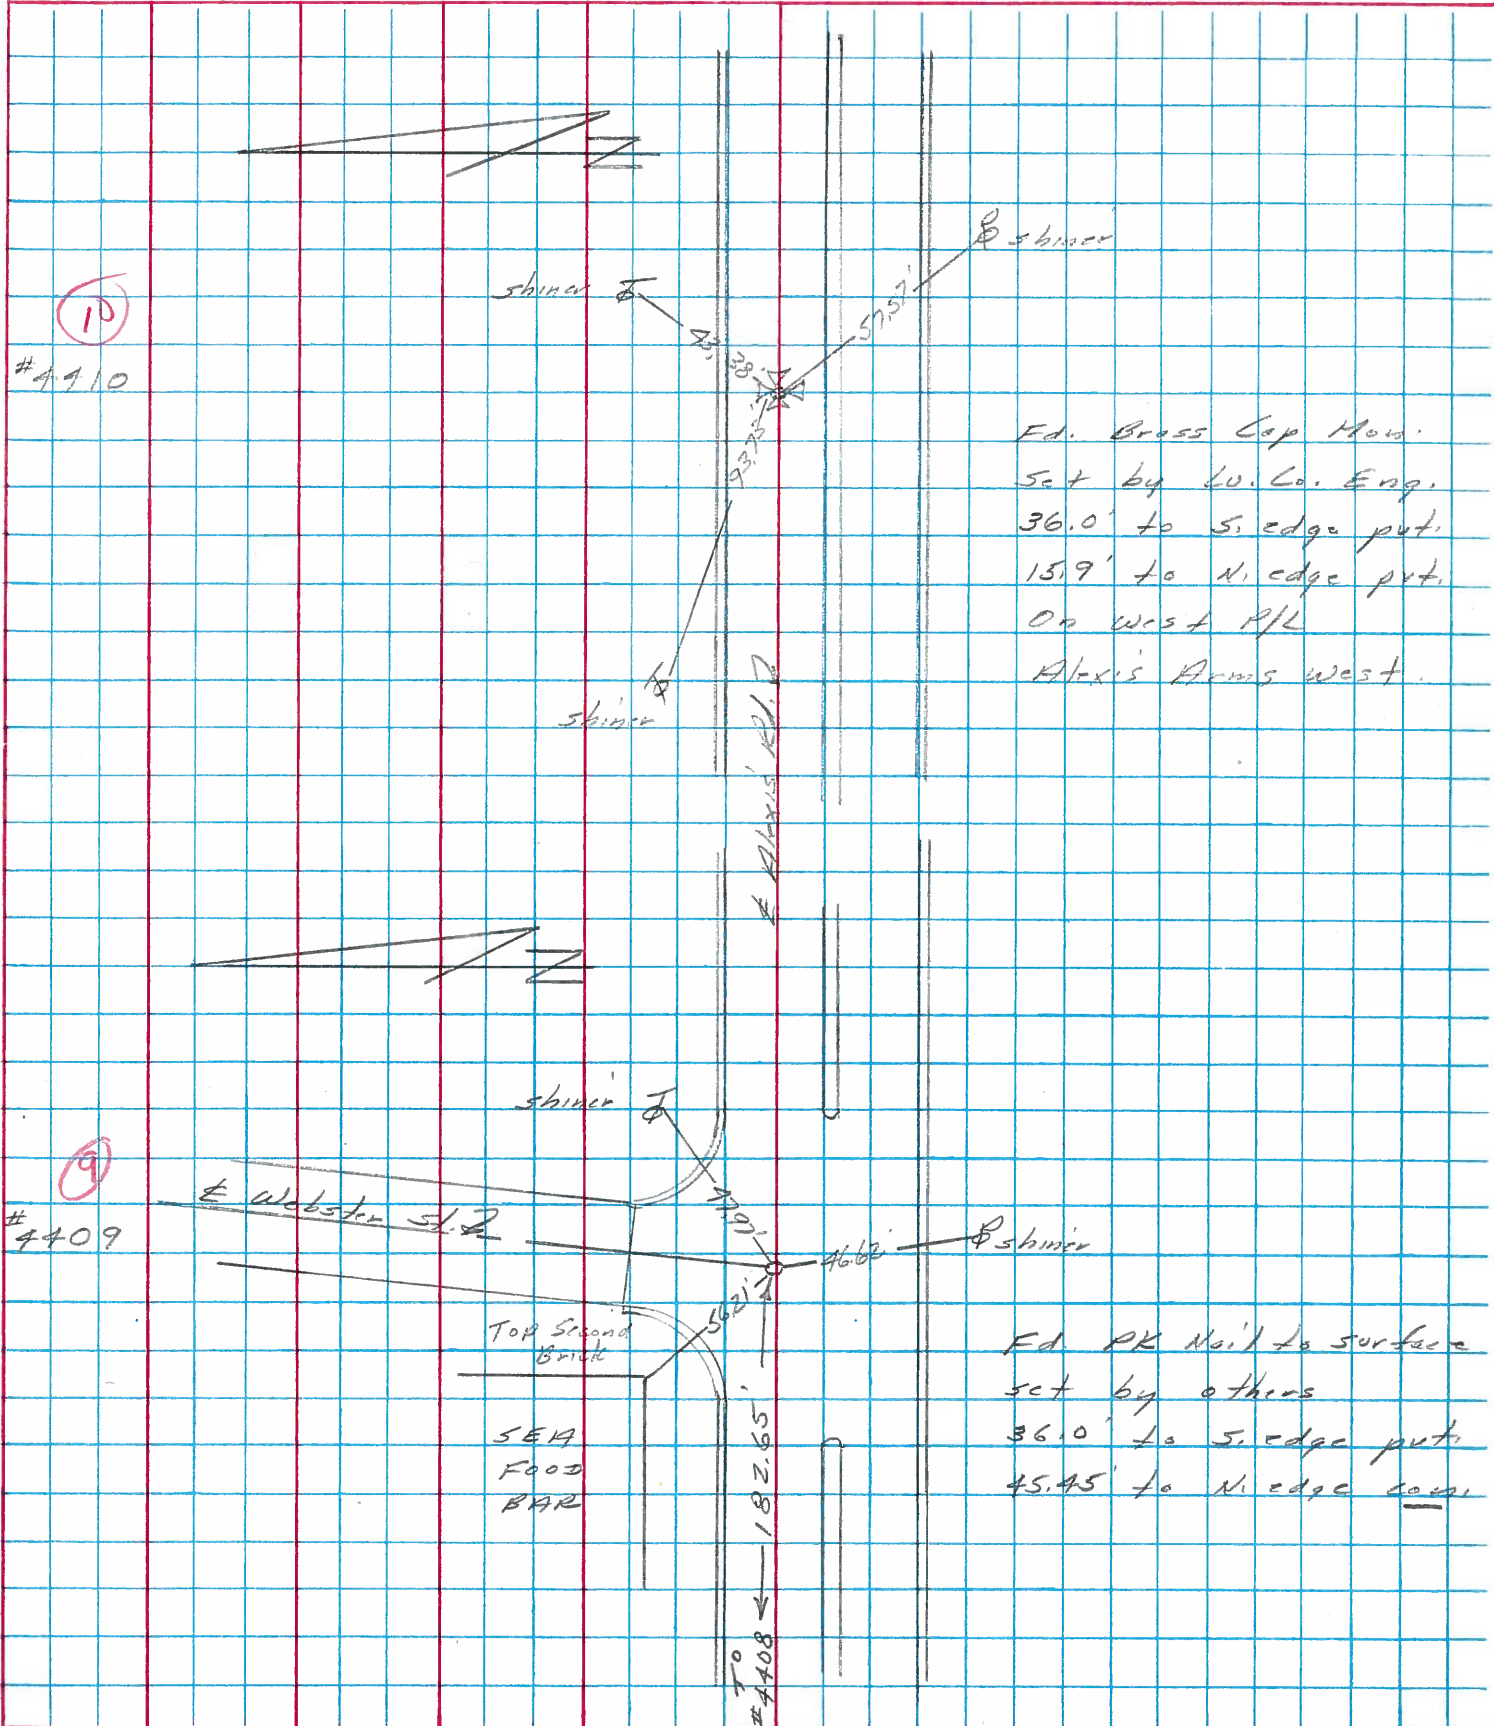

PERSONNEL	TITLE	PERSONNEL	TITLE	COUNTY	DATE	WEATHER	TEMP.
Stone	Notes			Lucas	18 June 68	Fair	72°
Beck	Flag			S. R. 29.25 th By Pass			
Michalak	Tape			SEC. Alexis Rd.			
Schroder	Tape						

DESCRIPTION References to Control Points JOB NO. _____

