

O.D.O.T. DISTRICT 2 SURVEY OFFICE (USE ONLY)

PERSONNEL

REFERENCE NO. 14

SHEET 15 OF 18

NOTES RHOADES

DATE 8/9/18

ROUTE SR 184

H.C. O'DONNELL

WEATHER SUNNY

COUNTY LUCAS

R.C. TRENKA

TEMP. 80°

TOWNSHIP SYLVANIA

SECTION 12

DWG BY NIESE

PID 99662

T 9 N R 6 E

TYPE MONUMENT P.K./WASHER

ON SURFACE - ~~BELOW~~ ON

OFFSET \odot PAVEMENT 10.2' ~~LT~~ : RT

16.2' TO LT EDGE PAVEMENT


STATION: 66+43.19

HORZ.DATUM: NAD83(2011)


GEOID: 2012A

GRID: NORTHING: 749555.430

EASTING: 1650879.699

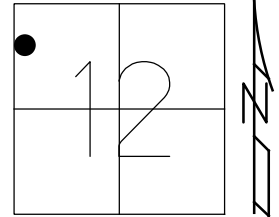

RECORD:
 SLM 1.48
 SET P.K./WASHER
 8/4/93
 FD BRASS MON
 LUCAS CO. ENGR.
 6" DOWN
 8/4/10, DCH
 FD P.K./WASHER
 REF14
 7/5/18, JFO
 SET MAG/WASHER
 9/17/19, JFO

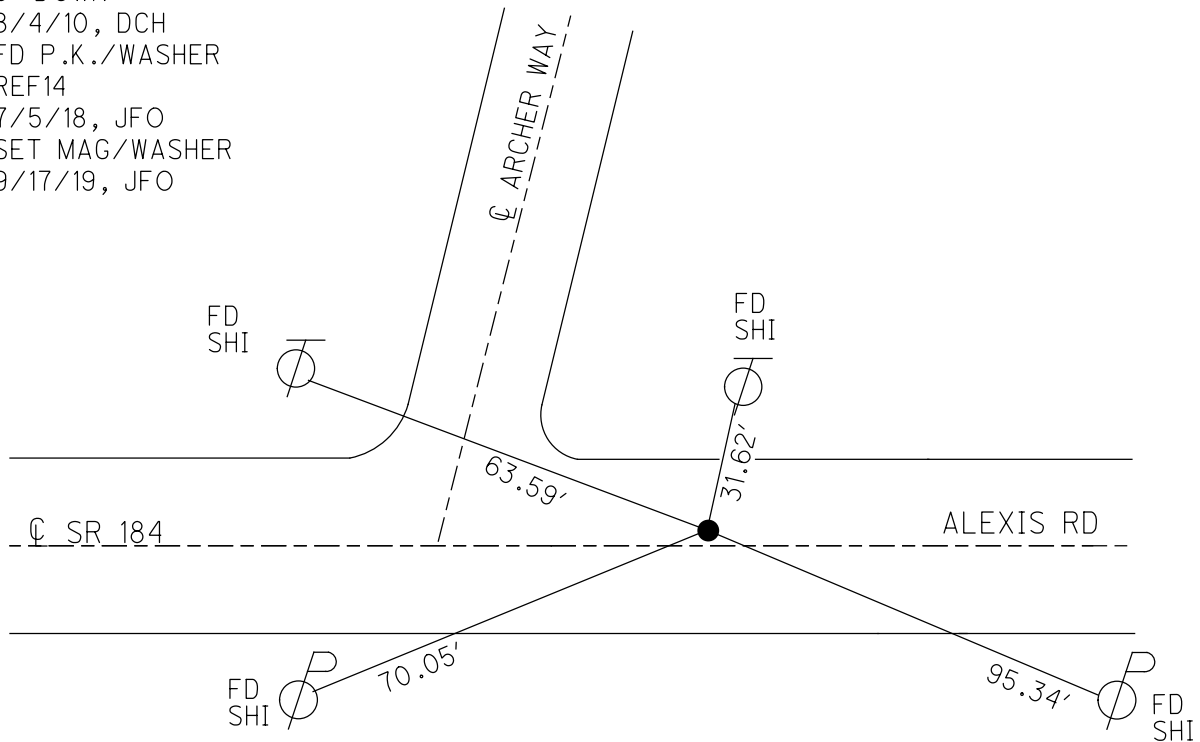

O.D.O.T. DISTRICT 2 SURVEY OFFICE (USE ONLY)

PERSONNEL	REFERENCE NO. <u>14</u>	SHEET <u>15</u> OF <u>18</u>
NOTES <u>HOMAN</u>	DATE <u>8/4/10</u>	ROUTE <u>SR. 184</u>
H.C. <u>ROUSOS</u>	WEATHER <u>SUNNY</u>	COUNTY <u>LUCAS</u>
R.C. <u>FINTEL</u>	TEMP. <u>80° F</u>	TOWNSHIP <u>SYLVANIA</u>
		SECTION <u>12</u>
		T <u>9</u> S R <u>6</u> E


TYPE MONUMENT BRASS MON.- LUCAS CO. ENG.

~~ON SURFACE~~ - BELOW 6"


LEFT - Q PAV'T - ~~RIGHT~~ 10.2'
16.2' TO LT. EDGE PAVEMENT

S.L.M. 77+61

Grid: Northing: 749555.377 Easting: 1650879.534

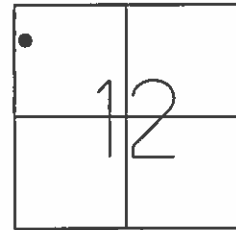

RECORD;
 SLM.1.48
 SET PK/ WASHER
 8/4/93

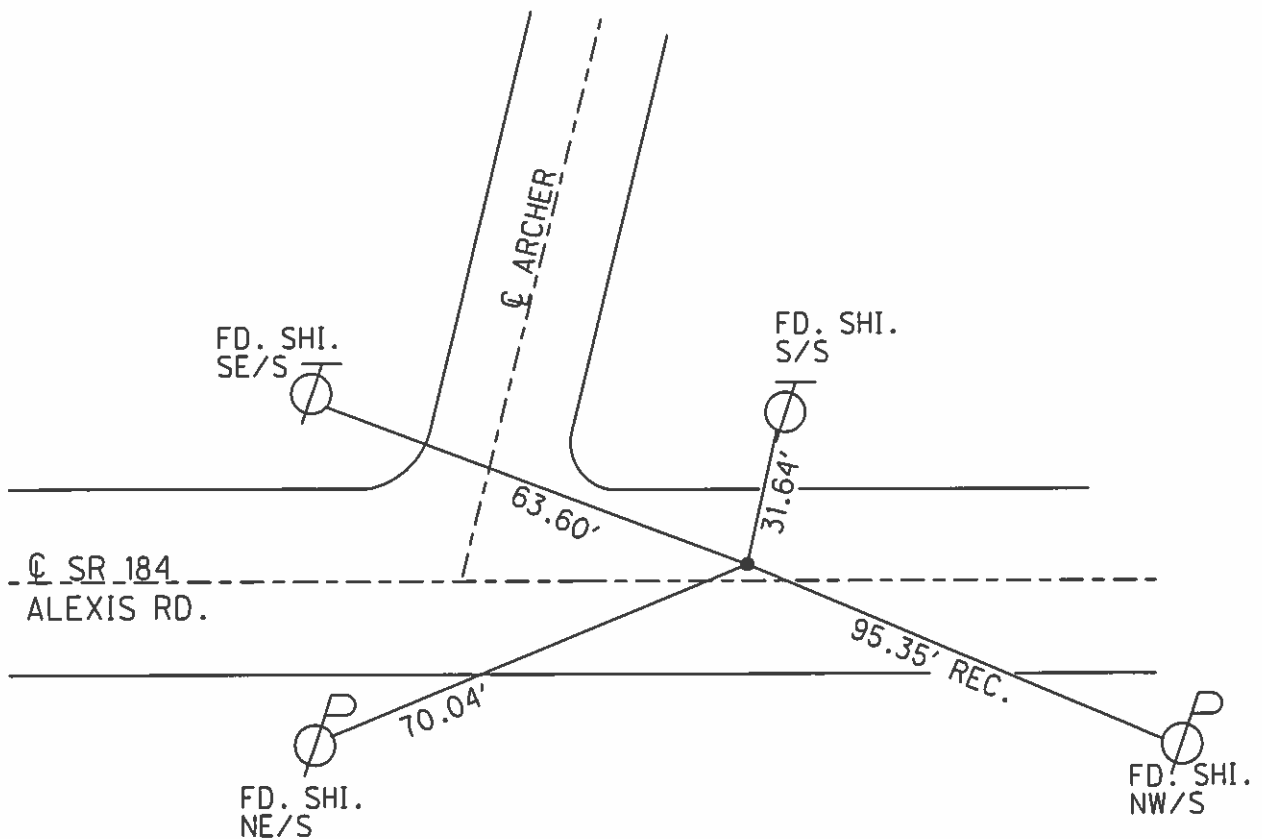

O.D.O.T. DISTRICT 2 SURVEY OFFICE

PERSONNEL _____

REFERENCE NO. 14

SHEET 13 OF 20

NOTES LOEHKE

H.C. CORDES

R.C. ROMETO

CANTERBURY

DATE 7-19-93

WEATHER CLOUDY

TEMP. +82

SET P.K./WASHER

8-11-93

ROUTE S.R. #184

COUNTY LUCAS

TOWNSHIP _____

SECTION _____

T _____ R _____



TYPE MONUMENT BRASS MON - LUCAS Co. Eng.

~~ON~~ SURFACE - BELOW 2"

LEFT - C PAV'T. - RIGHT 10.2'

16.2 TO Lt EDGE PAVEMENT


S.L.M. 77+ 61

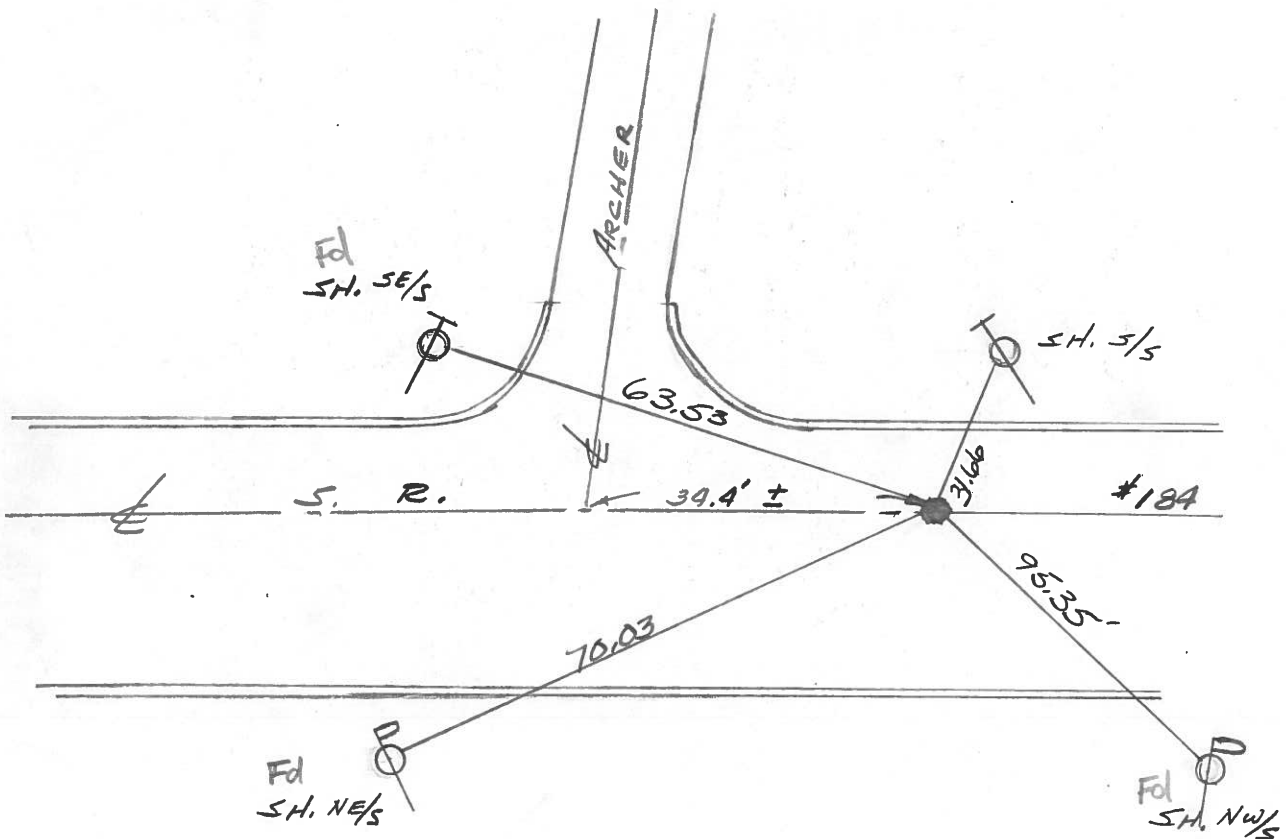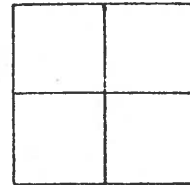

PERSONNEL	TITLE	PERSONNEL	TITLE	COUNTY	DATE
Stone				Lucas	20 Feb. 76
Michalak				S. R. 187	WEATHER Clear
Curtis				SEC. 1.00	TEMP. 33°

DESCRIPTION References to Control Points JOB NO. _____

LEFT CENTER LINE RIGHT

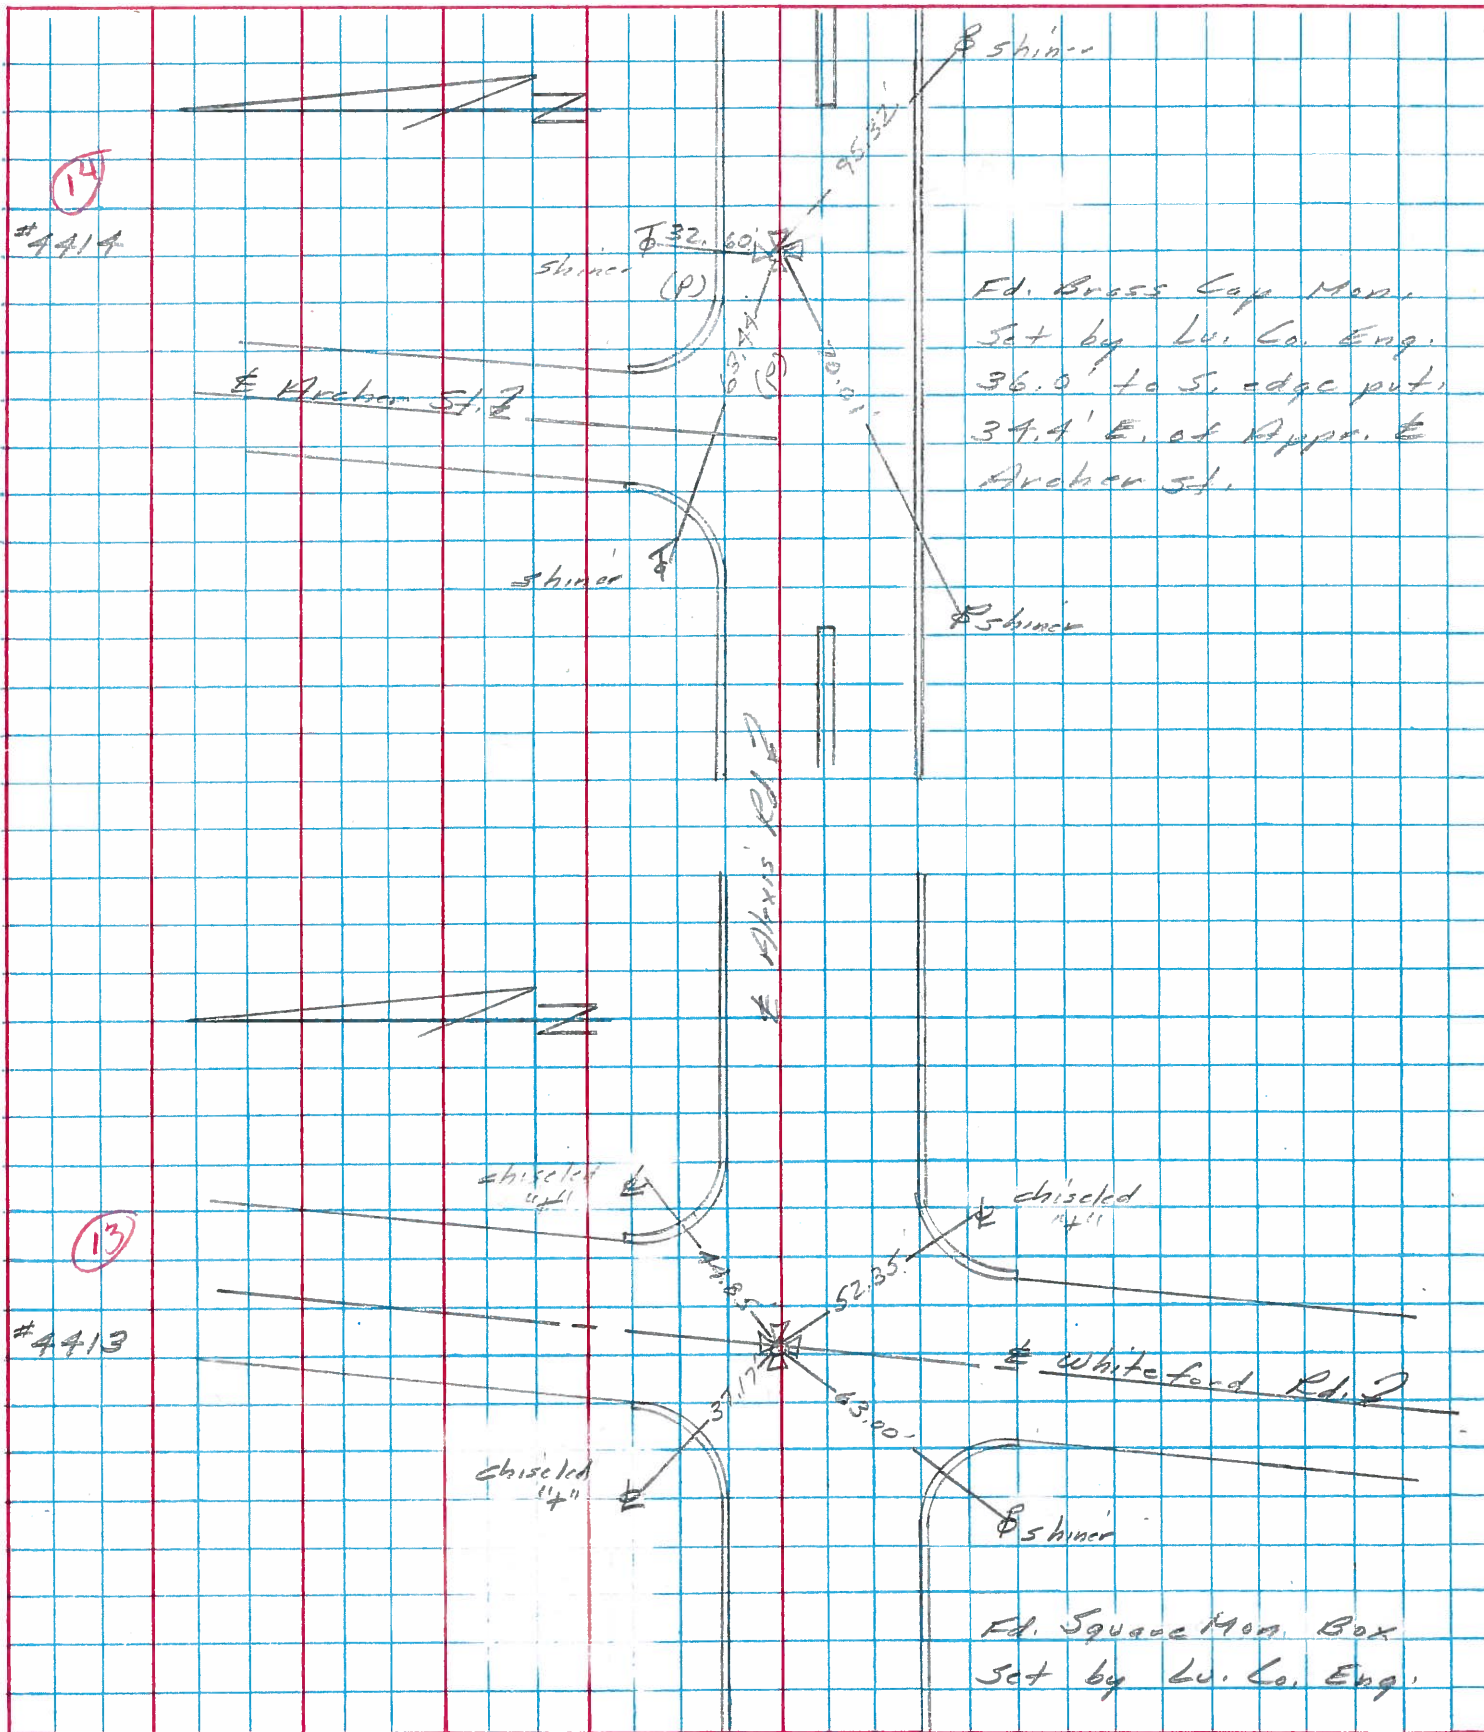

PERSONNEL	TITLE	PERSONNEL	TITLE
S. Jones	Notes		
Boek	Flag		
Michaelak	Tape		
Schroder	Tape		

COUNTY Lucas DATE 28 June 68
 S. R. 24-25 By Pass WEATHER Good
 SEC. Alexis Rd. TEMP. 82°

DESCRIPTION References to Control Points JOB NO. _____

