

O.D.O.T. DISTRICT 2 SURVEY OFFICE (USE ONLY)

PERSONNEL

REFERENCE NO. 16

SHEET 17 OF 18

NOTES RHOADES

DATE 8/9/18

ROUTE SR 184

H.C. O'DONNELL

WEATHER SUNNY

COUNTY LUCAS

R.C. TRENKA

TEMP. 80°F

TOWNSHIP SYLVANIA

SECTION 12

DWG BY NIESE

PID 99662

T 9 N R 6 E

TYPE MONUMENT MAG/WASHER

ON SURFACE - ~~BELOW~~ ON

OFFSET \bar{C} PAVEMENT 10.2' LT : ~~RT~~

16.0' TO LT EDGE PAVEMENT


STATION: 73+27.47

HORZ.DATUM: NAD83(2011)


GEOID: 2012A

GRID: NORTHING: 749662.076

EASTING: 1651555.713

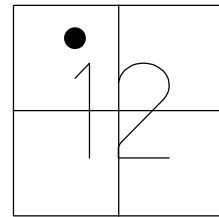


RECORD:
 SLM 1.58
 SET P.K./WASHER
 8/11/93
 FD P.K./WASHER
 6.5" DOWN
 8/4/10, DCH
 SET MAG/WASHER
 10/12/10
 FD MAG/WASHER
 REF16
 8/9/18, JFO
 SET MAG/WASHER
 9/17/19, JFO

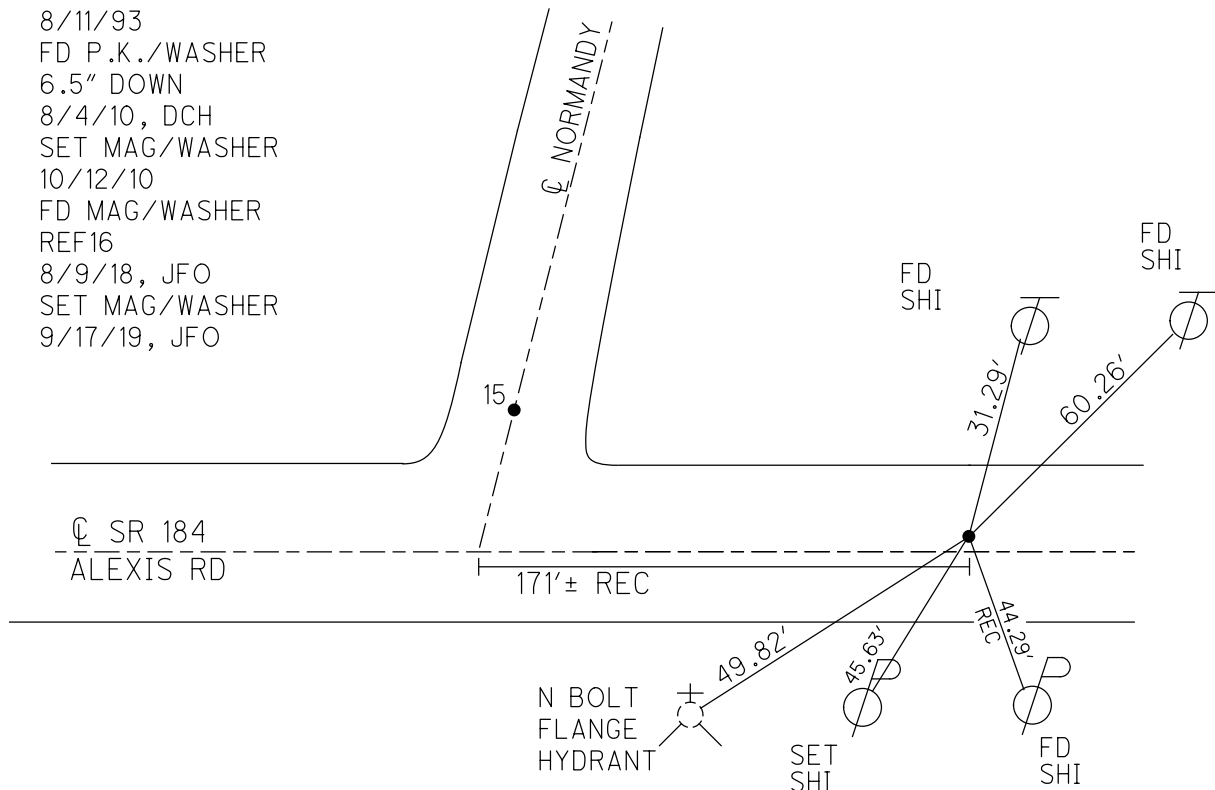


O.D.O.T. DISTRICT 2 SURVEY OFFICE (USE ONLY)

PERSONNEL	REFERENCE NO. <u>16</u>	SHEET <u>17</u> OF <u>18</u>
NOTES <u>HOMAN</u>	DATE <u>8/4/10</u>	ROUTE <u>SR. 184</u>
H.C. <u>ROUSOS</u>	WEATHER <u>SUNNY</u>	COUNTY <u>LUCAS</u>
R.C. <u>FINTEL</u>	TEMP. <u>80°F</u>	TOWNSHIP <u>SYLVANIA</u>
		SECTION <u>12</u>
		T <u>9</u> S R <u>6</u> E

TYPE MONUMENT PK/WASHER
 ON SURFACE - BELOW 6.5"
 LEFT - ☉ PAV'T - ~~RIGHT~~ 10.2'
16.0' TO LT EDGE PAVEMENT
 S.L.M. 84+46
 Grid: Northing: 749662.048 Easting: 1651555.468

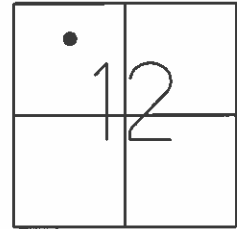

RECORD:
 SLM. 1.58
 RESET PK/WASHER
 8/11/93
 RESET MAG/WASHER
 10/12/10

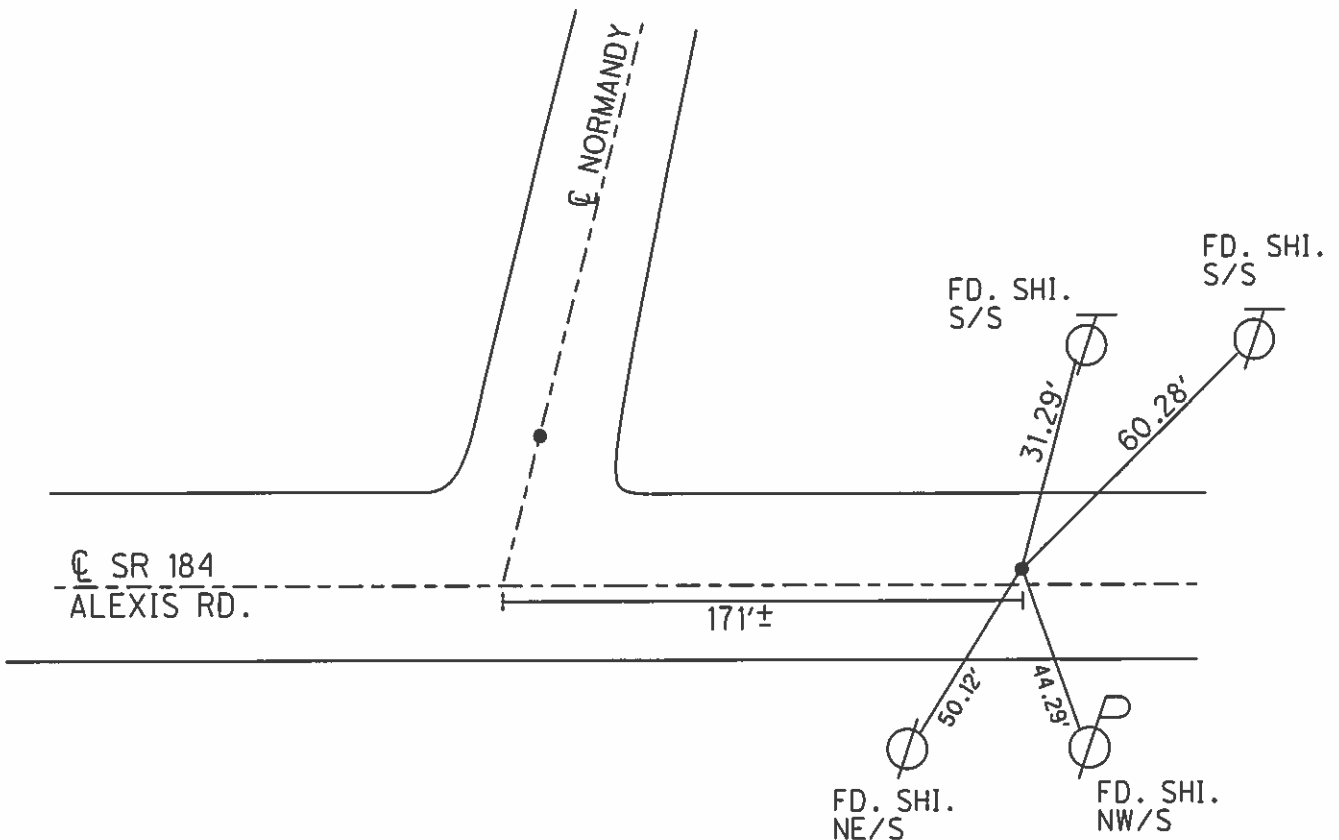

O.D.O.T. DISTRICT 2 SURVEY OFFICE

PERSONNEL _____

REFERENCE NO. 15 & 16

SHEET 14 OF 20

NOTES LOEHRKE

H.C. CORDES

R.C. ROMETO

CANTERBURY

DATE 7-19-93

WEATHER Cloudy

TEMP. +82

ROUTE S.R. #184

COUNTY LUCAS

TOWNSHIP _____

SECTION _____

T _____ R _____

"B" ⇒ Reset P.K./WASHER
8-11-93



TYPE MONUMENT BRASS MAN LUCAS Co. Eng.

ON SURFACE - BELOW 2"

LEFT - & PAV'T. - RIGHT 40.2' Lt - 10.2' Lt

B ⇒ 1/40 TO Lt EDGE PAVEMENT


S.L.M. 82 + 78 , 84 + 46

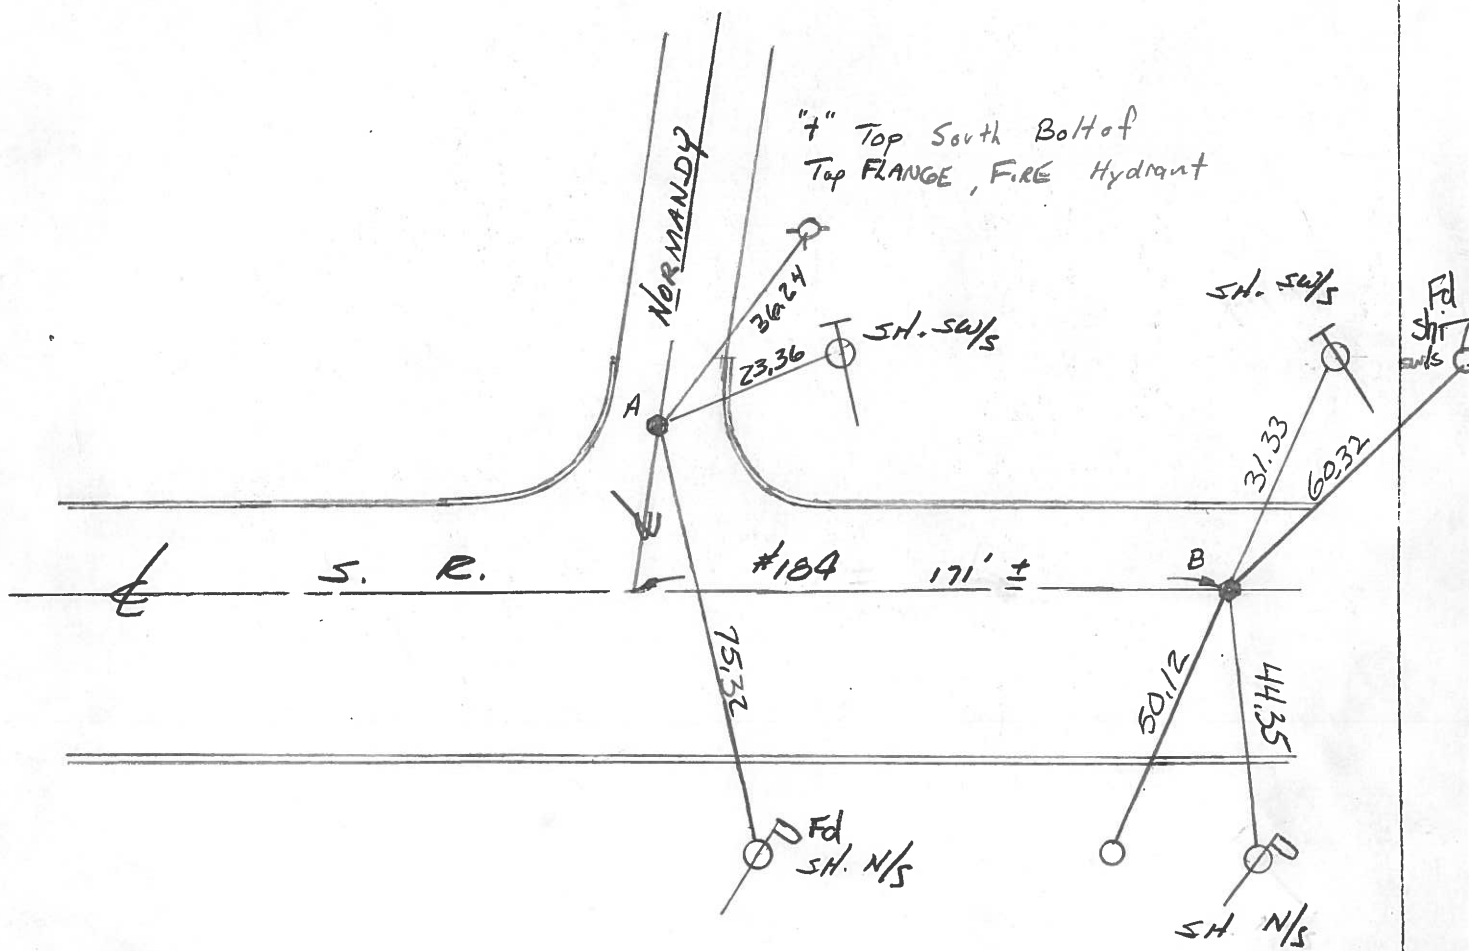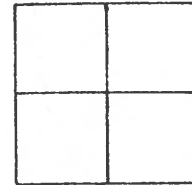

PERSONNEL	TITLE	PERSONNEL	TITLE	COUNTY	Lucas	DATE	20 Feb. 76
Stone				S. R.	184	WEATHER	Clear
Curtis				SEC.	1.50	TEMP.	37°
Michalek							

DESCRIPTION References to Control Points JOB NO. _____

LEFT CENTER LINE RIGHT

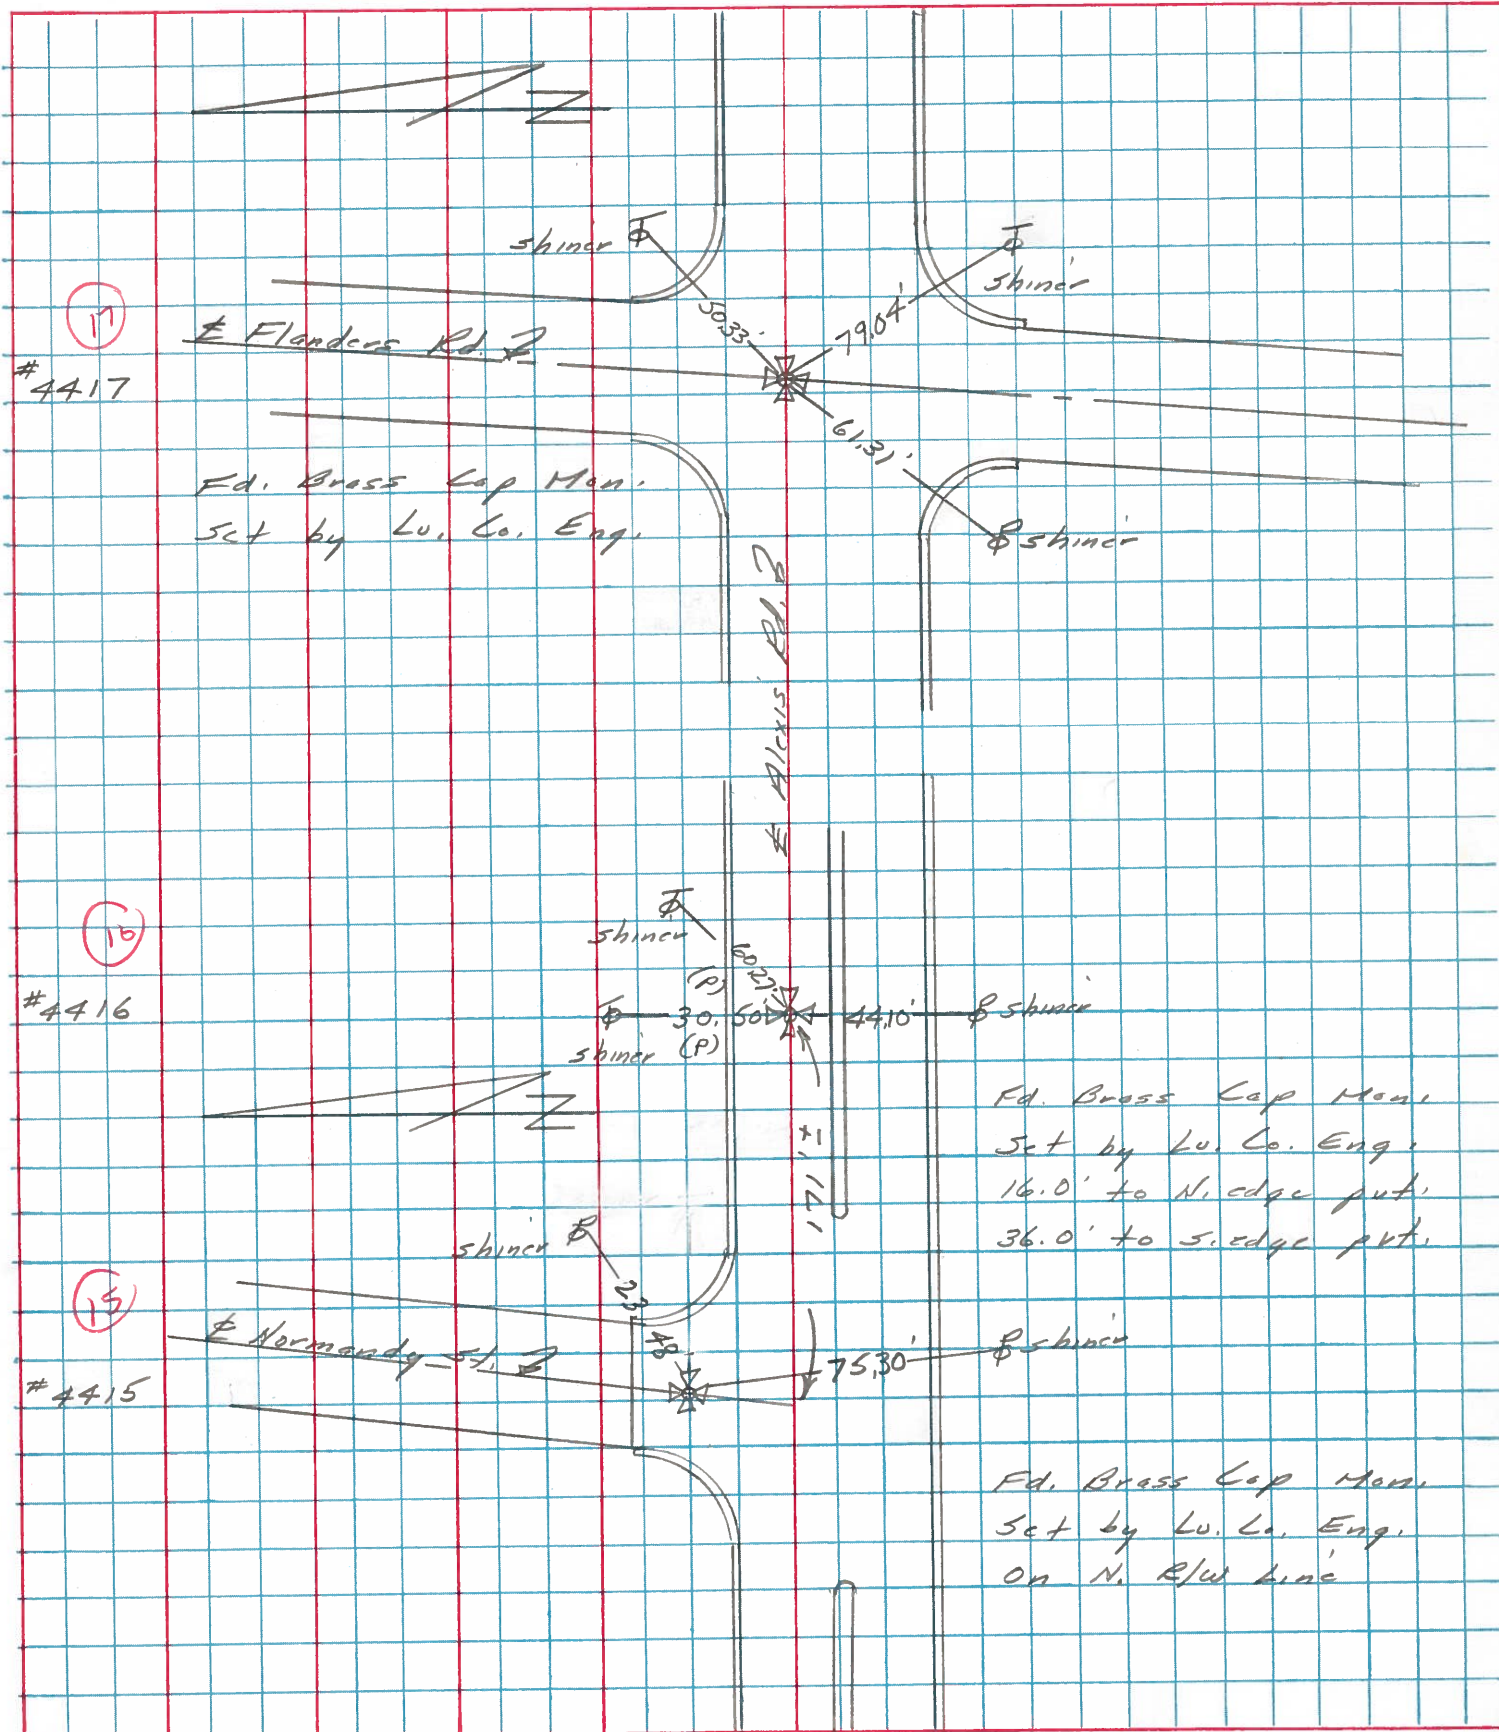

PERSONNEL	TITLE	PERSONNEL	TITLE	COUNTY	DATE	WEATHER	TEMP.
Stone	Notes			Lucas	28 June 68	Cool	63°
Beck	Flag			S. R. 24-25 Bypass			
Michalak	Tape			SEC. Alexis Rd.			
Schroder	Tape						

DESCRIPTION References to Control Points JOB NO. _____

