

O.D.O.T. DISTRICT 2 SURVEY OFFICE (USE ONLY)

PERSONNEL

REFERENCE NO. 17

SHEET 18 OF 18

NOTES RHOADES

DATE 8/9/18

ROUTE SR 184

H.C. O'DONNELL

WEATHER SUNNY

COUNTY LUCAS

R.C. TRENKA

TEMP. 80°F

TOWNSHIP SYLVANIA

DWG BY NIESE PID 99662

SECTION 12

T 9 N R 6 E

TYPE MONUMENT MAG/WASHER

ON SURFACE - ~~BELOW~~ ON

OFFSET CL PAVEMENT 10.0' LT : ~~RT~~

- TO - EDGE PAVEMENT



STATION: 86+96.70

HORIZ.DATUM: NAD83(2011)

GEOID: 2012A

GRID: NORTHING: 749869.055


EASTING: 1652909.147

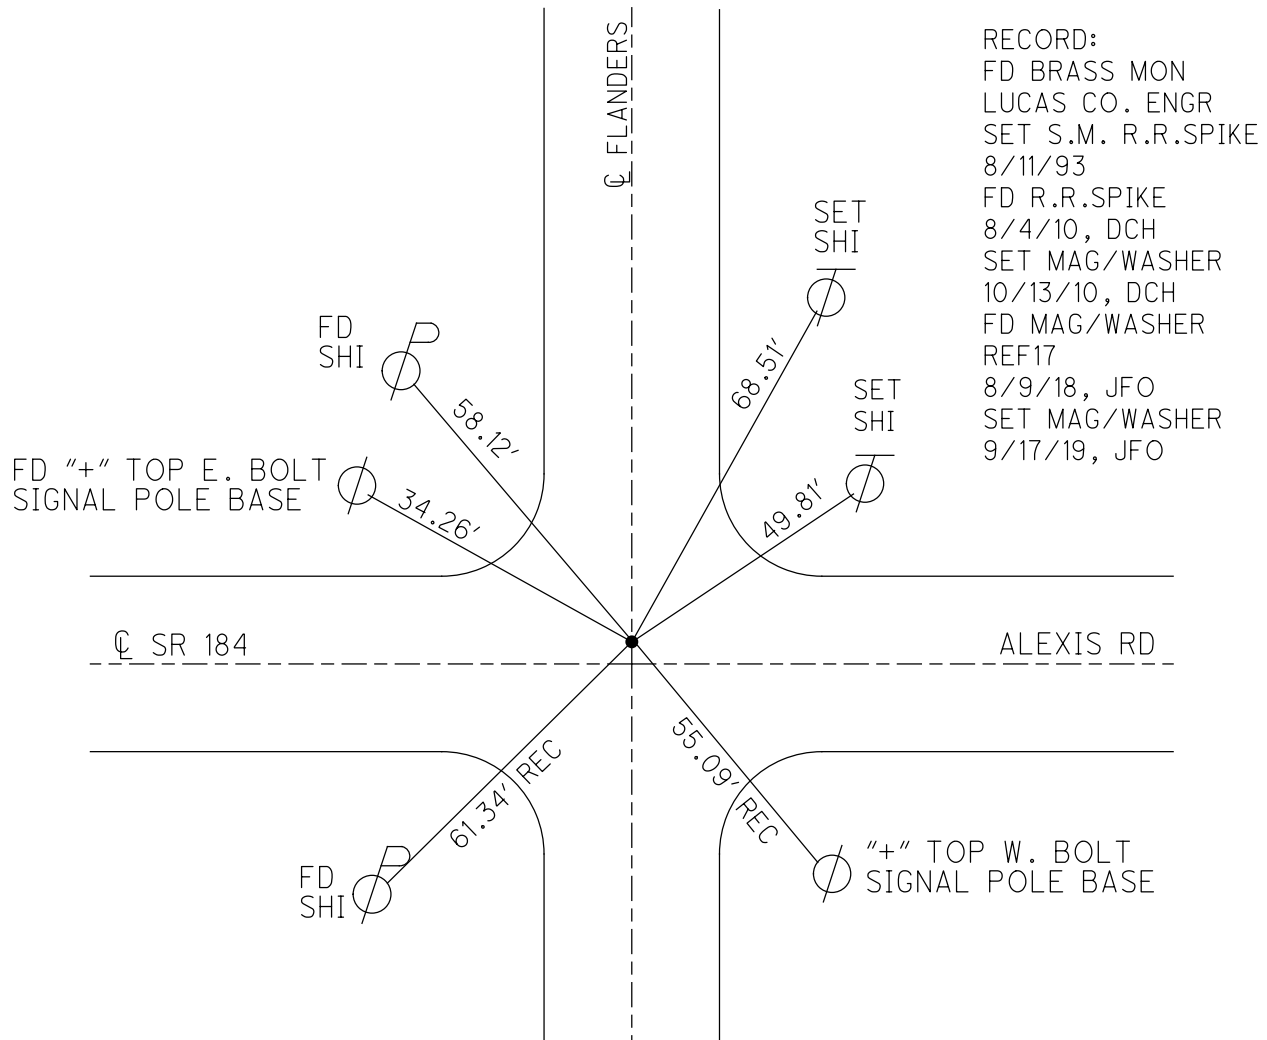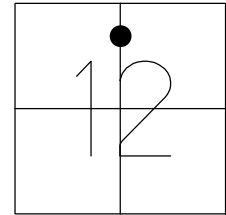

O.D.O.T. DISTRICT 2 SURVEY OFFICE (USE ONLY)


PERSONNEL _____	REFERENCE NO. <u>17</u>	SHEET <u>18</u> OF <u>18</u>
NOTES <u>HOMAN</u>	DATE <u>8/4/10</u>	ROUTE <u>SR. 184</u>
H.C. <u>ROUSOS</u>	WEATHER <u>SUNNY</u>	COUNTY <u>LUCAS</u>
R.C. <u>FINTEL</u>	TEMP. <u>80° F</u>	TOWNSHIP <u>SYLVANIA</u>
_____	_____	SECTION <u>12</u>
_____	_____	T <u>9</u> S R <u>6</u> E

TYPE MONUMENT RR. SPIKE
 ON SURFACE - ~~BELOW~~ ON
 LEFT - CL PAV'T - ~~RIGHT~~ 10'
- TO - EDGE PAVEMENT
 S.L.M. 98+15

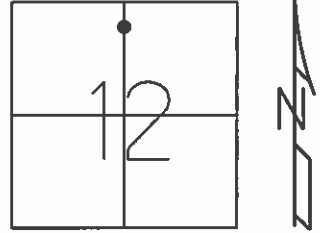

Grid: Northing: 749868.998 Easting: 1652908.962

RECORD:
 BRASS MON. LUCAS CO. ENG
 SET SM. RR. SPIKE
 8/11/93
 FD. RR. SPIKE
 8/4/10
 SETMAG NAIL/WASHER
 10/13/10

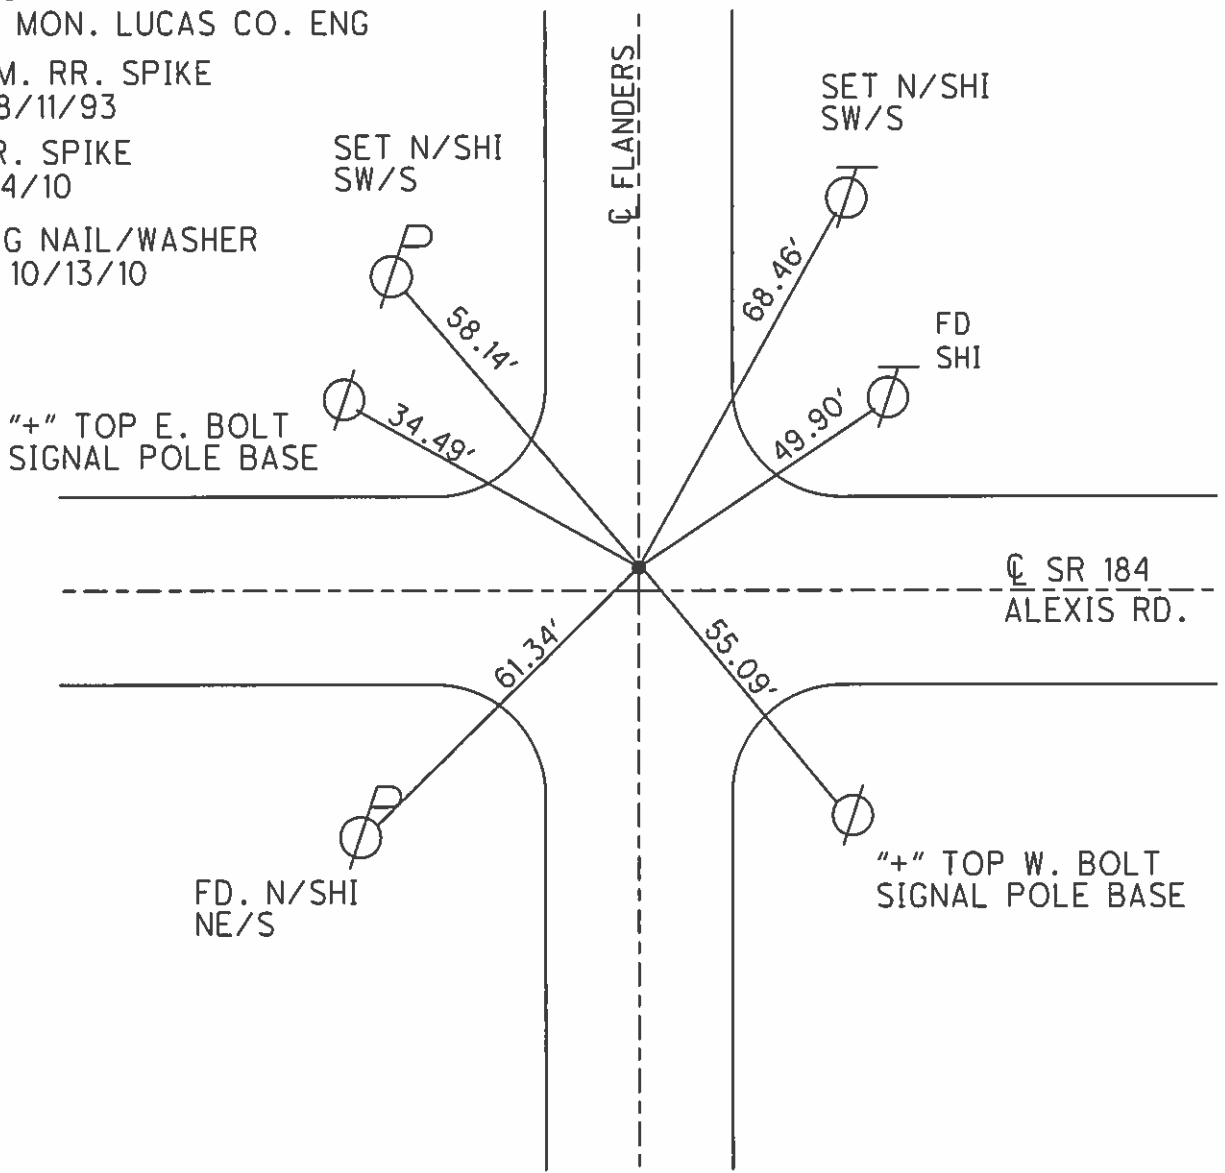

FD. N/SHI
NE/S

"+" TOP W. BOLT
SIGNAL POLE BASE

O.D.O.T. DISTRICT 2 SURVEY OFFICE

PERSONNEL

REFERENCE NO. 17

SHEET 15 OF 20



NOTES LOENRKE
 H.C. COPDES
 R.C. ROMETO
CANTERBURY

DATE 7-19-93
 WEATHER Cloudy
 TEMP. +84

ROUTE S.R. #184
 COUNTY LUCAS
 TOWNSHIP _____
 SECTION _____
 T _____ R _____

Set Sim. R.R. Spike
 8-11-93
 C.L.


TYPE MONUMENT BRASS Mon Lucas Co. Eng.
~~ON~~ SURFACE - BELOW 2"
 LEFT- & PAV'T. - RIGHT 10.0'
 TO _____ EDGE PAVEMENT
 S.L.M. 9B+15

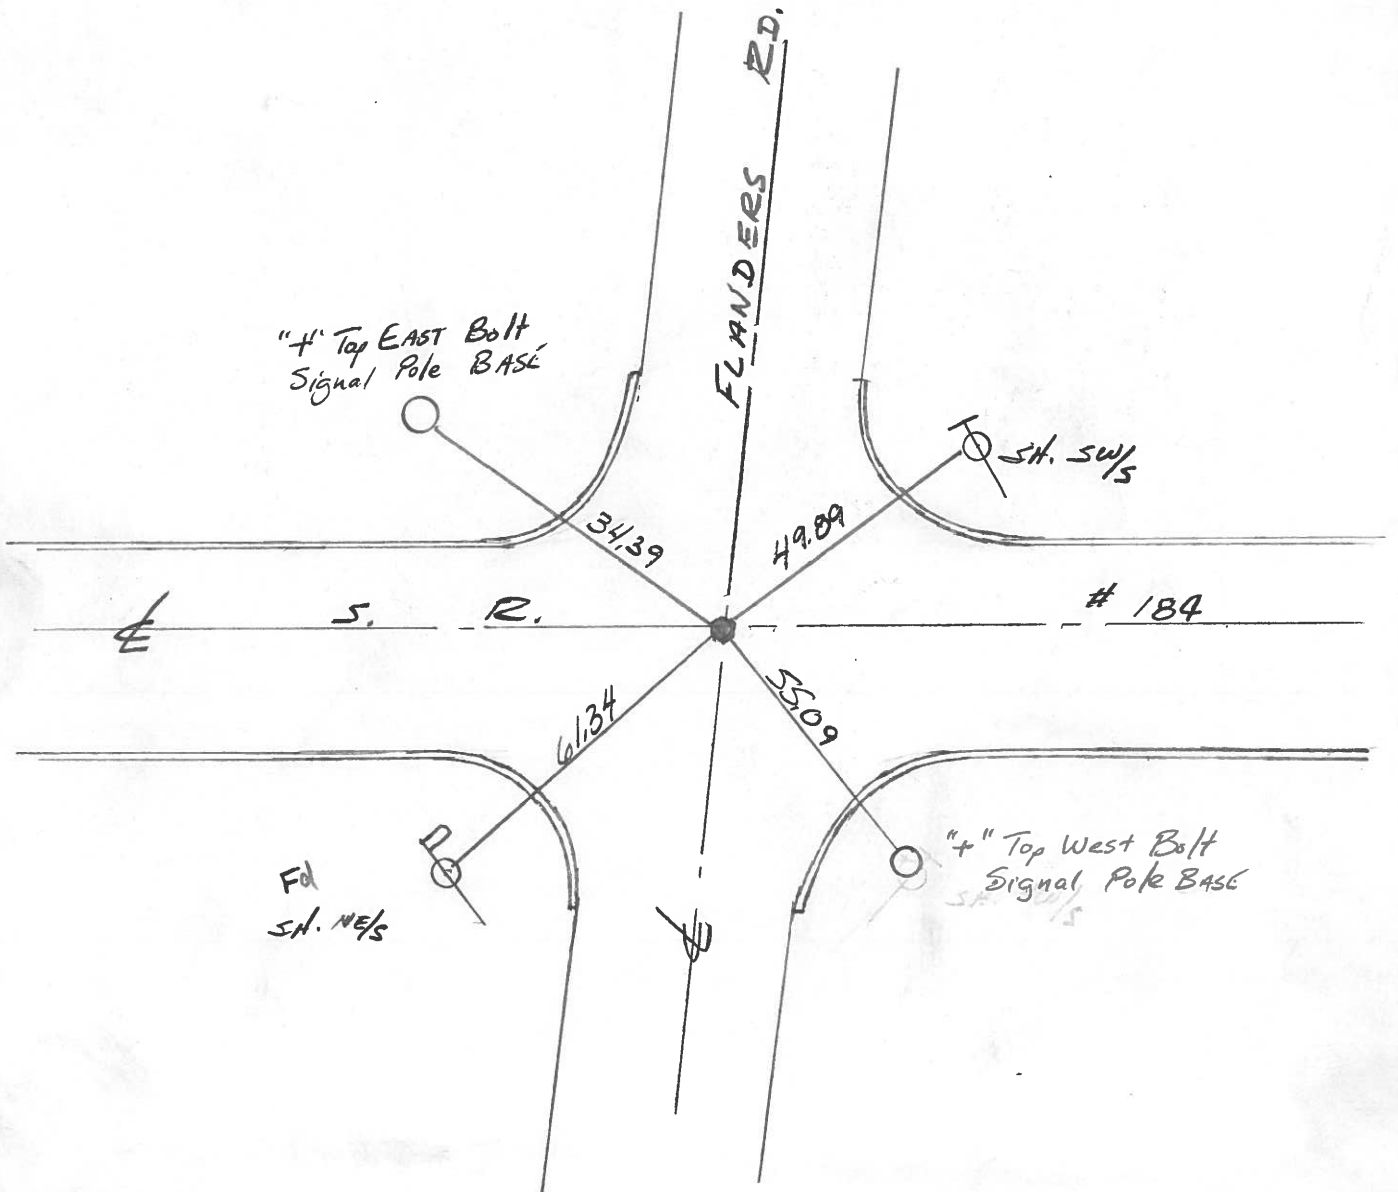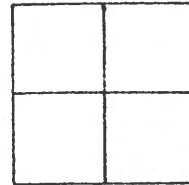

PERSONNEL	TITLE	PERSONNEL	TITLE
Stone			
Curtis			
Micholok			

COUNTY Lucas DATE 20 Feb. 76
 S. R. 184 WEATHER Clear
 SEC. 1.50 TEMP. 34°

DESCRIPTION References to Control Points JOB NO. _____
 LEFT CENTER LINE RIGHT

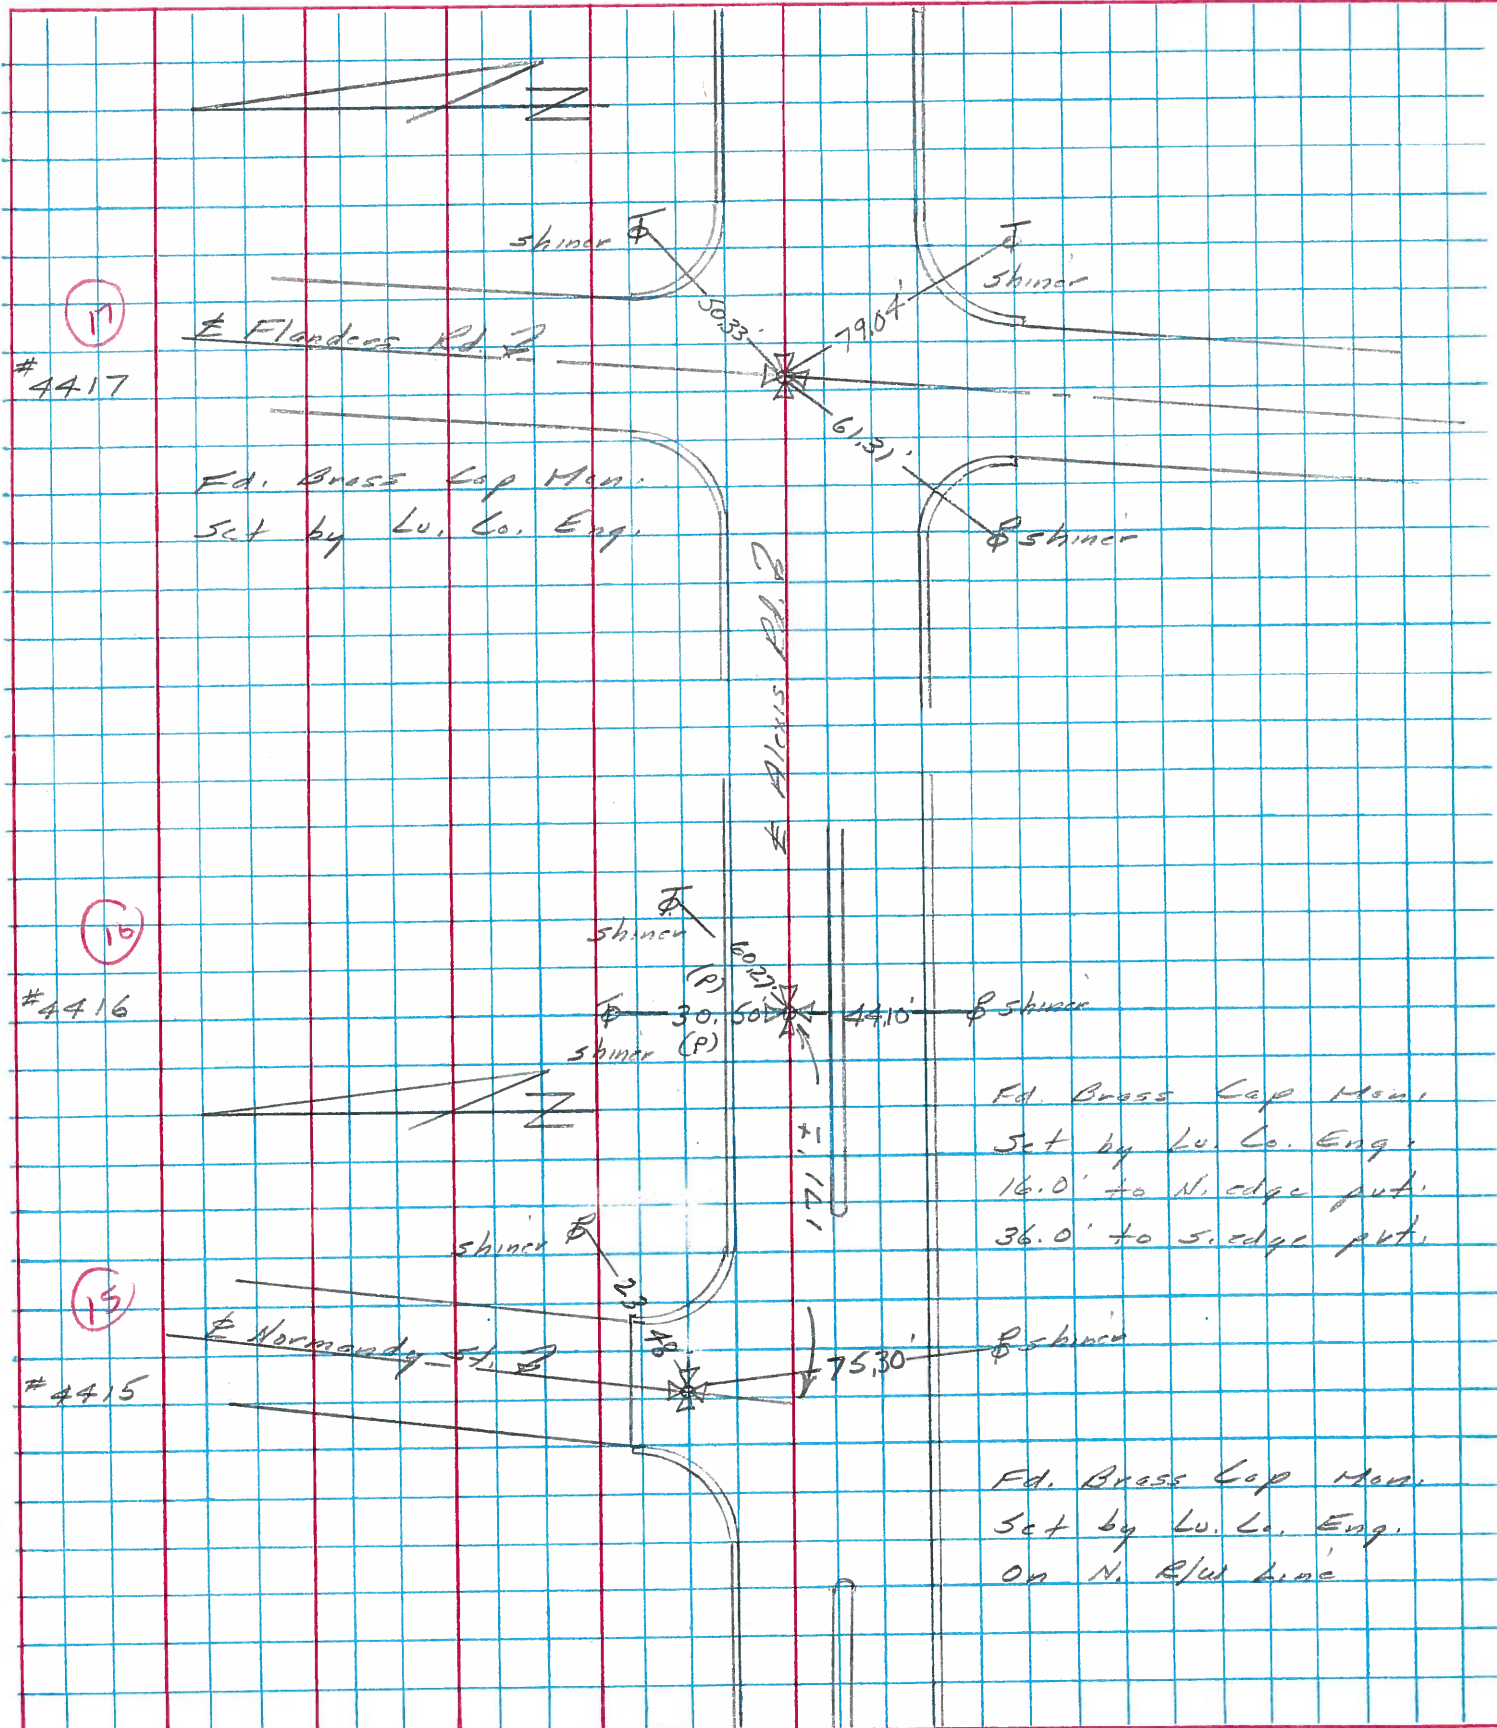

PERSONNEL	TITLE	PERSONNEL	TITLE	COUNTY	DATE
S. Lane	Notes			Lucas	28 June 68
Beck	Flag			S. R. 24-25 Bypass	WEATHER Cool
Michalak	Tape			SEC. Alexis Rd.	TEMP. 64°
Schroder	Tape				

DESCRIPTION References to Control Points JOB NO. _____

