

O.D.O.T. DISTRICT 2 SURVEY OFFICE (USE ONLY)

PERSONNEL

REFERENCE NO. 19 A

SHEET 3 OF 58

NOTES LOEHRKE

DATE 7/20/93

ROUTE SR 184

H.C. CORDES

WEATHER CLEAR

COUNTY LUCAS

R.C. ROMETO

TEMP. 75°

TOWNSHIP SYLVANIA

CANTERBURY

SECTION 12

DWG BY NIESE PID _____

T 9 S R 6 E

TYPE MONUMENT P.K. NAIL

ON SURFACE - ~~BELOW~~ ON


OFFSET CL PAVEMENT 6.2' LT : ~~RT~~

18.9' TO LT EDGE CURB


STATION: 108+88

HORZ. DATUM: _____ GEOID: _____

GRID: NORTHING: _____ EASTING: _____

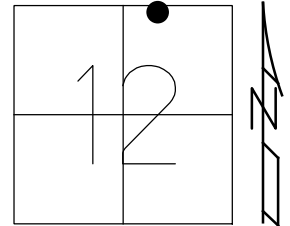

RECORD:
FD P.K. NAIL
7/20/93, CL
SET P.K./WASHER
8/11/93, CL

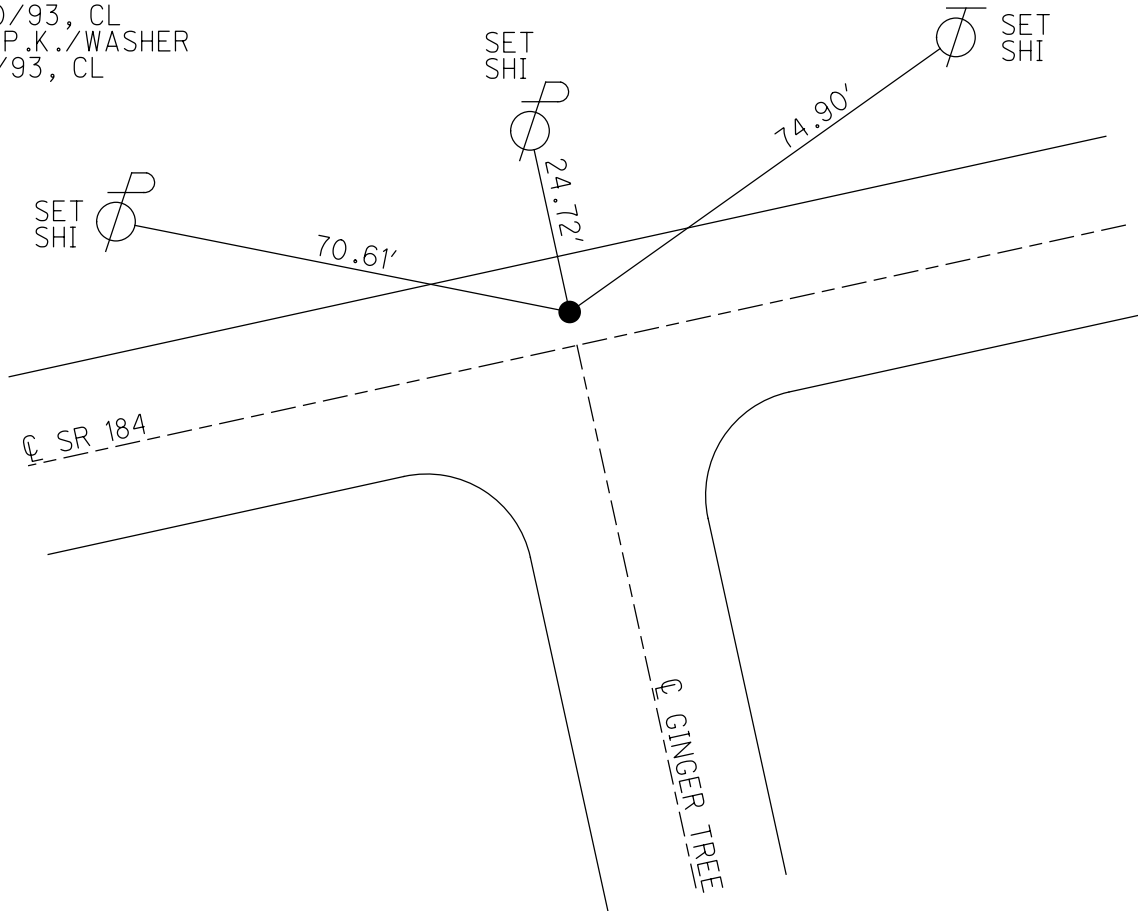

O.D.O.T. DISTRICT 2 SURVEY OFFICE

PERSONNEL _____

REFERENCE NO. 19A

SHEET 18 OF 20

NOTES LOEHRRKE

H.C. CORDES

R.C. ROMATO

CANTERBURY

DATE 7-20-93

WEATHER Clear

TEMP. 47.5

ROUTE S.R. 184

COUNTY Lucas

TOWNSHIP _____

SECTION _____

T. _____ R. _____

TYPE MONUMENT P.K. NAIL

Set P.K. WASHER
8-11-93

ON SURFACE - BELOW Yes

LEFT - ☉ PAV'T. - RIGHT 612'

18.9 TO Lt EDGE PAVEMENT CURB

S.L.M. 1084 83

