


O.D.O.T. DISTRICT 2 SURVEY OFFICE (USE ONLY)


PERSONNEL _____ REFERENCE NO. 20A SHEET 5 OF 58
 NOTES LOEHRKE DATE 7/20/93 ROUTE SR 184
 H.C. CORDES WEATHER CLEAR COUNTY LUCAS
 R.C. ROMETO TEMP. 77° TOWNSHIP SYLVANIA
 CANTERBURY SECTION 12
 DWG BY NIESH PID _____ T 9 S R 6 E

TYPE MONUMENT P.K. NAIL
 ON SURFACE - ~~BELOW~~ ON
 OFFSET CL PAVEMENT 9.5' LT : ~~RT~~
 _____ TO _____ EDGE PAVEMENT
 STATION: 124+48

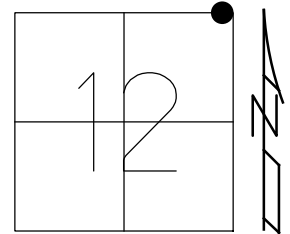

HORZ. DATUM: _____ GEOID: _____
 GRID: NORTHING: _____ EASTING: _____

RECORD:
 FD P.K. NAIL
 7/20/93, CL
 SET P.K./WASHER
 8/11/93, CL

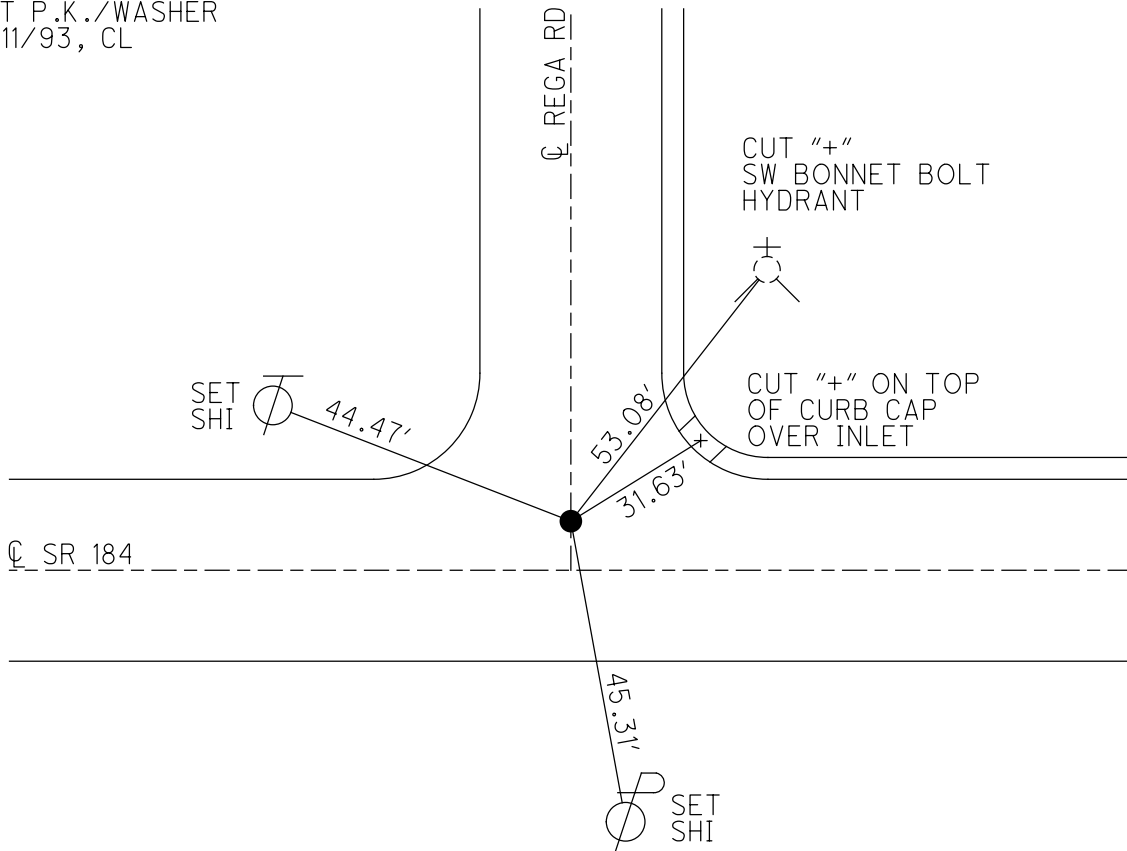

O.D.O.T. DISTRICT 2 SURVEY OFFICE

PERSONNEL _____

REFERENCE NO. 20A

SHEET 20 OF 20

NOTES LOHRKE

H.C. CORDES

DATE 7-26-93

ROUTE S.R. 184

R.C. RAMICHO

WEATHER CLEAR

COUNTY LUCAS

CANTERBURY

TEMP. 77

TOWNSHIP _____

SECTION _____

Set P.K. / WASHER

T _____ R _____

TYPE MONUMENT P.K. NAIL

8-11-93

ON SURFACE - BELOW Yes

LEFT - ϕ PAV'T. - RIGHT 9.5

^ TO _____ EDGE PAVEMENT

S.L.M. 124 +48

