

O.D.O.T. DISTRICT 2 SURVEY OFFICE (USE ONLY)

PERSONNEL

REFERENCE NO. 41

SHEET 23 OF 58

NOTES STONE
 H.C. MICHALAK
 R.C. CURTIS
NEUSER

DATE 5/12/76
 WEATHER CLEAR
 TEMP. 52°

ROUTE SR 184
 COUNTY LUCAS
 TOWNSHIP CITY OF TOLEDO
 SECTION 8
 T 9 S R 7 E

DWG BY NIESE PID _____

TYPE MONUMENT MONBOX W/ IPIN


ON SURFACE - ~~BELOW~~ ON

OFFSET C PAVEMENT ON _____ LT : RT
 _____ TO _____ EDGE PAVEMENT


STATION: 193+25

HORZ. DATUM: _____ GEOID: _____

GRID: NORTHING: _____ EASTING: _____

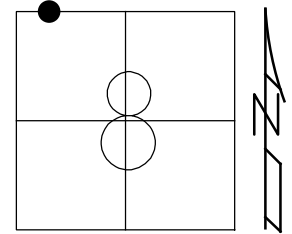

RECORD:
 FD MONBOX
 W/ IPIN
 5/12/76, STONE

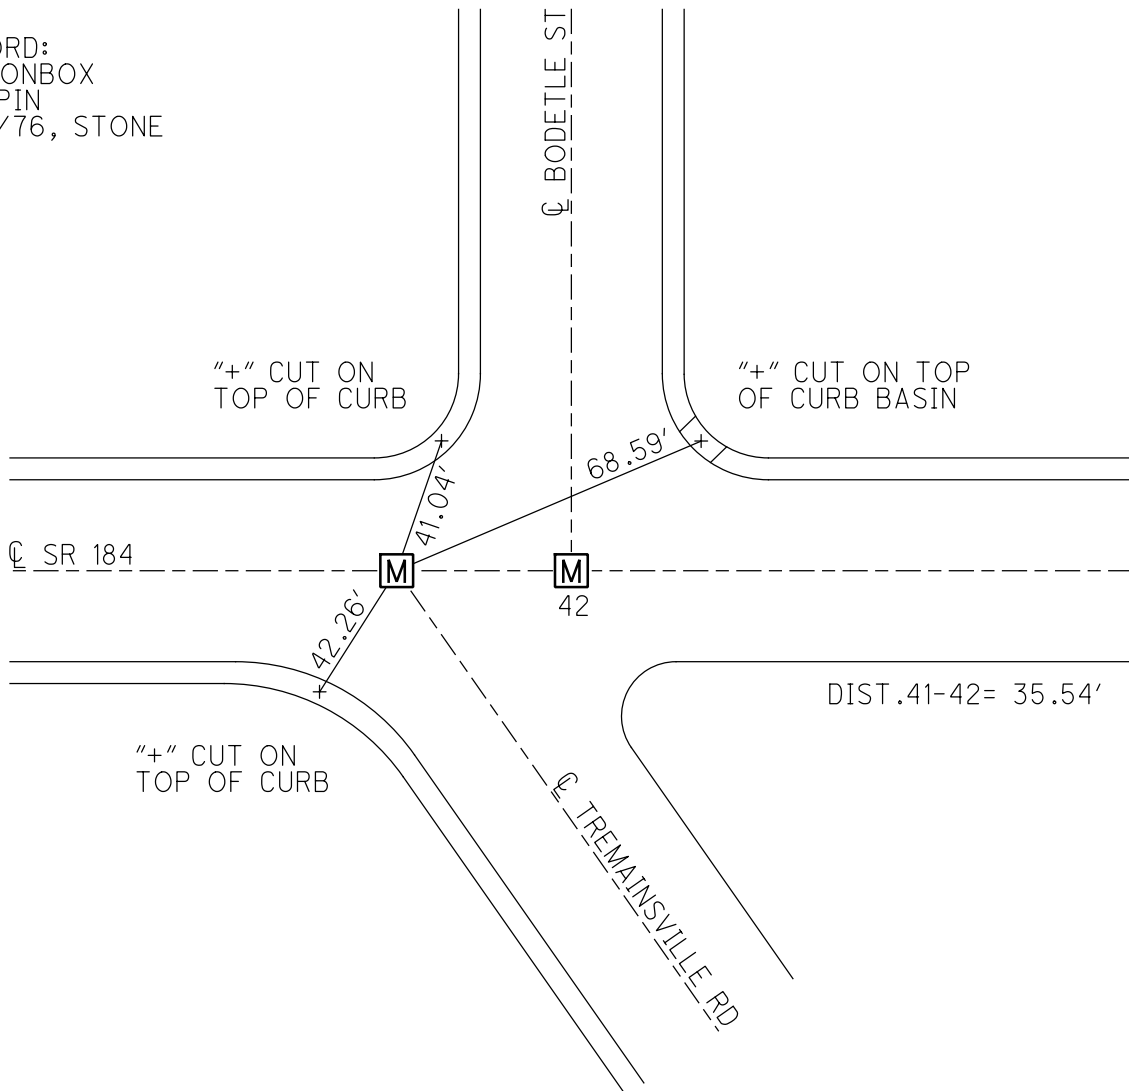

PERSONNEL	TITLE	PERSONNEL	TITLE	COUNTY	DATE
Stone		Granata		Lucas	12 May 76
Michalak				S. R. 187	WEATHER Clear
Curtis				SEC.	TEMP. 52°
Neuser					

DESCRIPTION References to Control Points JOB NO. _____

