

O.D.O.T. DISTRICT 2 SURVEY OFFICE (USE ONLY)

PERSONNEL _____

REFERENCE NO. 46

SHEET 28 OF 58

NOTES CITY _____ DATE 1/13/92

ROUTE _____ SR 184

H.C. OF _____ WEATHER _____

COUNTY _____ LUCAS

R.C. TOLEDO _____ TEMP. _____

TOWNSHIP CITY OF TOLEDO

DWG BY NIESE PID _____

SECTION 8

T 9 S R 7 E

TYPE MONUMENT MONBOX

ON SURFACE - ~~BELOW~~ ON _____

OFFSET \odot PAVEMENT ON _____ LT : RT

_____ TO _____ EDGE PAVEMENT


STATION: 237+15.14

HORIZ.DATUM: _____


GEOID: _____

GRID: NORTHING: _____

EASTING: _____

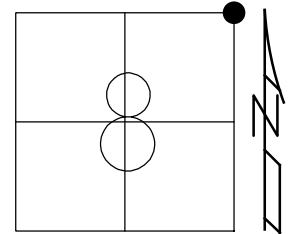

RECORD:
TOLEDO PLAN
LUC-SR 184-03.51
PLAN STA 801+71.55
FD MONBOX
W/ 1" IPIN
5/12/76, STONE

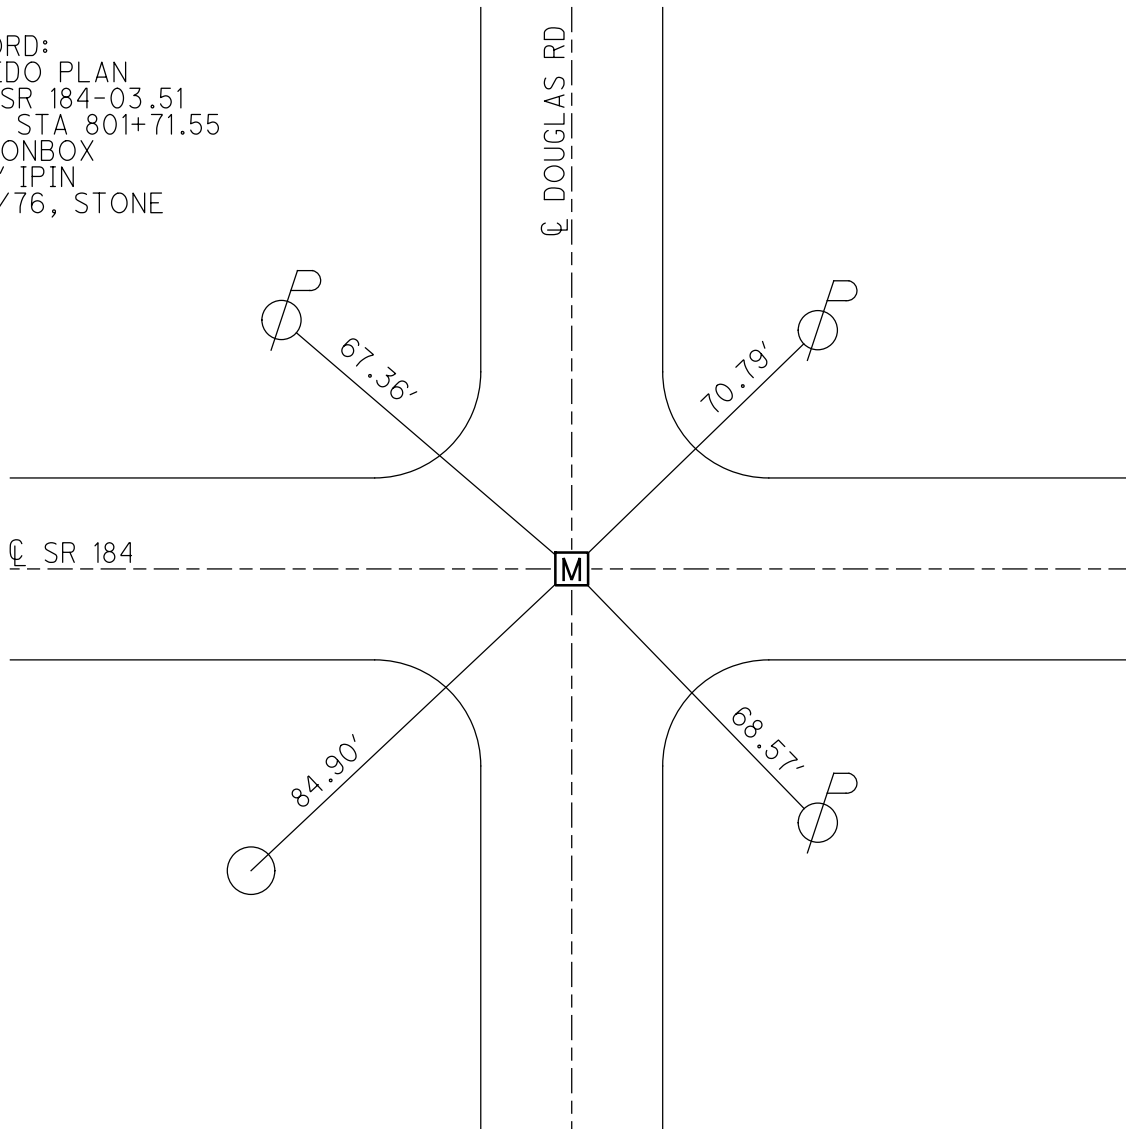

O.D.O.T. DISTRICT 2 SURVEY OFFICE

PERSONNEL _____

REFERENCE NO. 46

SHEET 3 OF 5

NOTES CITY

H.C. OF

R.C. TOLEDO

DATE 1-13-92

WEATHER _____

TEMP. _____

ROUTE 184

COUNTY LUCAS

TOWNSHIP WASHINGTON

SECTION 8

T 9 S R 7 E


TYPE MONUMENT Man Box

ON SURFACE - BELOW SURFACE

LEFT - ☉ PAV'T. - RIGHT _____

TO _____ EDGE PAVEMENT


S.L.M. 237+15.14

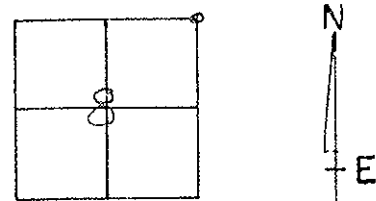


DRAWN BY Wm LUCE

TOLEDO PLAN Luc-SR184-0351

PLAN STA = 801+71.55

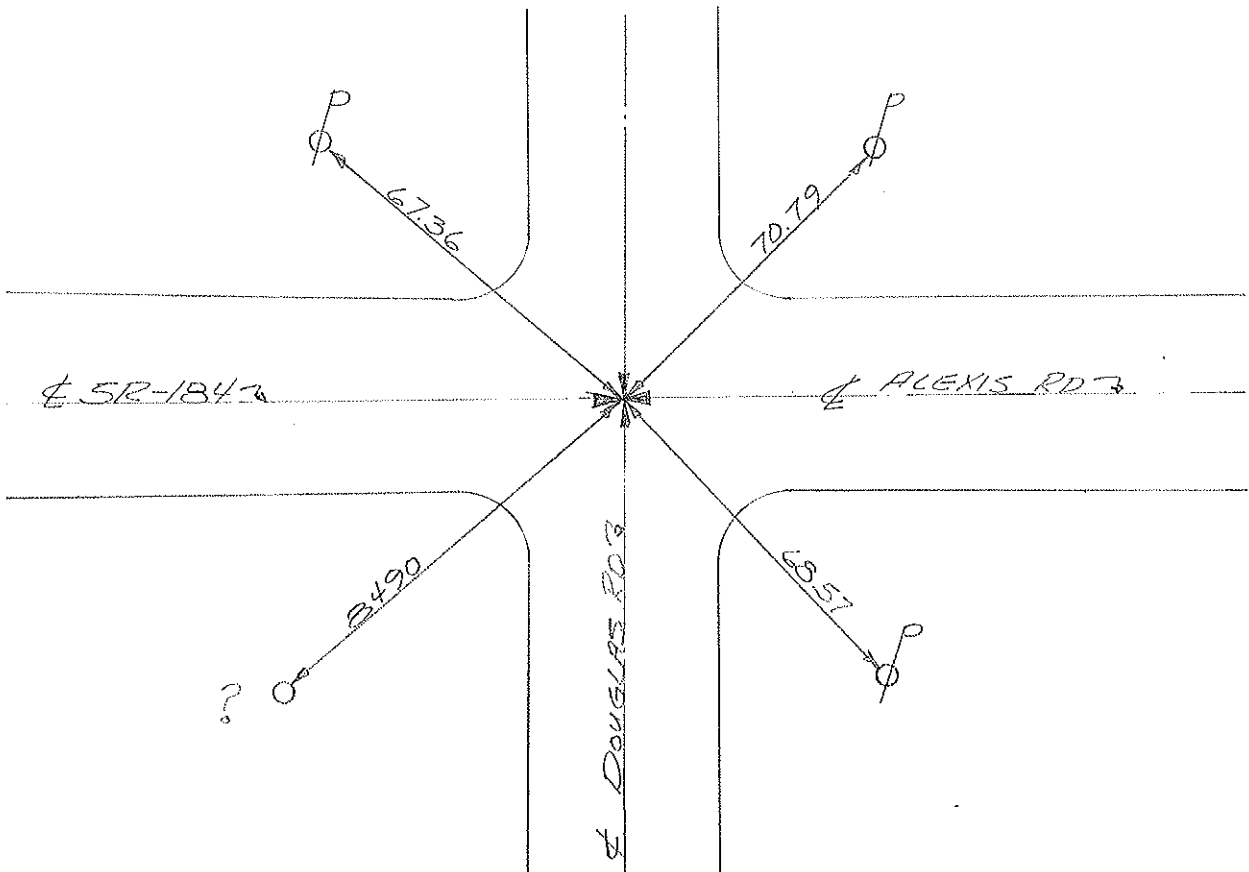

PERSONNEL	TITLE	PERSONNEL	TITLE	COUNTY	DATE	S. R.	WEATHER	SEC.	TEMP.	DESCRIPTION	JOB NO.
Stone		Granata		Lucas	13 May 76	189	Clear		53°	References to Central Points	
Mickaluk											
Curtis											
Newer											

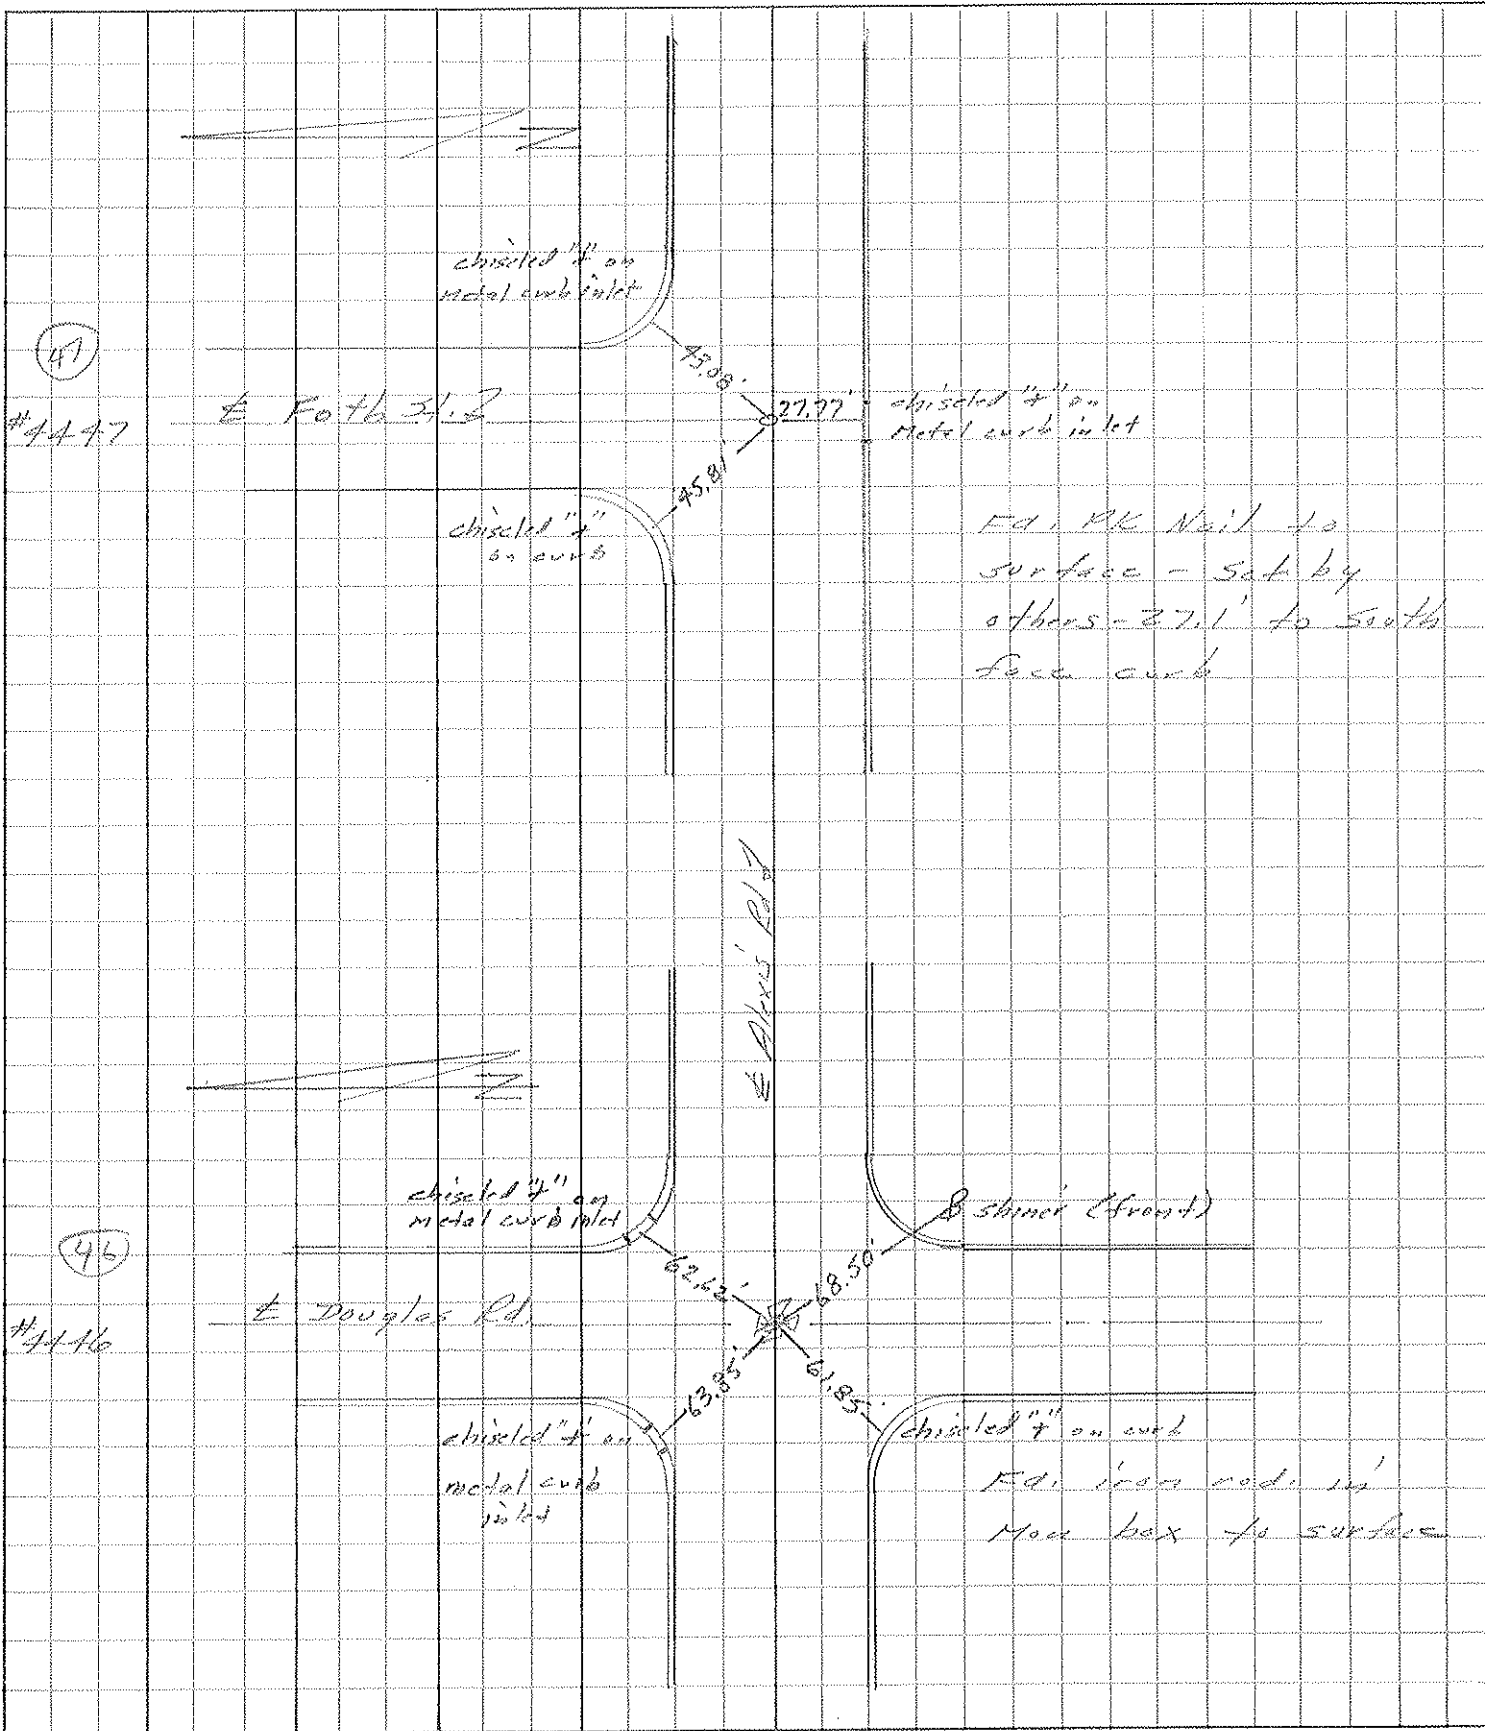

PERSONNEL	TITLE	PERSONNEL	TITLE	COUNTY	DATE	WEATHER	TEMP.
Stone	Notes			Lucas	3 July 68	Cool	59°
Michalak	Tape			S. R. 29-25 Bypass			
Schroder	Tape			SEC. Alexis Rd.			

DESCRIPTION References to Control Points LEFT CENTER LINE RIGHT JOB NO.

