


PERSONNEL	TITLE	PERSONNEL	TITLE
Stone		Granta	
Michalak			
Curtis			
Neuser			

COUNTY Lucas DATE 13 May '76  
 S. R. 187 WEATHER Fair  
 SEC. \_\_\_\_\_ TEMP. 70°


DESCRIPTION References to Central Points JOB NO. \_\_\_\_\_  
 LEFT CENTER LINE RIGHT

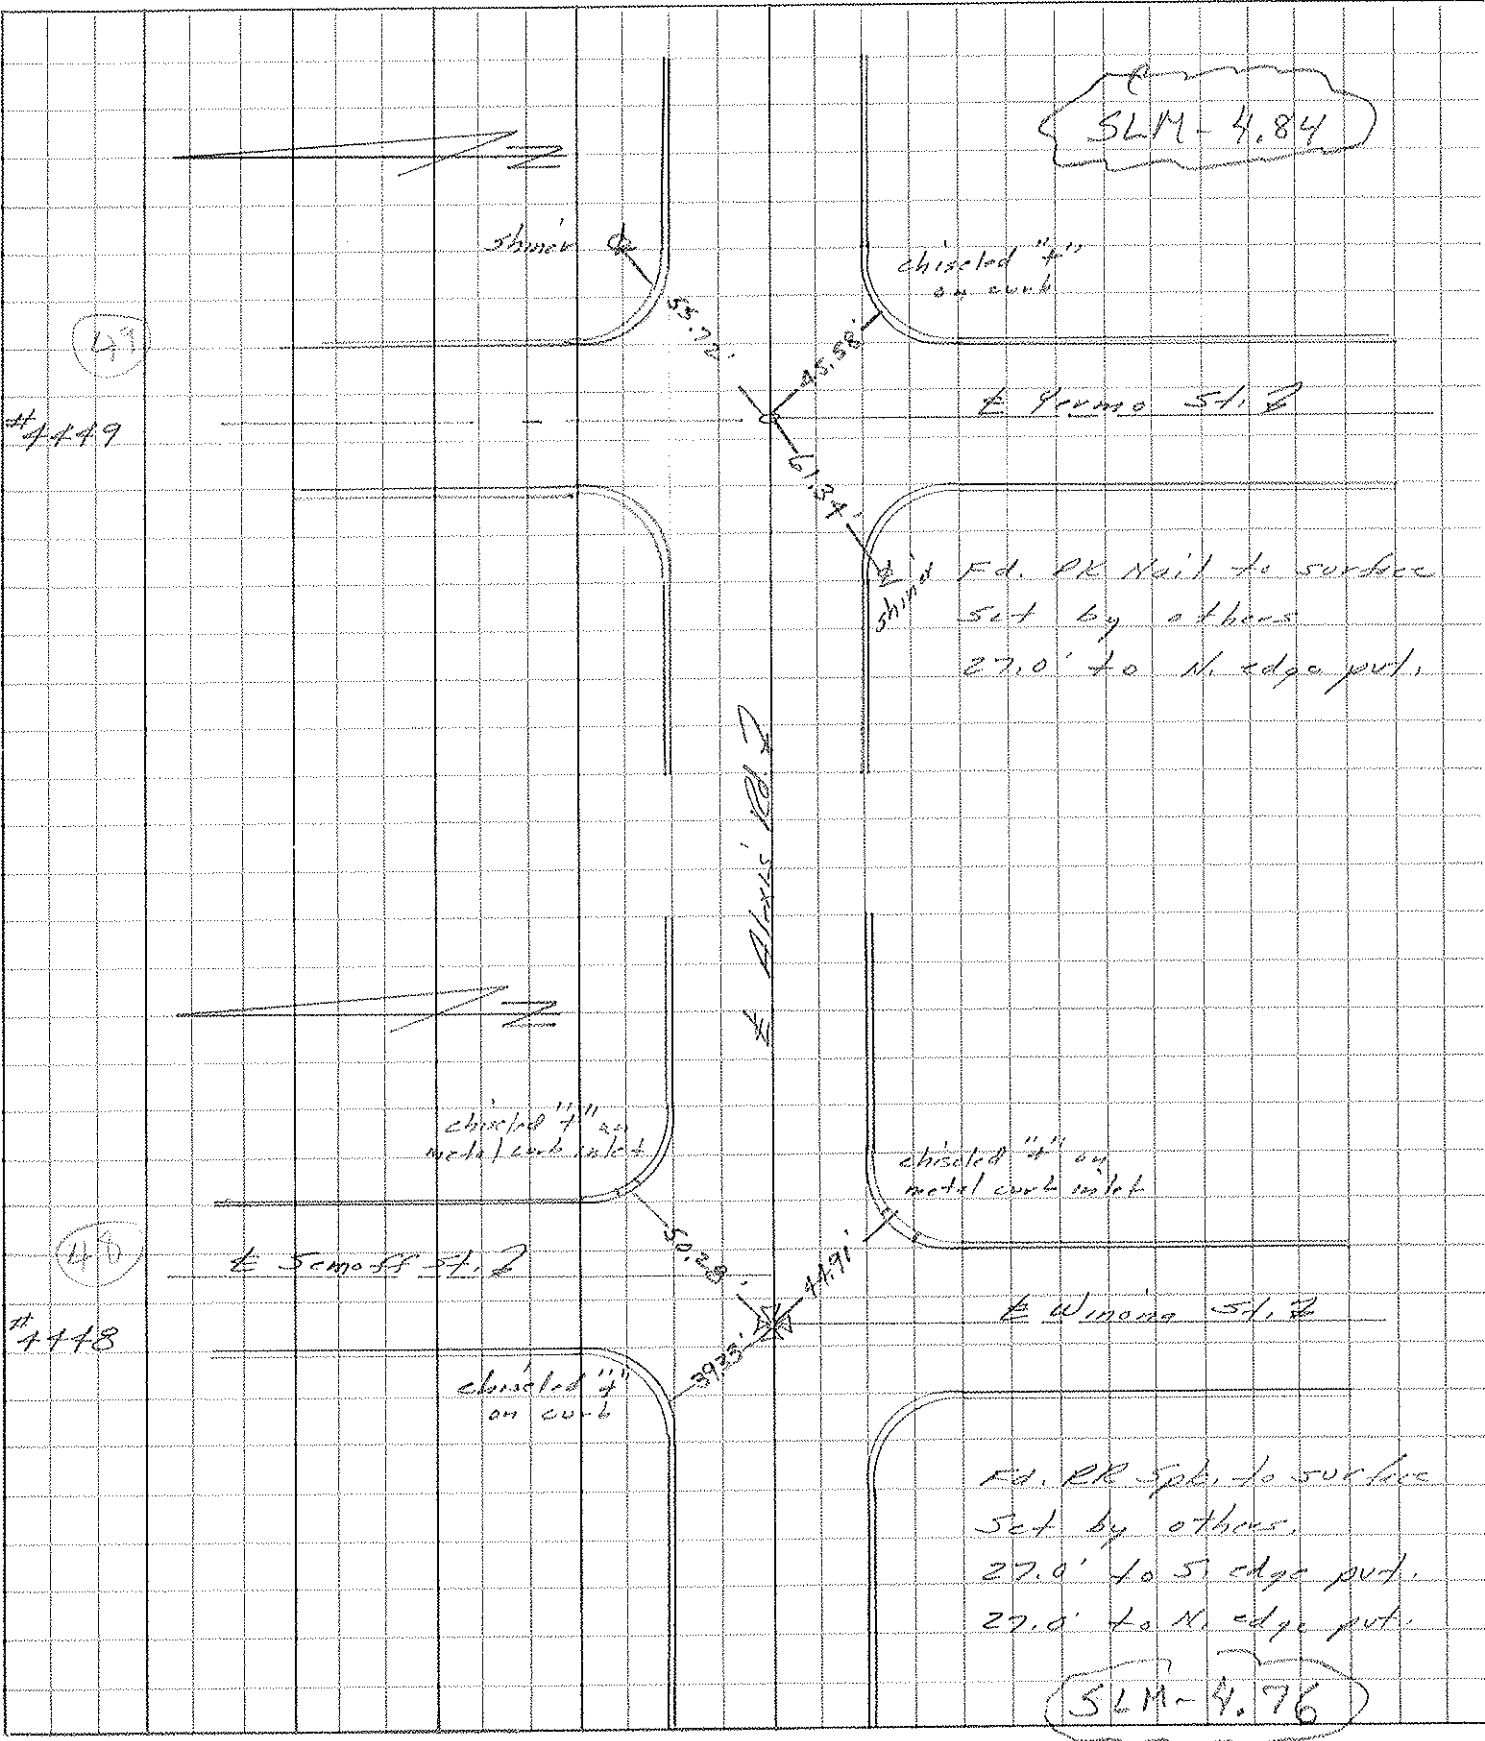

PERSONNEL	TITLE	PERSONNEL	TITLE
Stone	Notes		
Michalak	Tape		
Schroder	Tape		

COUNTY Lucas DATE 3 July 68  
 S. R. 29-25 Bypass WEATHER Fair  
 SEC. \_\_\_\_\_ TEMP. 61°

DESCRIPTION References to Control Points JOB NO. \_\_\_\_\_  
 LEFT CENTER LINE RIGHT

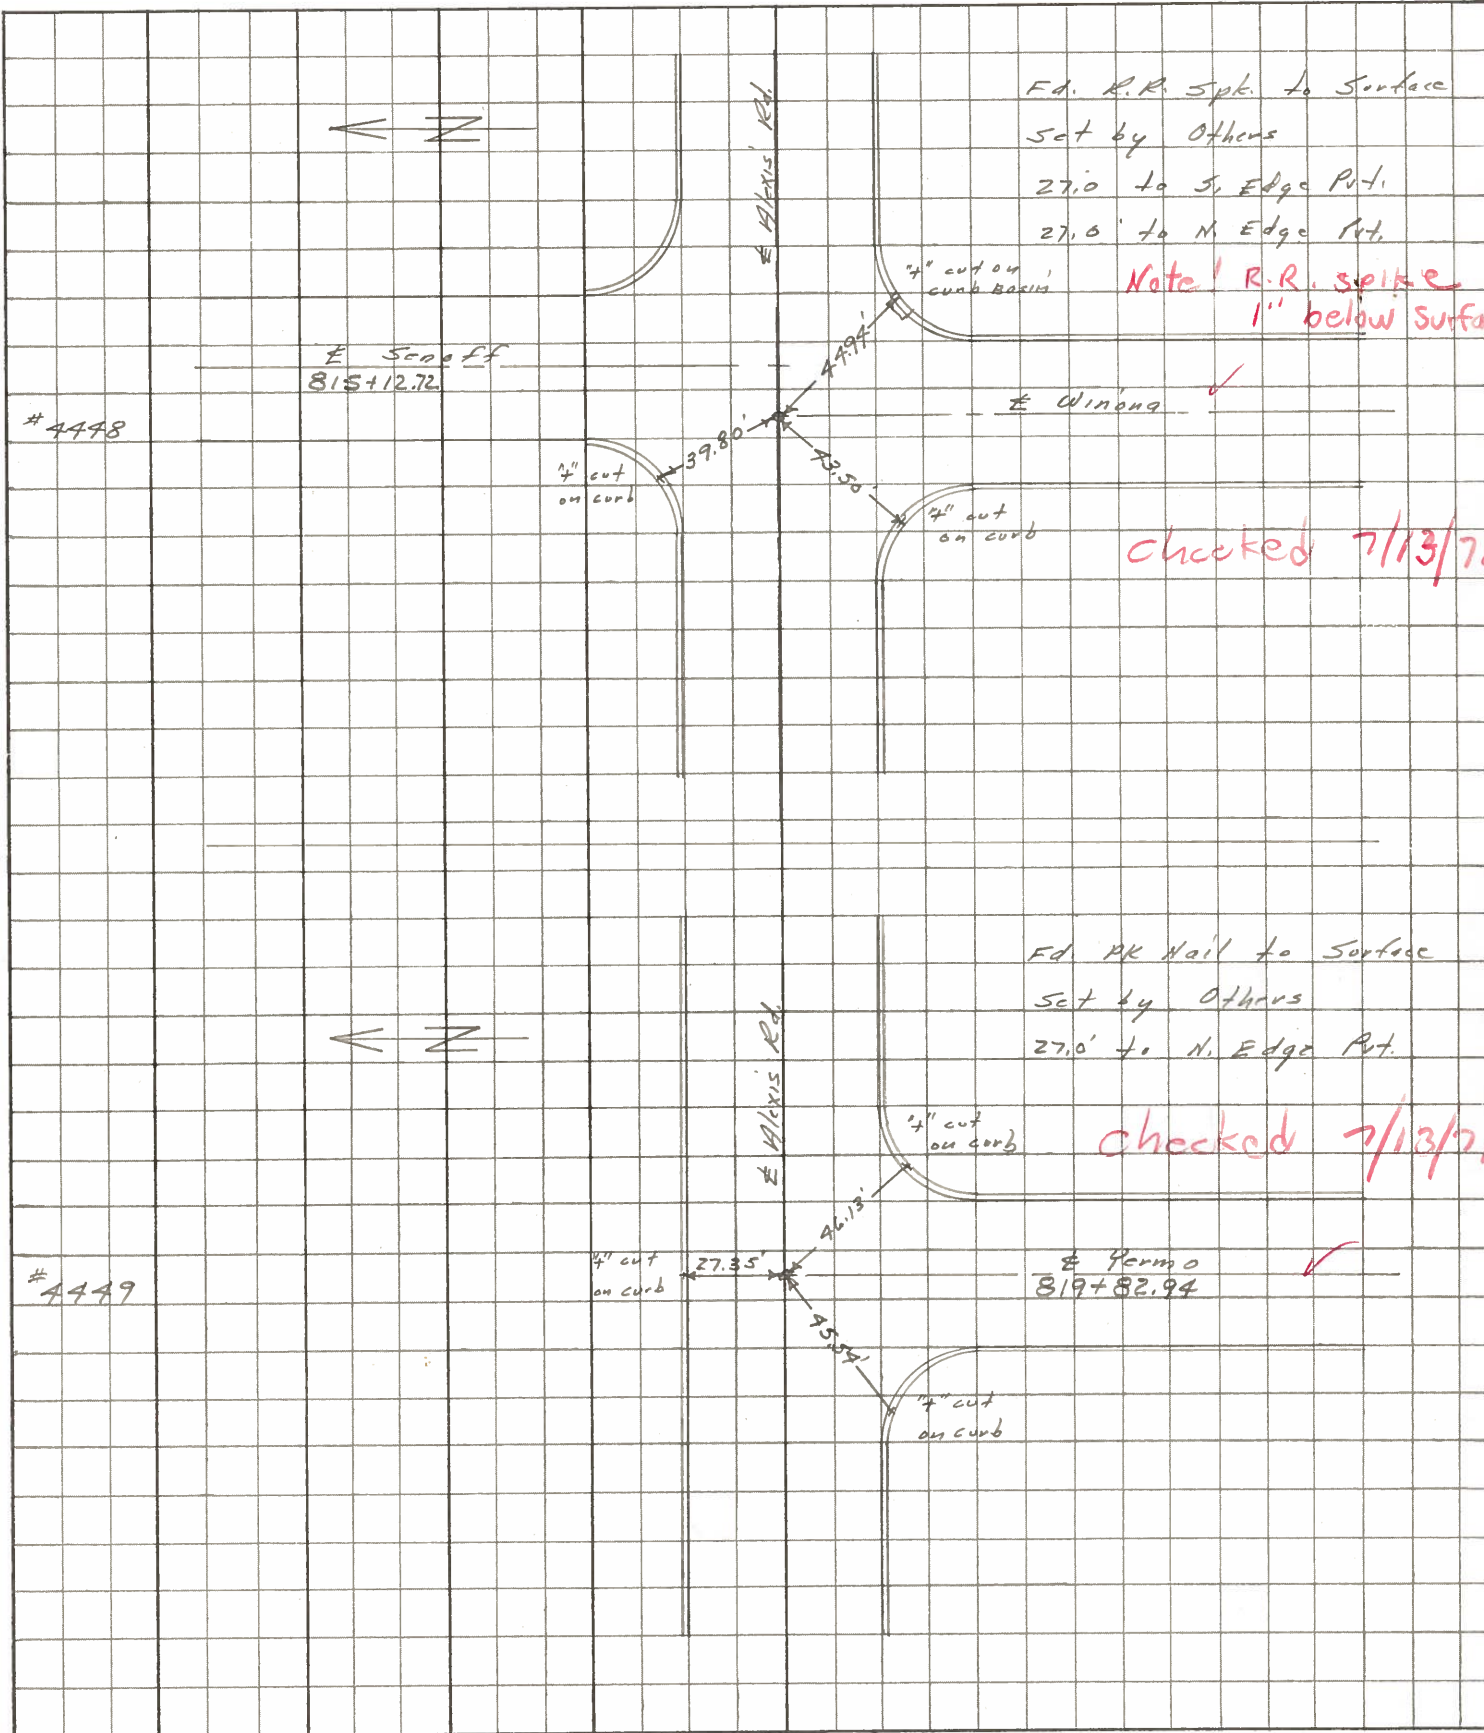

Fd. R.R. Spk. to Surface  
 Set by Others  
 27.0' to S. Edge Pt.  
 27.0' to N. Edge Pt.  
 Note! R.R. spike  
 1" below surface

checked 7/13/70

Fd. RR Nail to Surface  
 Set by Others  
 27.0' to N. Edge Pt.  
 checked 7/13/70

# Yermo  
 819+82.94