

O.D.O.T. DISTRICT 2 SURVEY OFFICE (USE ONLY)

PERSONNEL

REFERENCE NO. 52

SHEET 35 OF 58

NOTES STONE DATE 9/2/76

ROUTE SR 184

H.C. MICHALAK WEATHER FAIR

COUNTY LUCAS

R.C. NEUSER TEMP. 69°

TOWNSHIP CITY OF TOLEDO

CURTIS/GRANATA

SECTION 10

DWG BY NIESE PID _____

T 9 S R 7 E

TYPE MONUMENT MONBOX W/ 1" IPIN

ON SURFACE - ~~BELOW~~ ON

OFFSET ☉ PAVEMENT ON LT : RT

27.0' TO RT EDGE PAVEMENT


STATION: 329+47

HORZ.DATUM: _____

GEOID: _____


GRID: NORTHING: _____

EASTING: _____

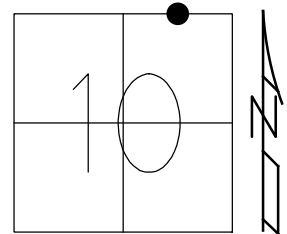

RECORD:
 FD MONBOX
 W/ 1" IPIN
 1/4 MILE WEST
 OF LEWIS DR
 ON WEST R. OF ARBY'S
 9/2/76, STONE

CHISELED "X"s
 ON CURB

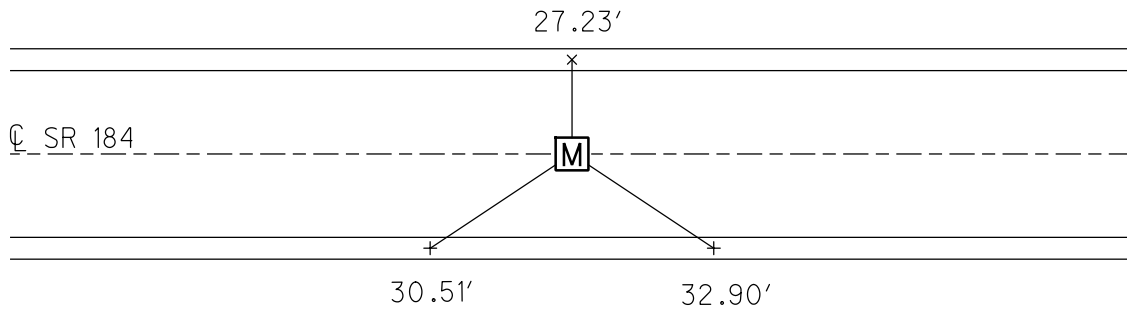

PERSONNEL	TITLE	PERSONNEL	TITLE	COUNTY	DATE
Stange		Granata		Lucas	2 Sept. 76
Michalek				S. R. 184	WEATHER Fair
Hansen				SEC. 13611, R1	TEMP. 64°
Curtis					
DESCRIPTION	References to Control Points				JOB NO.
	LEFT	CENTER LINE	RIGHT		

