

O.D.O.T. DISTRICT 2 SURVEY OFFICE (USE ONLY)

PERSONNEL

REFERENCE NO. 59

SHEET 42 OF 58

NOTES STONE DATE 9/2/76

ROUTE SR 184

H.C. MICHALAK WEATHER FAIR

COUNTY LUCAS

R.C. NEUSER TEMP. 66°

TOWNSHIP CITY OF TOLEDO

CURTIS/GRANATA

SECTION 11

DWG BY NIESE PID \_\_\_\_\_

T 9 S R 7 E

TYPE MONUMENT P.K. NAIL

ON SURFACE - ~~BELOW~~ ON


OFFSET ☉ PAVEMENT ON \_\_\_\_\_ LT : RT

\_\_\_\_\_ TO \_\_\_\_\_ EDGE PAVEMENT


STATION: 381+87 ±

HORZ.DATUM: \_\_\_\_\_ GEOID: \_\_\_\_\_

GRID: NORTHING: \_\_\_\_\_ EASTING: \_\_\_\_\_

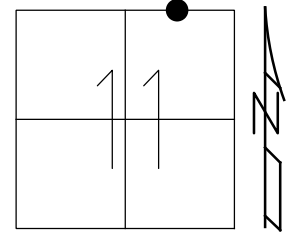

RECORD:  
 FD P.K. NAIL  
 ON SURFACE  
 SET BY OTHERS  
 W P/L ALEXIS'S MOTEL  
 9/2/76, STONE

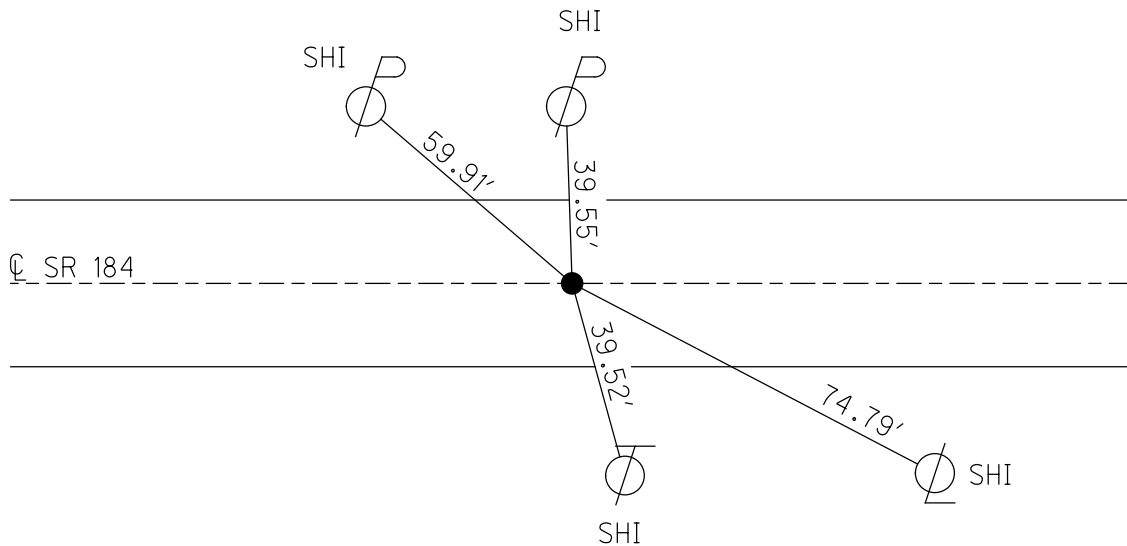

| PERSONNEL | TITLE | PERSONNEL | TITLE | COUNTY           | DATE         |
|-----------|-------|-----------|-------|------------------|--------------|
| Stone     |       | Granata   |       | Lucas            | 2 Sept. 76   |
| Michalek  |       |           |       | S. R. 184        | WEATHER Fair |
| Newson    |       |           |       | SEC. Alexis' Pt. | TEMP. 66°    |
| Curtis    |       |           |       |                  |              |

DESCRIPTION Reference to Central Points JOB NO. \_\_\_\_\_

LEFT                      CENTER LINE                      RIGHT

