

O.D.O.T. DISTRICT 2 SURVEY OFFICE (USE ONLY)

PERSONNEL

REFERENCE NO. 60

SHEET 43 OF 58

NOTES STONE DATE 9/2/76  
 H.C. MICHALAK WEATHER FAIR  
 R.C. NEUSER TEMP. 66°  
CURTIS/GRANATA

ROUTE SR 184  
 COUNTY LUCAS  
 TOWNSHIP CITY OF TOLEDO  
 SECTION 11  
 T 9 S R 7 E

TYPE MONUMENT MONBOX W/ IPIN


ON SURFACE - ~~BELOW~~ ON

OFFSET  $\varnothing$  PAVEMENT \_\_\_\_\_ LT : RT  
 \_\_\_\_\_ TO \_\_\_\_\_ EDGE PAVEMENT


STATION: 394+94

HORIZ.DATUM: \_\_\_\_\_ GEOID: \_\_\_\_\_

GRID: NORTHING: \_\_\_\_\_ EASTING: \_\_\_\_\_

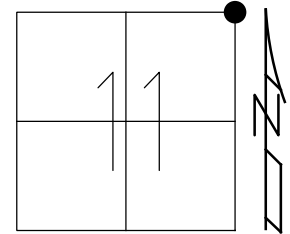


RECORD:  
 FD MONBOX  
 W/ 1" IPIN  
 9/2/76, STONE

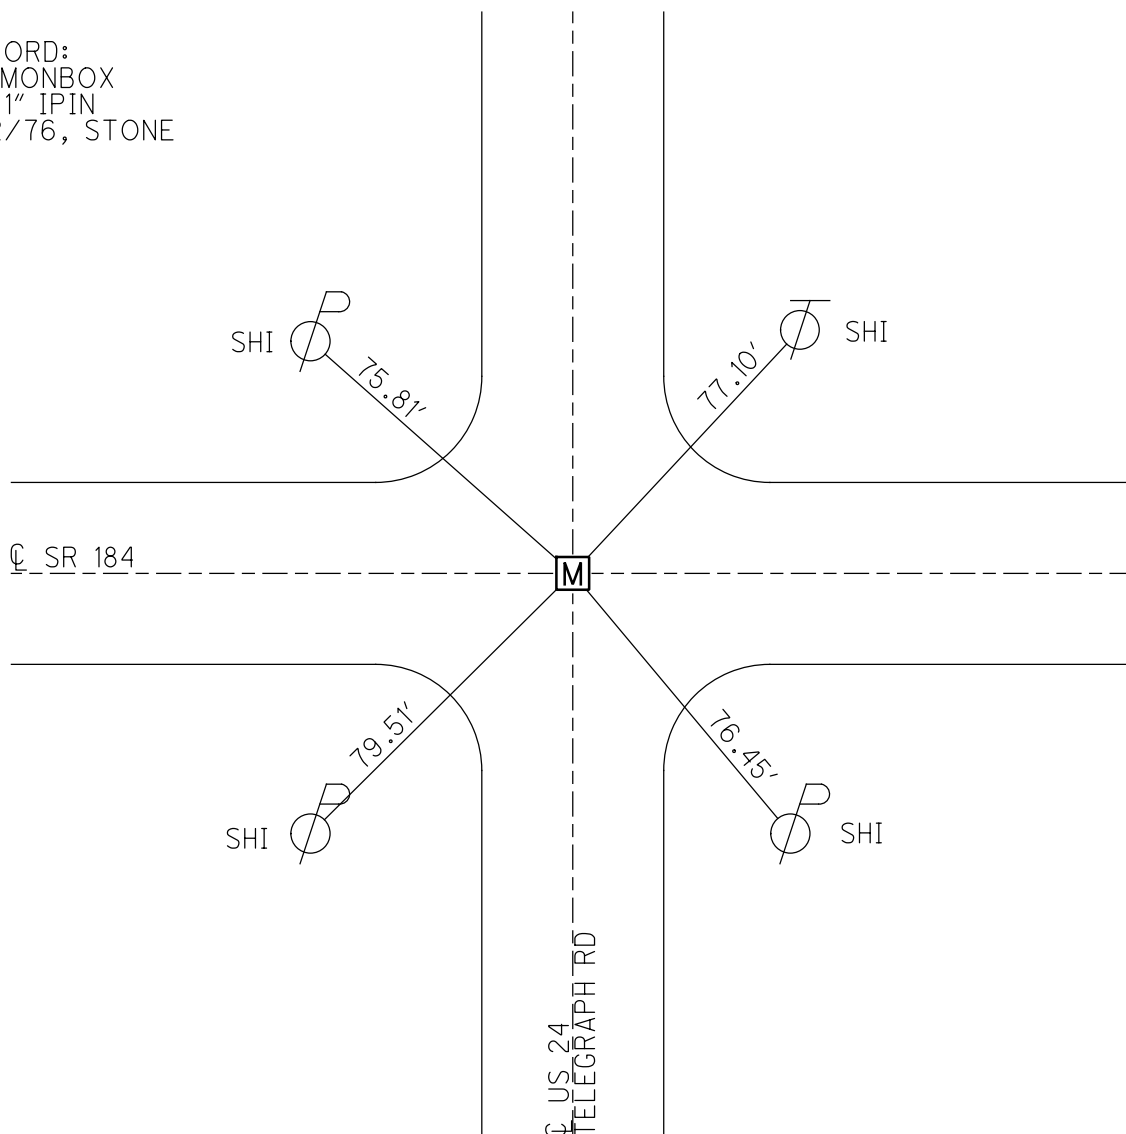

PERSONNEL	TITLE	PERSONNEL	TITLE	COUNTY	DATE	WEATHER	TEMP.
Slava		Hanson		Lucas	2 Sept. 76	Fair	67°
Michaelak				S. R.	184		
Curtis				SEC.	Alvis Rd.		
Granola							

DESCRIPTION: References to Central Points      JOB NO. \_\_\_\_\_

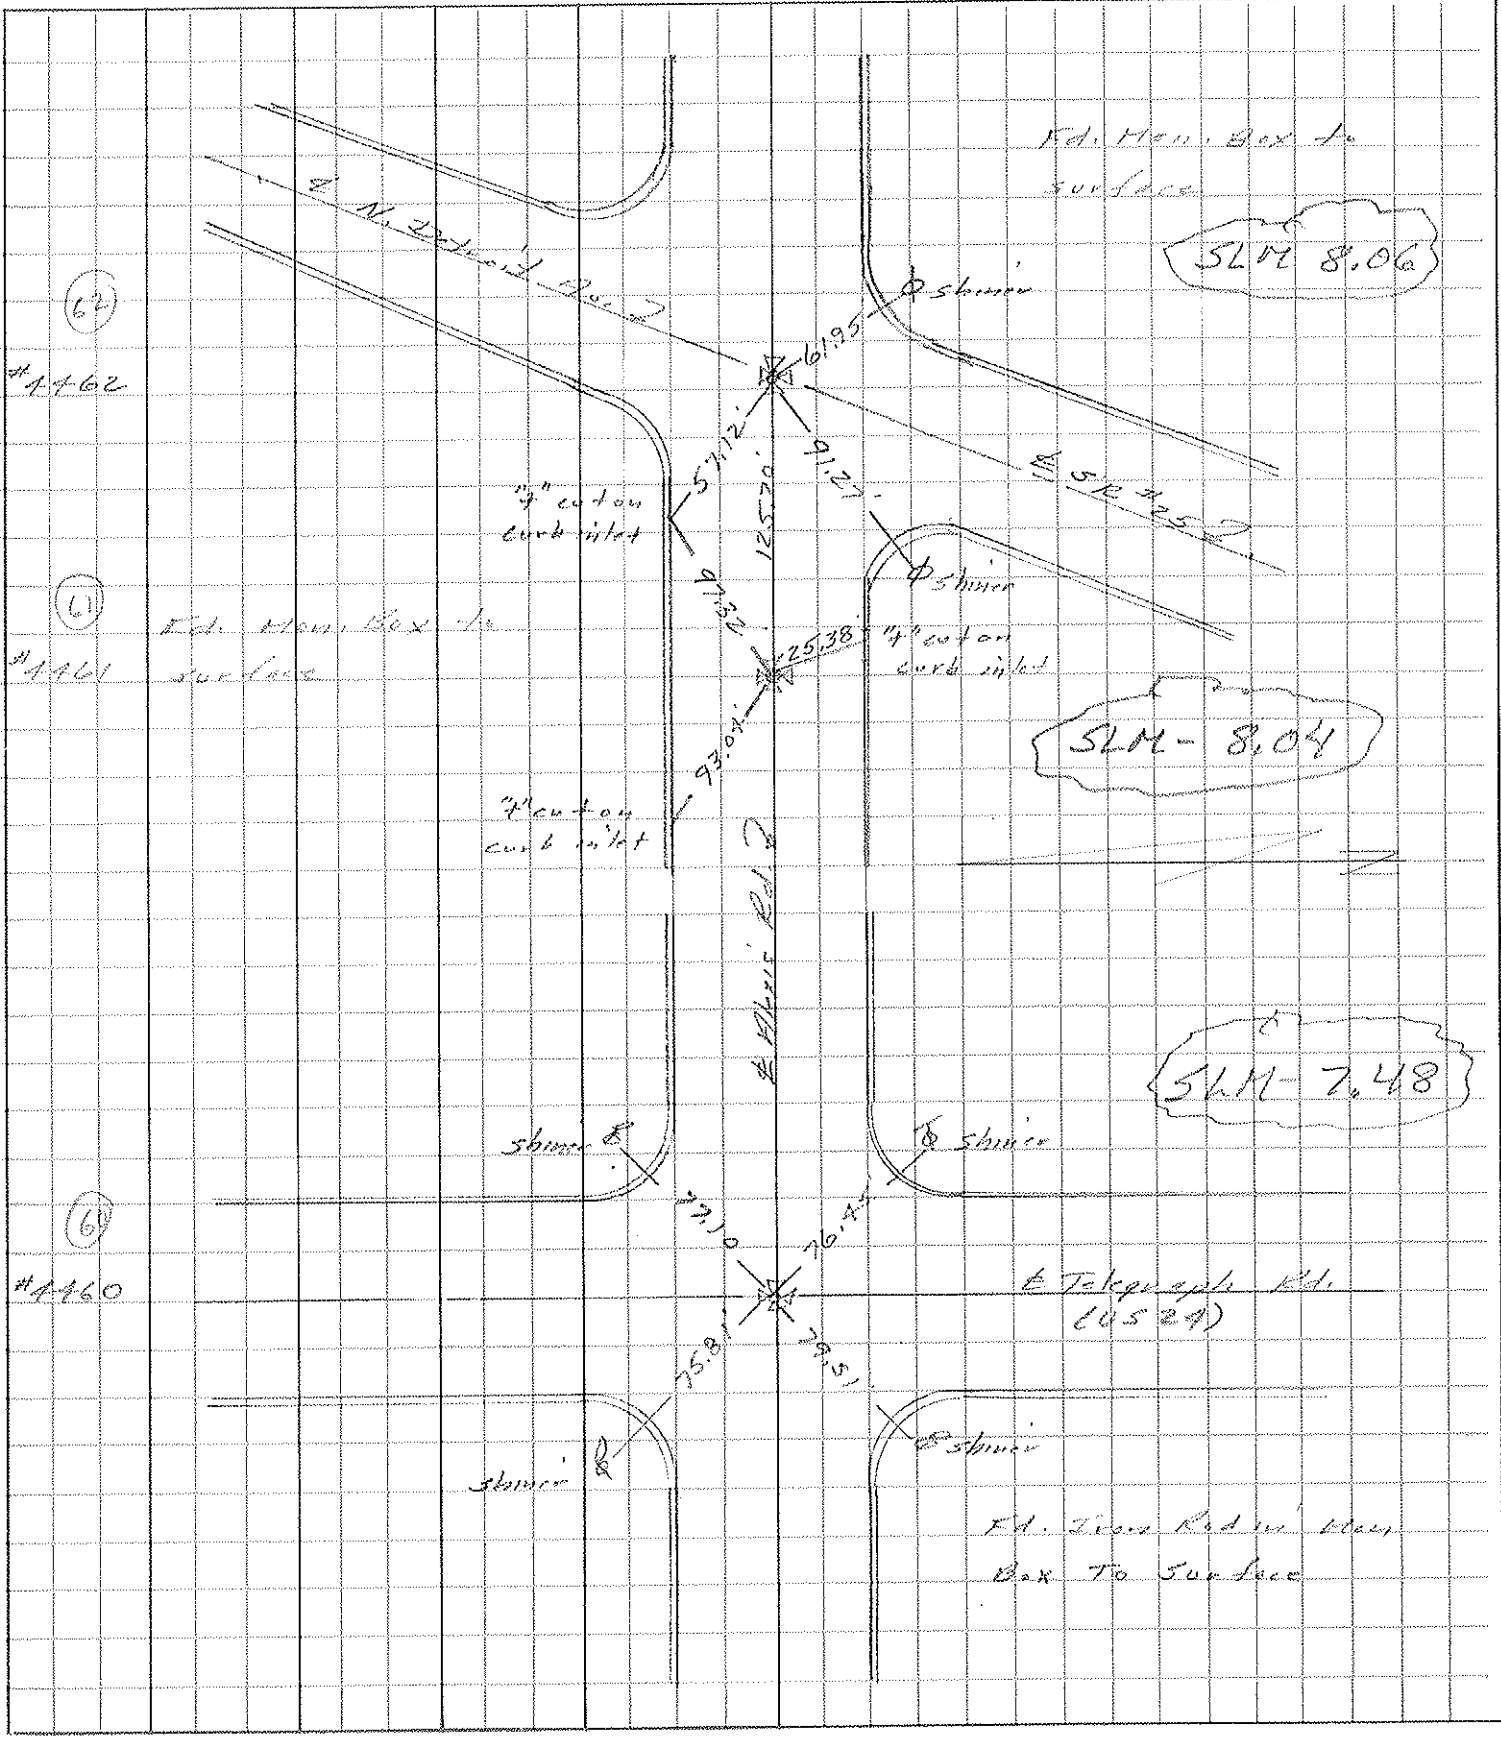

(62)  
#4462

(61)  
#4461

(6)  
#4460

SLM-8.06

SLM-8.04

SLM-7.48

E Telegraph Rd. (0524)

E Lucas Rd. in Mass. Box To Surface