

O.D.O.T. DISTRICT 2 SURVEY OFFICE (USE ONLY)

PERSONNEL

REFERENCE NO. 62

SHEET 45 OF 58

NOTES STONE DATE 9/2/76

ROUTE SR 184

H.C. MICHALAK WEATHER FAIR

COUNTY LUCAS

R.C. NEUSER TEMP. 66°
CURTIS/GRANATA

TOWNSHIP CITY OF TOLEDO

DWG BY NIESE PID _____

SECTION 12

TYPE MONUMENT MONBOX

ON SURFACE - ~~BELOW~~ ON _____


OFFSET ☉ PAVEMENT ON _____ LT : RT

_____ TO _____ EDGE PAVEMENT


STATION: 425+57

HORIZ.DATUM: _____ GEOID: _____

GRID: NORTHING: _____ EASTING: _____

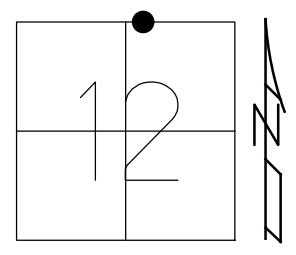

RECORD:
FD MONBOX
9/2/76, STONE

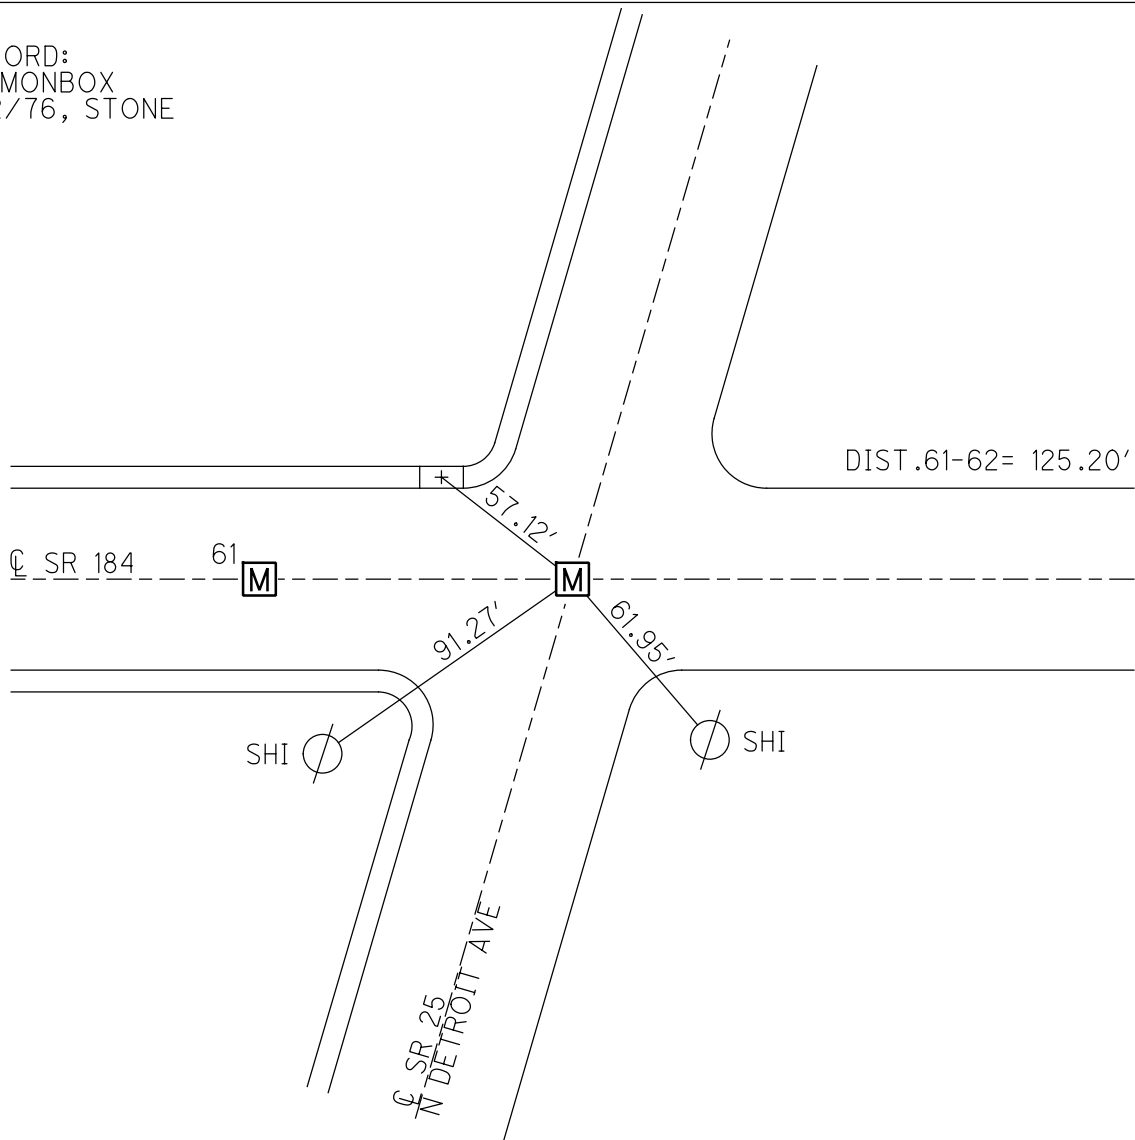

PERSONNEL	TITLE	PERSONNEL	TITLE	COUNTY	DATE	WEATHER	TEMP.
Slava		Hanson		Lucas	2 Sept. 76	Fair	67°
Michaelak				S. R. 184			
Curtis				SEC. Alexis Rd.			
Granola							

DESCRIPTION: References to Central Points JOB NO. _____

LEFT CENTER LINE RIGHT

