

O.D.O.T. DISTRICT 2 SURVEY OFFICE (USE ONLY)

PERSONNEL

REFERENCE NO. 63

SHEET 46 OF 58

NOTES STONE DATE 9/3/76  
H.C. NEUSER WEATHER FAIR  
R.C. GRANATA TEMP. 60°

ROUTE SR 184  
COUNTY LUCAS  
TOWNSHIP CITY OF TOLEDO  
SECTION 12  
T 9 S R 7 E

DWG BY NIESE PID \_\_\_\_\_

TYPE MONUMENT MONBOX

ON SURFACE - ~~BELOW~~ ON


OFFSET ☉ PAVEMENT ON LT : RT

27.7' TO RT EDGE PAVEMENT

STATION: 1056+00


HORZ.DATUM: \_\_\_\_\_ GEOID: \_\_\_\_\_

GRID: NORTHING: \_\_\_\_\_ EASTING: \_\_\_\_\_

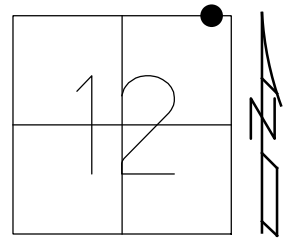

RECORD: P.O.T.  
FD MONBOX  
9/2/76, STONE

"+" CUTS  
ON CURBS

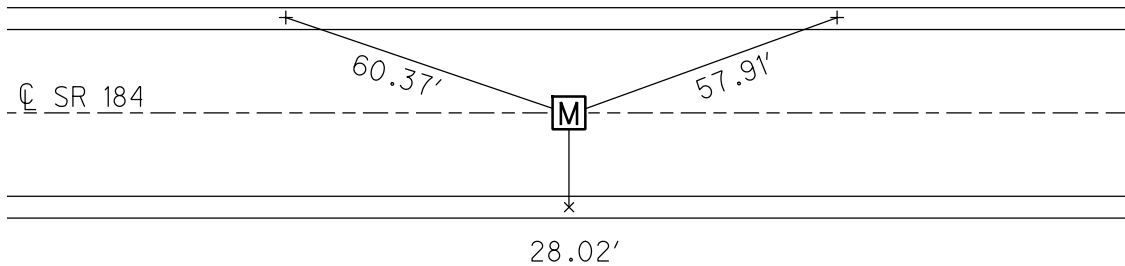

PERSONNEL	TITLE	PERSONNEL	TITLE
Stave			
Keusey			
Curdis			

COUNTY Lucas DATE 3 Sept. 76

S. R. 187 WEATHER Fair

SEC. Alexis Rd. (New) TEMP. 60°

DESCRIPTION References to Control Points JOB NO.

LEFT CENTER LINE RIGHT

