

O.D.O.T. DISTRICT 2 SURVEY OFFICE (USE ONLY)

PERSONNEL

REFERENCE NO. 69

SHEET 52 OF 58

NOTES STONE

DATE 9/3/76

ROUTE SR 184

H.C. NEUSER

WEATHER FAIR

COUNTY LUCAS

R.C. CURTIS

TEMP. 65°

TOWNSHIP CITY OF TOLEDO

DWG BY NIESE PID _____

SECTION 7

T 9 S R 8 E

TYPE MONUMENT UNKNOWN

ON SURFACE - ~~BELOW~~ ON

OFFSET ☉ PAVEMENT ON _____ LT : RT

- TO - EDGE PAVEMENT


STATION: 1096+02.94

HORZ. DATUM: _____


GEOID: _____

GRID: NORTHING: _____

EASTING: _____

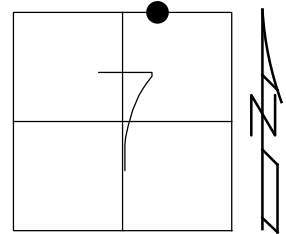

RECORD:
FD
9/3/76, STONE

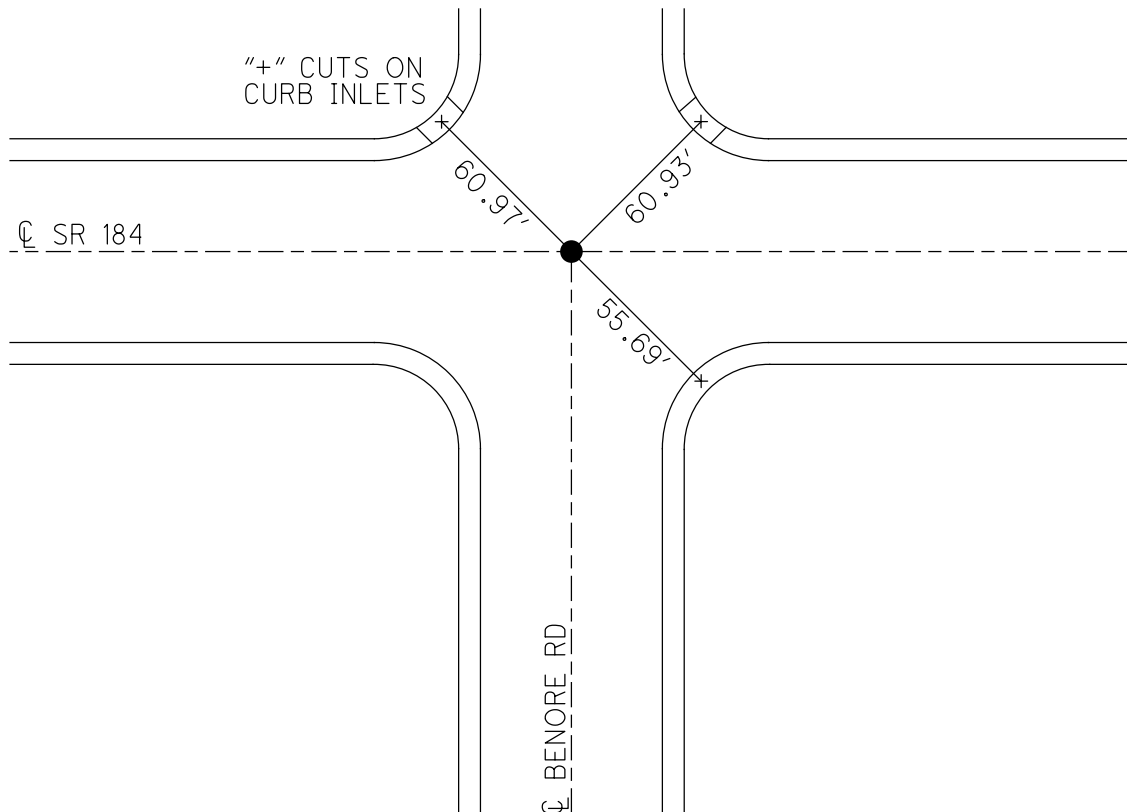

PERSONNEL	TITLE	PERSONNEL	TITLE	COUNTY	Lucas	DATE	3 Sept. 76
Stanc				S. R.	187	WEATHER	Fair
Nease				SEC.	Alexis P.D. (New)	TEMP.	65°
Curtis							

DESCRIPTION References to Control Points JOB NO. _____

