

O.D.O.T. DISTRICT 2 SURVEY OFFICE (USE ONLY)

PERSONNEL

REFERENCE NO. 70

SHEET 53 OF 58

NOTES STONE

DATE 9/3/76

ROUTE SR 184

H.C. NEUSER

WEATHER FAIR

COUNTY LUCAS

R.C. CURTIS

TEMP. 65°

TOWNSHIP CITY OF TOLEDO

DWG BY NIESE PID _____

SECTION 7

T 9 S R 8 E


TYPE MONUMENT MONBOX

ON SURFACE - ~~BELOW~~ ON

OFFSET ☉ PAVEMENT ON _____ LT : RT

- TO - EDGE PAVEMENT

STATION: 1113+67.19

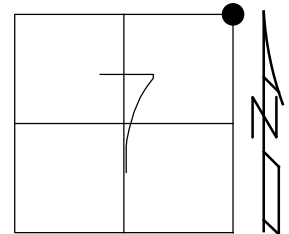


HORIZ.DATUM: _____

GEOID: _____

GRID: NORTHING: _____

EASTING: _____

RECORD:
FD MONBOX
9/3/76, STONE

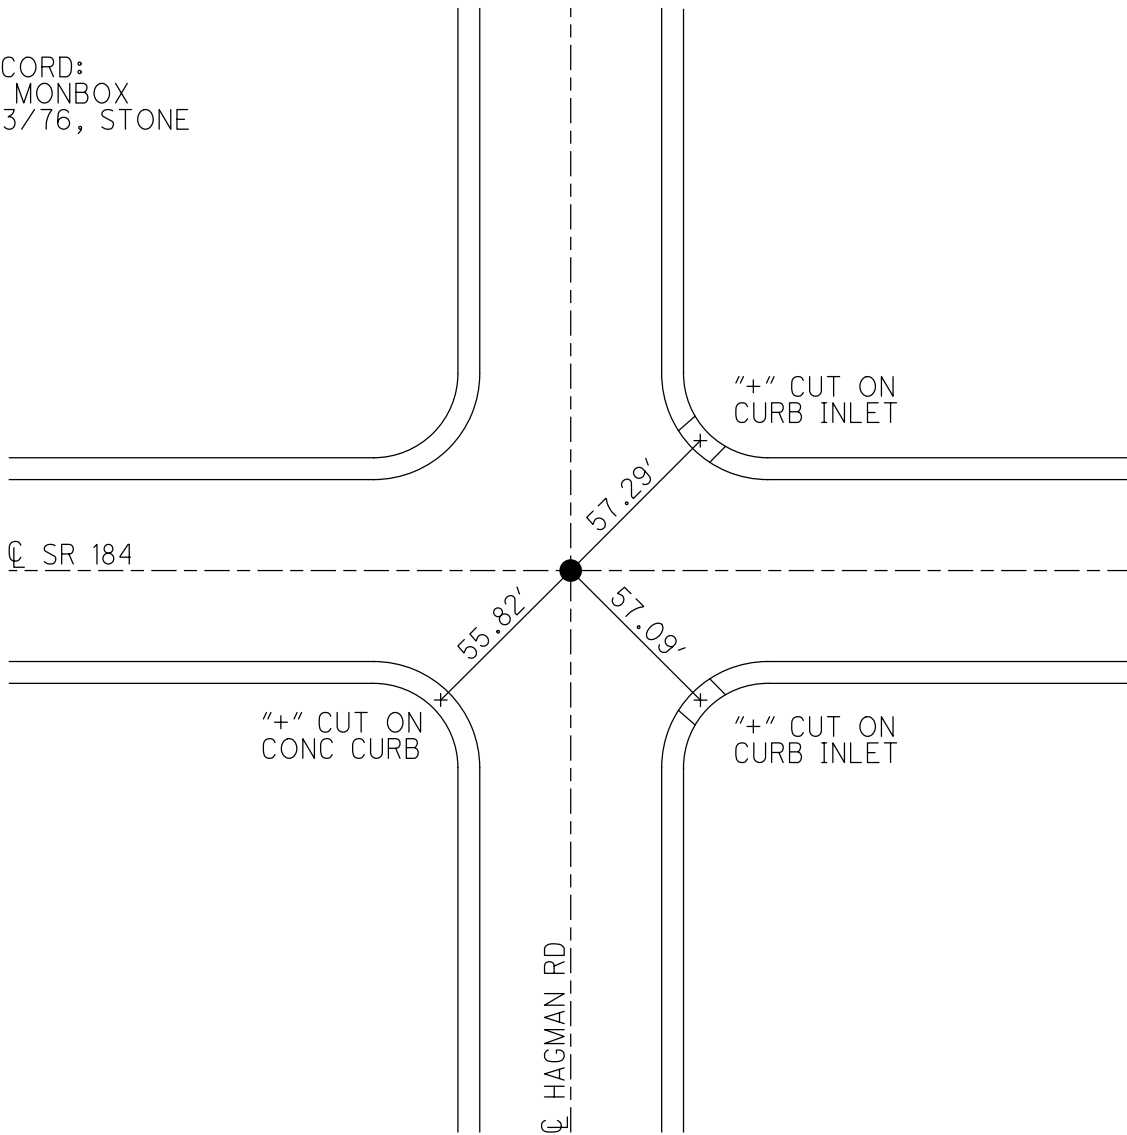

PERSONNEL TITLE PERSONNEL TITLE

COUNTY Lucas DATE 3 Sept. 76

Blanc
Newer
Curtis

S. R. 187 WEATHER Fair

SEC. Alexis Rd. (New) TEMP. 67°

DESCRIPTION

References to Central Points
LEFT CENTER LINE RIGHT

JOB NO.

