

O.D.O.T. DISTRICT 2 SURVEY OFFICE (USE ONLY)

PERSONNEL

REFERENCE NO. 74

SHEET 57 OF 58

NOTES STONE

DATE 9/3/76

ROUTE SR 184

H.C. NEUSER

WEATHER FAIR

COUNTY LUCAS

R.C. CURTIS

TEMP. 65°

TOWNSHIP CITY OF TOLEDO

DWG BY NIESE PID \_\_\_\_\_

SECTION 8

T 9 S R 8 E

TYPE MONUMENT MONBOX

ON SURFACE - ~~BELOW~~ ON

OFFSET ☉ PAVEMENT ON \_\_\_\_\_ LT : RT

- TO - EDGE PAVEMENT


STATION: 1132+90.59

HORZ.DATUM: \_\_\_\_\_


GEOID: \_\_\_\_\_

GRID: NORTHING: \_\_\_\_\_

EASTING: \_\_\_\_\_

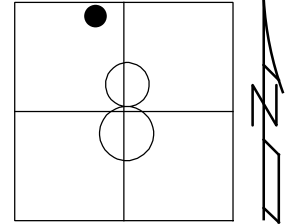

RECORD: P.O.T.  
FD MONBOX  
RAMPS B AND C  
9/3/76, STONE

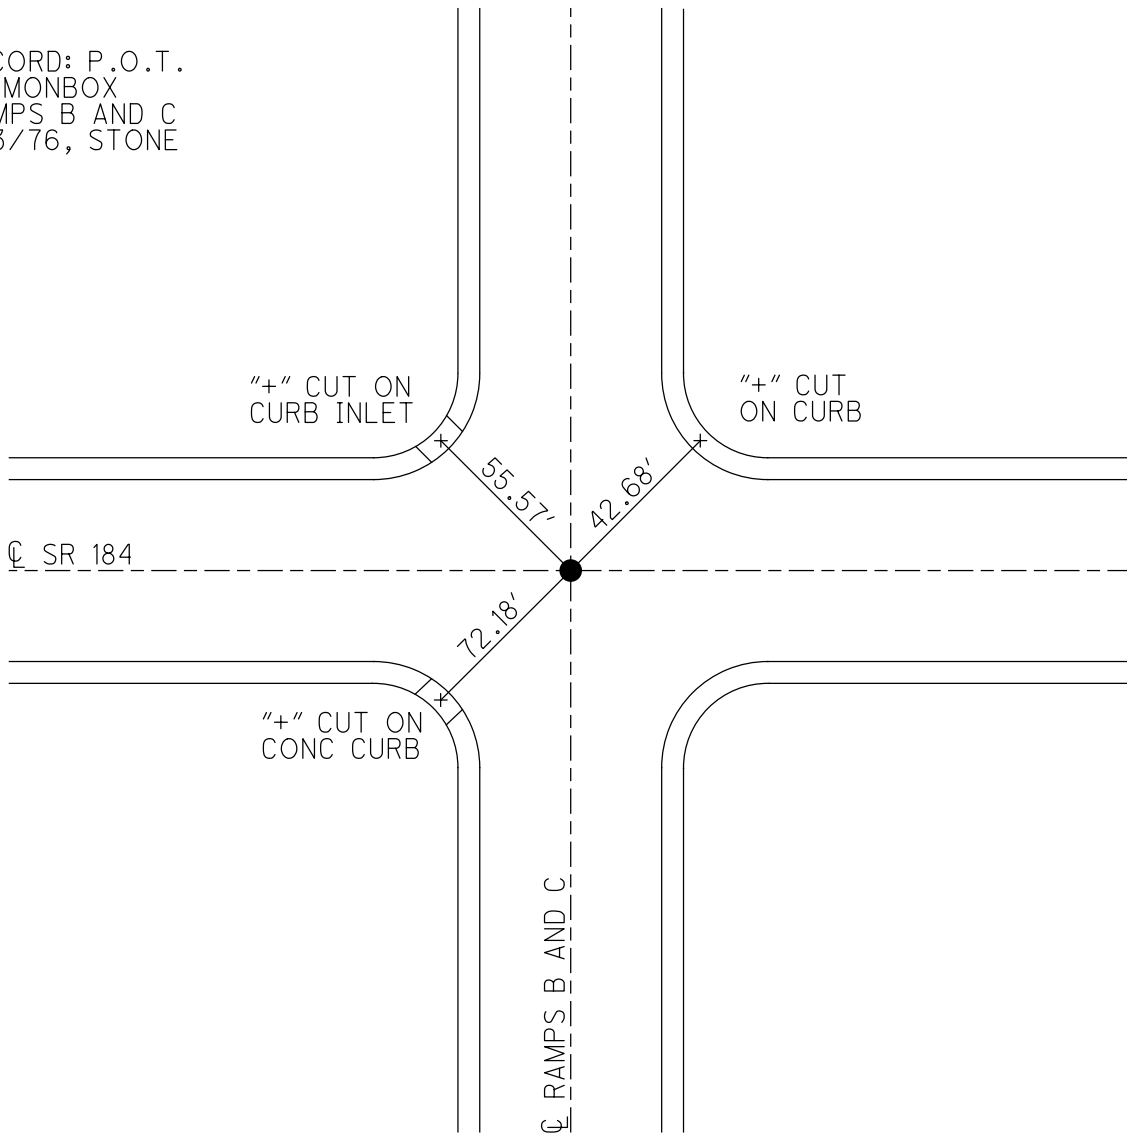

PERSONNEL TITLE PERSONNEL TITLE

COUNTY Lucas DATE 3 Sept. 76

S. R. 189 WEATHER Fair

SEC. Alexis Rd. (Old) TEMP. 72°

DESCRIPTION References to Control Points LEFT CENTER LINE RIGHT JOB NO.

