

O.D.O.T. DISTRICT 2 SURVEY OFFICE (USE ONLY)

PERSONNEL _____ REFERENCE NO. 75 SHEET 58 OF 58

NOTES STONE DATE 9/3/76
 H.C. NEUSER WEATHER FAIR
 R.C. CURTIS TEMP. 65°

ROUTE SR 184
 COUNTY LUCAS
 TOWNSHIP CITY OF TOLEDO
 SECTION 8
 T 9 S R 8 E

DWG BY NIESE PID _____

TYPE MONUMENT UNKNOWN


ON SURFACE - ~~BELOW~~ ON

OFFSET C PAVEMENT ON _____ LT : RT
 - TO - EDGE PAVEMENT


STATION: 1147+88.20

HORZ. DATUM: _____ GEOID: _____

GRID: NORTHING: _____ EASTING: _____

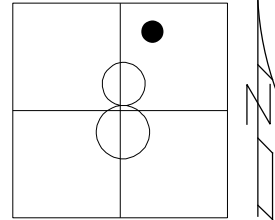

RECORD:
 STA. 1147+88.20
 1969
 FD MONBOX
 9/3/76, STONE

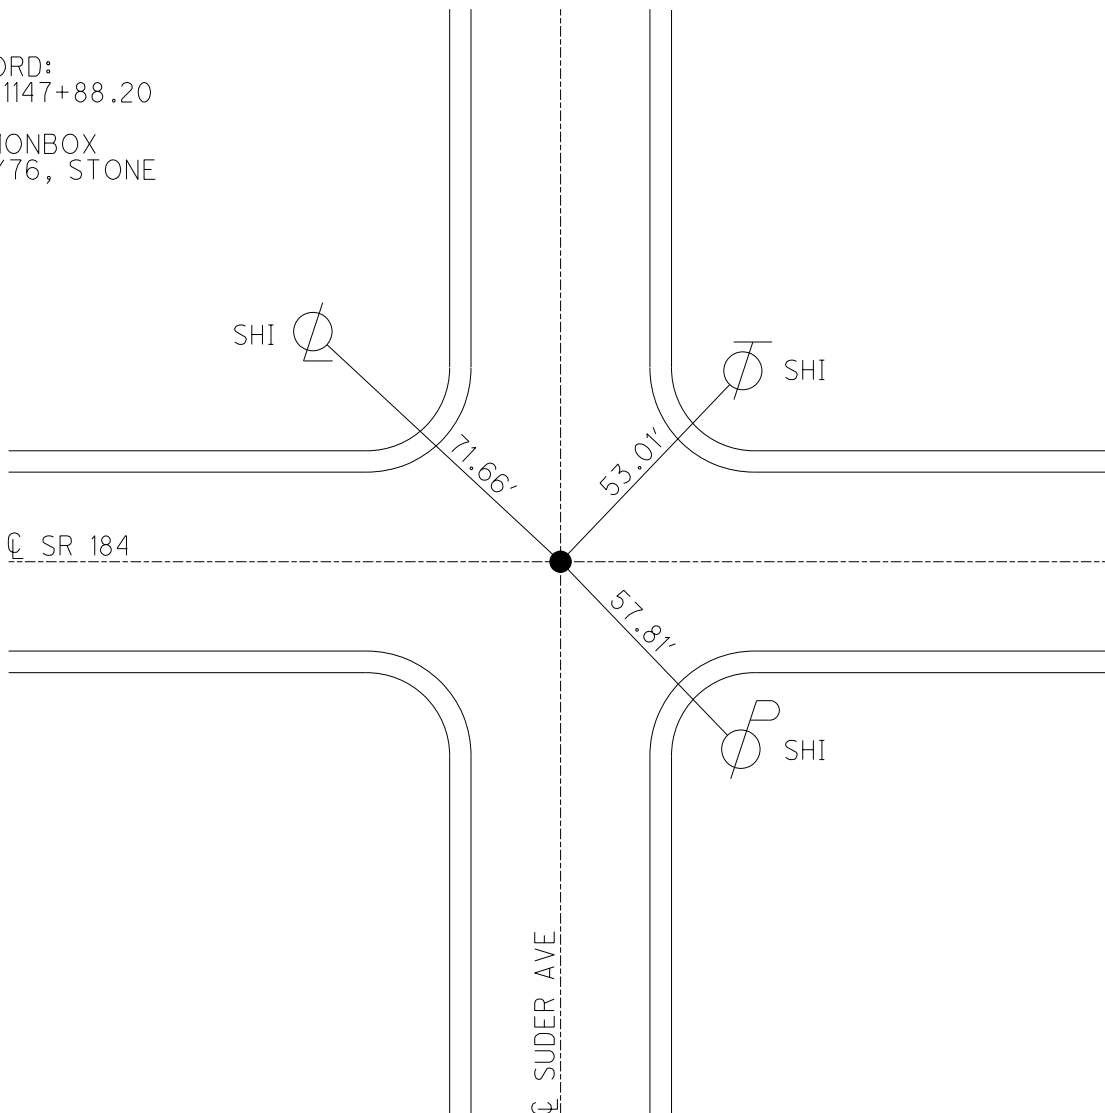

PERSONNEL TITLE PERSONNEL TITLE

COUNTY Lucas DATE 3 Sept. 76

Shaw
Nease
Curtis

S. R. 189 WEATHER Fair

SEC. Alexis Rd. (Old) TEMP. 72°

DESCRIPTION

LEFT

CENTER LINE

RIGHT

JOB NO.

Reference to Central Points

