

O.D.O.T. DISTRICT 2 SURVEY OFFICE (USE ONLY)

PERSONNEL _____ REFERENCE NO. 3 SHEET 3 OF 48

NOTES HOMAN DATE 7/29/16 ROUTE US 20A
 H.C. HOMAN WEATHER CLOUDY COUNTY LUCAS
 R.C. KEFFER TEMP. 75°F TOWNSHIP SWANTON
 _____ SECTION 7
 _____ T 7 N R 5 E

TYPE MONUMENT MOBORA MON


~~ON SURFACE~~ - BELOW 3"

LEFT - ☉ PAV'T - RIGHT ON


27.2' TO RT EDGE PAVEMENT

S.L.M. 52+26

GRID: NORTHING: 700882.1963 EASTING: 1595450.313

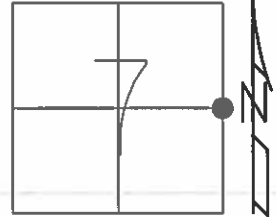


RECORD:
 FD MOBORA MON
 6/15/03, DCH
 SET MAG/WASHER
 1/13/04, DCH
 FD MOBORA MON
 3" DOWN
 GPS, REF3
 7/29/16
 SET MAG/WASHER
 GPS, NEWREF3
 10/05/16

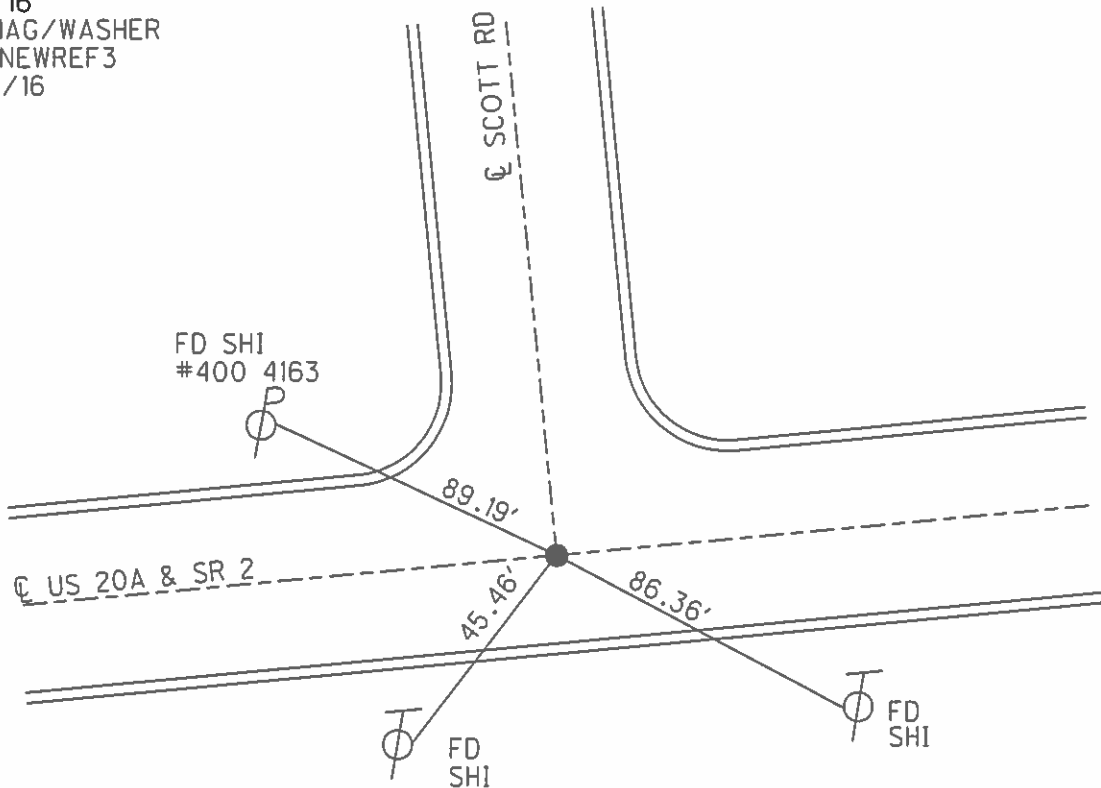


O.D.O.T. DISTRICT 2 SURVEY OFFICE (USE ONLY)

PERSONNEL _____ REFERENCE NO. 3 SHEET 3 OF 31
 NOTES HOMAN DATE 7/29/16 ROUTE SR 2
 H.C. HOMAN WEATHER CLOUDY COUNTY LUCAS
 R.C. RYALL TEMP. 75°F TOWNSHIP SWANTON
 _____ SECTION 7
 _____ T 7 N R 5 E

TYPE MONUMENT MOBORA MON
~~ON SURFACE~~ - BELOW 3"
 LEFT - ☉ PAV'T - RIGHT ON
27.2' TO RT EDGE PAVEMENT
 S.L.M. 52+26
 GRID: NORTHING: 700882.1963 EASTING: 1595450.313

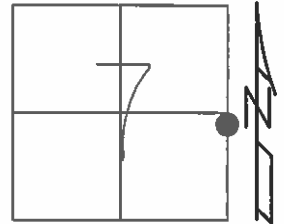


RECORD:
 FD MOBORA MON.
 6/15/03 DCH
 SET MAG/WASH
 1/13/04 DCH
 FD MOBORA MON
 3" DOWN
 GPS, REF3
 7/29/16
 SET MAG/WASHER
 GPS, NEWREF3
 10/05/16

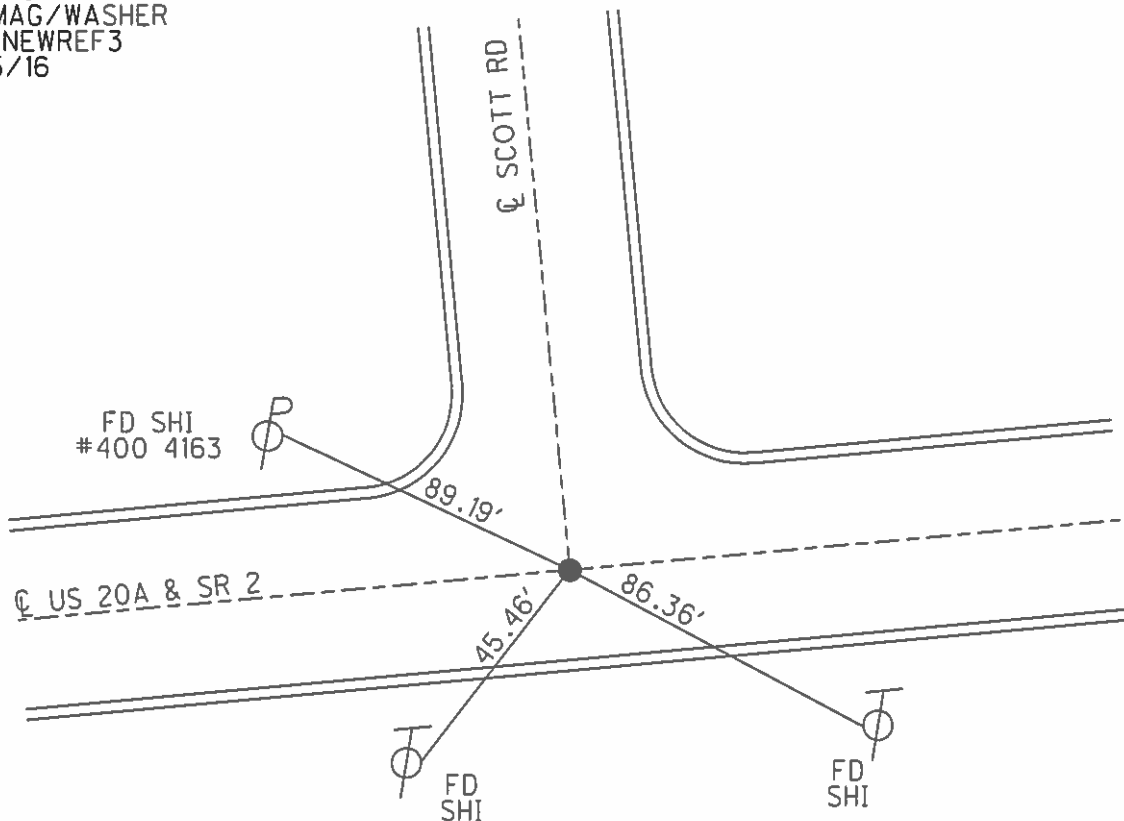

O.D.O.T. DISTRICT 2 SURVEY OFFICE (USE ONLY)

PERSONNEL _____ REFERENCE NO. 3 SHEET 3 OF 11
NOTES HOMAN DATE 7-29-16 ROUTE SR 2
H.C. HOMAN WEATHER CLOUDY COUNTY LUCAS
R.C. RYALL TEMP. 75°F TOWNSHIP SWANTON
SECTION 7
T 7 N R 5 E

TYPE MONUMENT MOBORA MON
~~ON SURFACE~~ - BELOW 3"
LEFT - ☉ PAV'T - RIGHT ON
27.2' TO RT EDGE PAVEMENT
S.L.M. 52+26

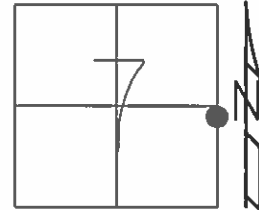


Grid: Northing: 700882.1963 Easting: 1595450.313

RECORD:
FD. MOBORA MON.
6-15-03 DCH

SET MAG/WASH
1-13-04 DCH

FD MOBORA MON
3" DOWN
GPS, REF3
7-29-16

SET MAG/WASHER
GPS, NEWREF3
10-05-16

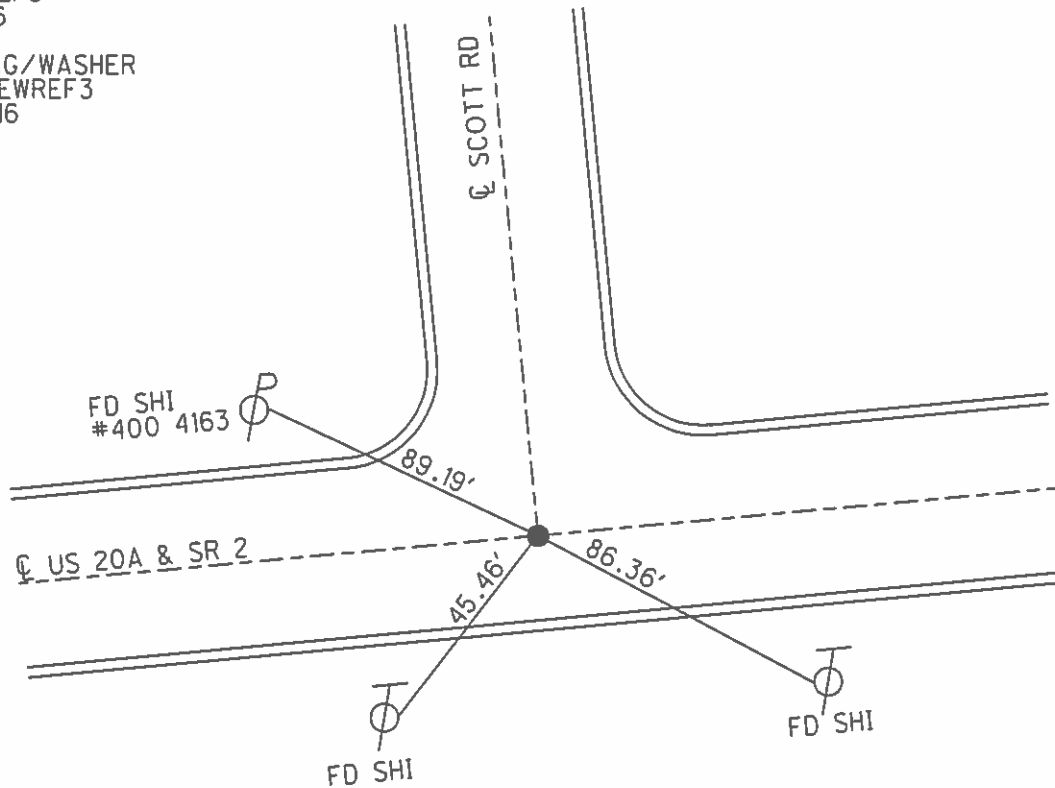

County LUCAS S.R. U.S. 20-A

Date 9-25-80

Township SWANTON

Weather PT. CLOUDY

Section 7


Temp. +68°

T1N, R5E

Personnel SMITH

BOWERS


MEAD

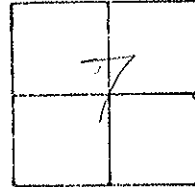

0.98

#3

FO. MOBORA MON.
TO SURFACE
27.2' TO S. EDGE
PAVE.

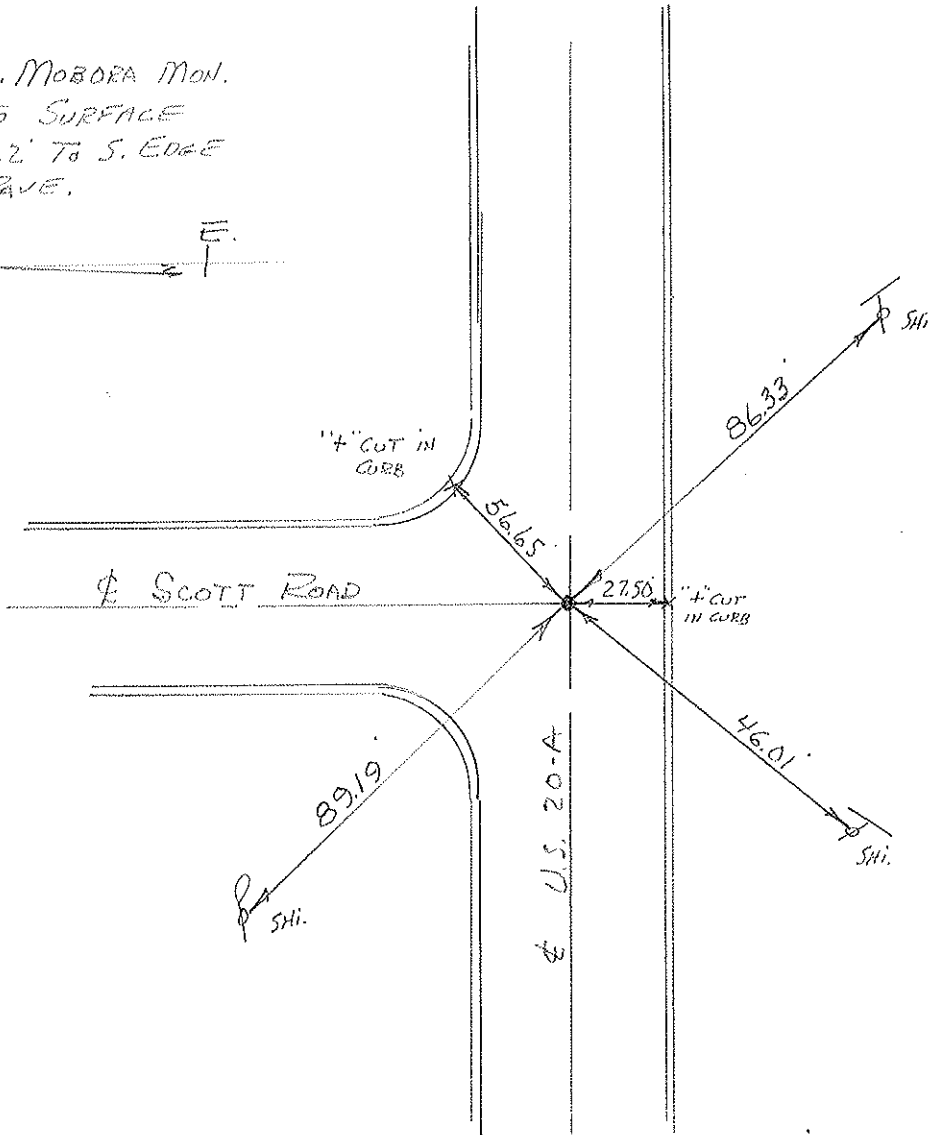

PERSONNEL	TITLE	PERSONNEL	TITLE
Stone			
Crew			


COUNTY Lucas DATE 5 Nov. 64

S. R. # 2 - 20A WEATHER Mild

SEC. _____ TEMP. 50°

DESCRIPTION Shorts JOB NO. _____

LEFT CENTER LINE RIGHT

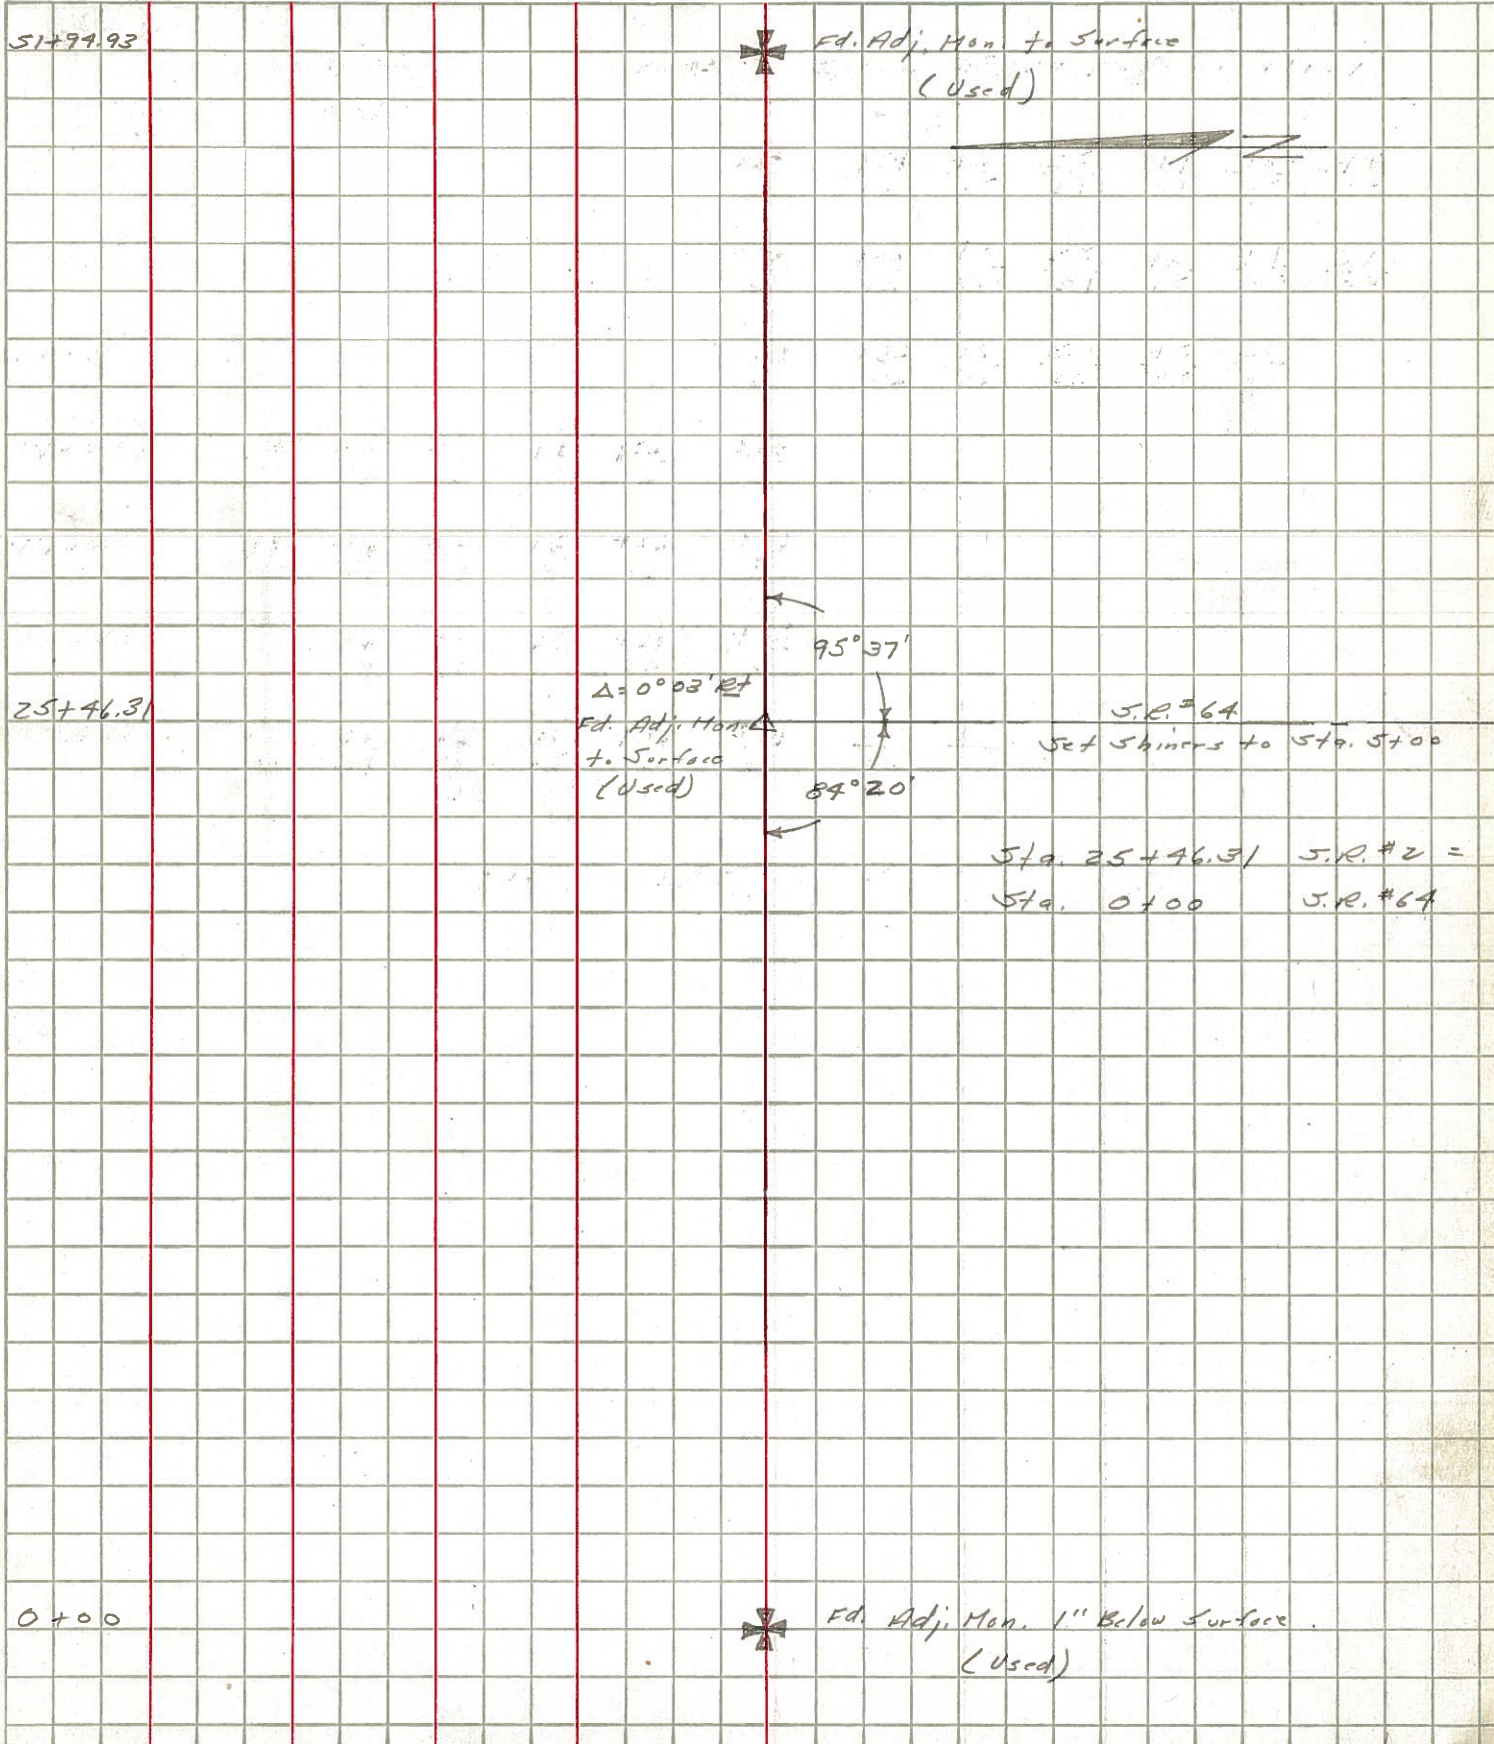

PERSONNEL TITLE PERSONNEL TITLE

COUNTY Lucas DATE 5 Nov. 64

Stang
E
Crow

S. R. #2-20A WEATHER Mild

SEC. TEMP. 60°

DESCRIPTION References to Control Pts. JOB NO.

LEFT CENTER LINE RIGHT

04+00 =	E Hallet Rd. Fd. Adj. Mon. 1" Below Surface	✓	27.73'	S.S.W. to Shiner in ♂
			38.24'	N.W. to Shiner in ♂
			95.45'	N.E. to S.W. Cor. Mocombo
25+46.31 =	E S.R. #64 Fd. Adj. Mon. at Surface	✓	70.55'	S.E. to N.W. Cor. Bldg.
			38.58'	N.W. to Shiner in ♂
			40.42'	N.E. to Shiner in ♂
			78.33'	S.S.W. to Shiner in ♂
54+94.93 =	E Scott Rd. Fd. Adj. Mon. at Surface	✓	194.10'	S. to Brass Cop in Con. Mon.
			72.42'	S.E. to N.W. Cor. House
			59.16'	S.W. to Shiner in 28" Tree
			72.16'	N.E. to S.W. Cor. Porch
			38.42'	N.W. to Shiner in ♂
78+32.31 =	E Girdham Fd. Adj. Mon. at Surface		54.68'	N.N.E. to S.W. Cor. Bldg, 1st. Block
			94.24'	S.S.E. to Shiner in ♂
			104.66'	S.W. to N.E. Cor. Con. Wall
			66.52'	S.E. to N.W. Cor. Bldg. at sidewalk
100+10.86 =	P.I. Δ = 4952' Lt. Fd. Adj. Mon. at Surface	✓	82.98'	N.E. to Shiner in ♂
			31.40'	N.N.W. to Shiner in 32" Tree
			76.44'	S.W. to Shiner in 11" Tree
			29.16'	S.S.E. to Shiner in ♂
104+87.00 =	E Wilkens Rd. M. Fd. 1 1/2" I. Pin at Surface		56.15'	N.E. to Shiner in ♂
			49.95'	S.E. to Shiner in ♂
			37.76'	S.W. to Ref. Mon.
			80.88'	W.S.W. to Shiner in ♂
118+04.01 =	E Wilkens Rd. S. Fd. R.R. Spt. to Surface	✓	65.30'	N.E. to Shiner in 18" Tree
			33.44'	N.N.W. to Shiner in ♂
			86.16'	S.S.W. to Shiner in ♂